



PLAT OF SURVEY OF LOT 1, BLOCK 38
DAVIS ADDITION TO THE CITY OF
ELKHORN, WALWORTH CO., WISCONSIN

I CERTIFY THAT I HAVE SURVEYED THE DESCRIBED PROPERTY AND THAT THE PLAT SHOWN HEREON IS AN ACCURATE SURVEY & A TRUE REPRESENTATION THEREOF CORRECTLY SHOWS THE BOUNDARY LINES OF SAID PROPERTY.

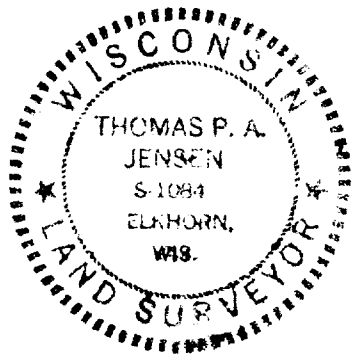

OCT. 30, 1979

Thomas R. Jensen
THOMAS R. JENSEN S-1084
JENSEN SURVEYING & MAPPING
ELKHORN WISCONSIN

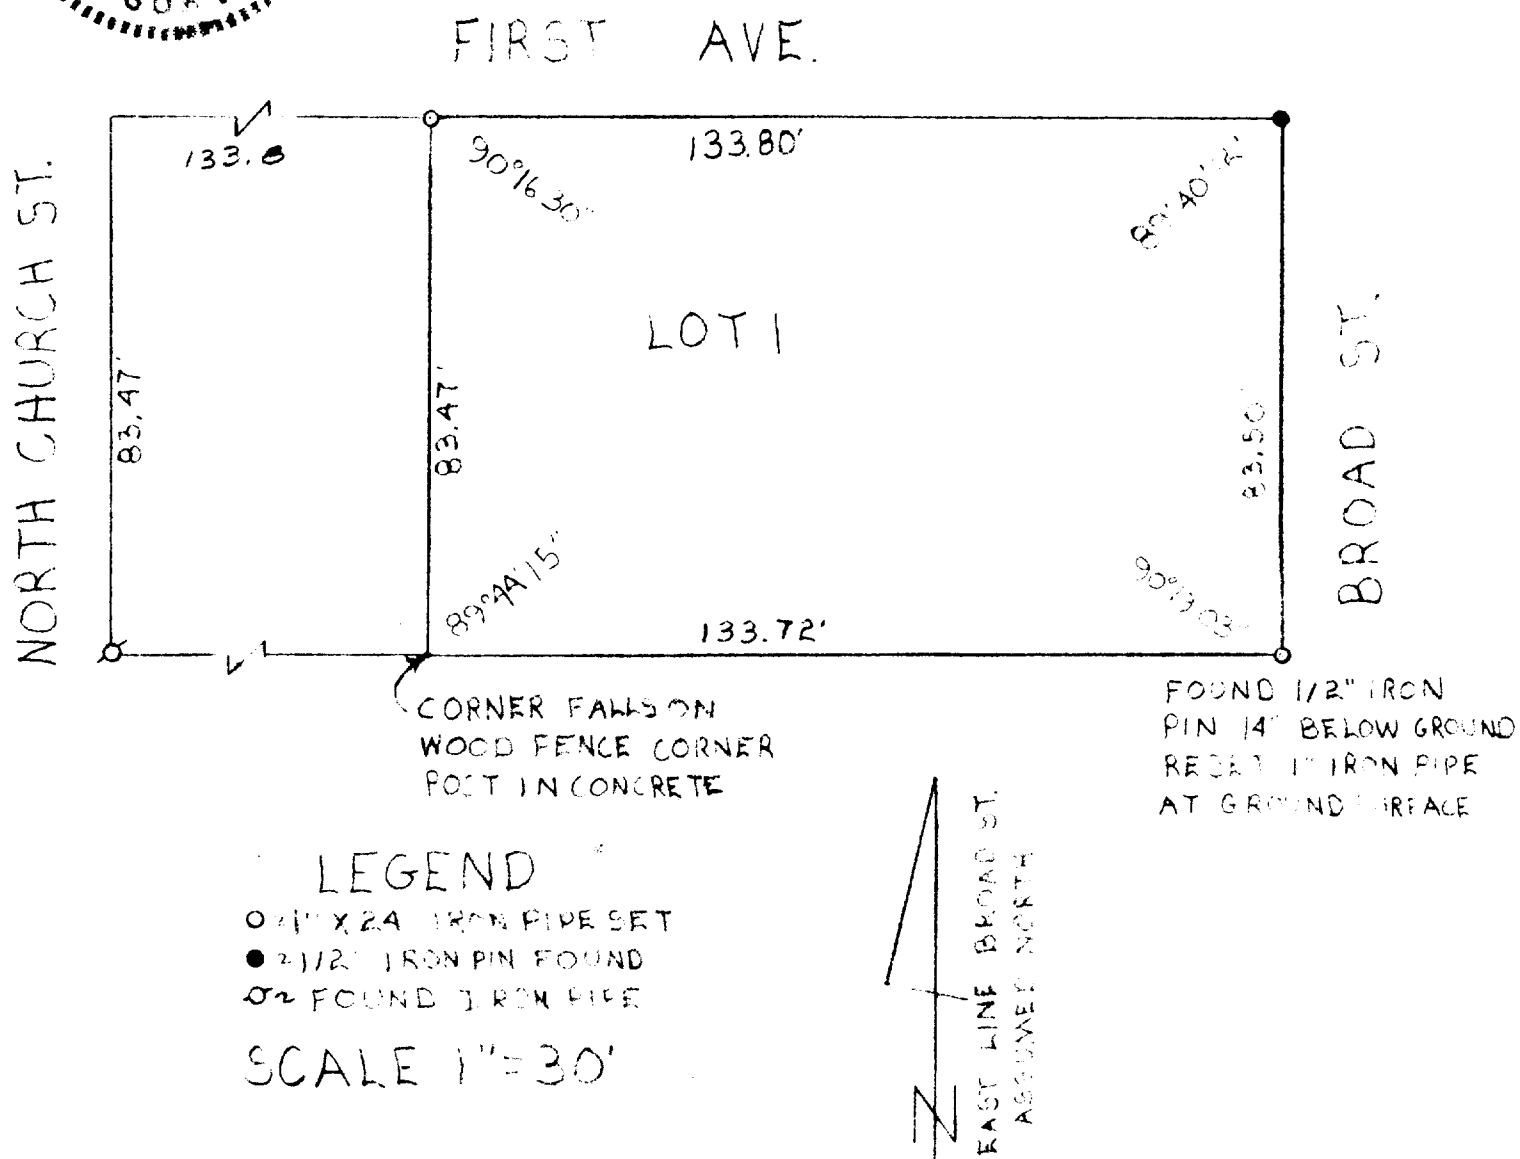

NOTE: MR. TUBBS AS CITY ENGINEER RESURVEYED ELKHORN AND FOUND THE OVERRUN & UNDERRUN IN THE BLOCKS AND RECORDED THE MEASUREMENTS IN THE CITY ENGINEERING RECORDS.

SURVEYED FOR BILL HOFFMAN
328 N BROADEN
ELKHORN, WI

1979.063

4D-12

4-296