



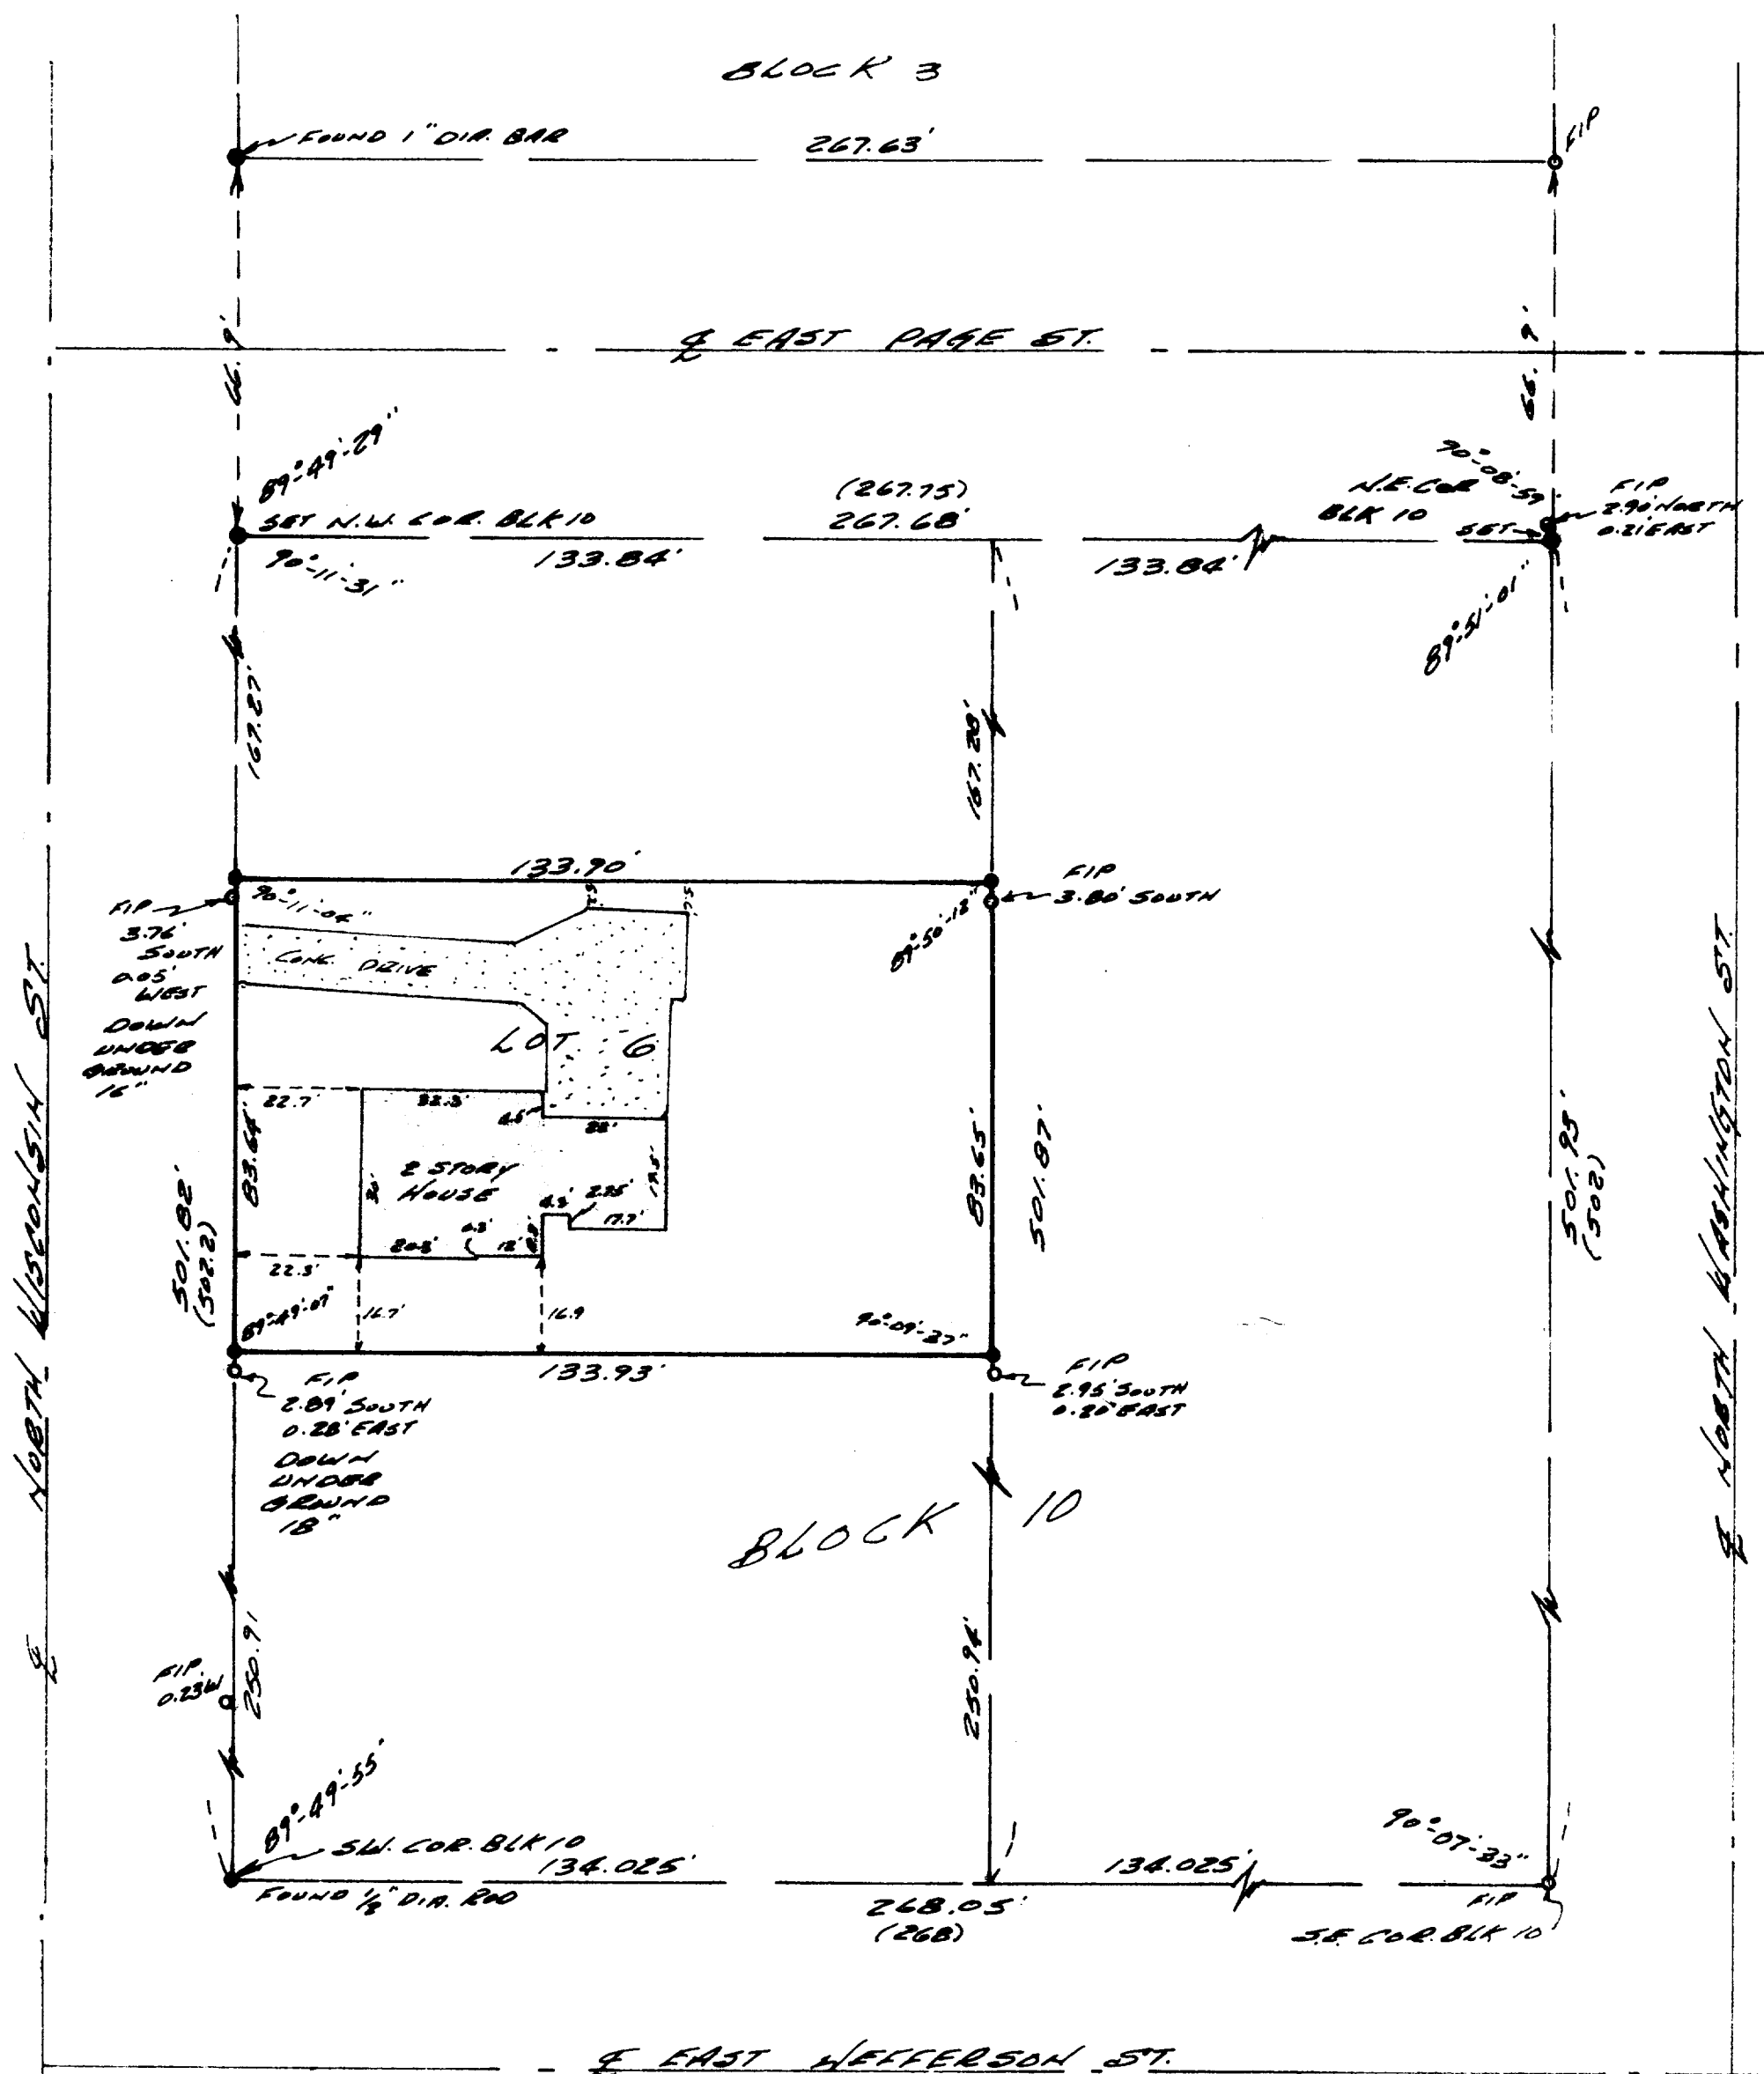

I CERTIFY THAT I HAVE SURVEYED THE
BELOW DESCRIBED PROPERTY AND THAT THE
PLAT SHOWN HEREON IS AN ACCURATE
SURVEY & A TRUE REPRESENTATION
THEREOF & CORRECTLY SHOWS THE
BOUNDARY LINES OF SAID PROPERTY
AND ALL BUILDINGS THEREON.

MAY 9, 1979

JENSEN SURVEYING & MAPPING
ELKHORN, WISCONSIN

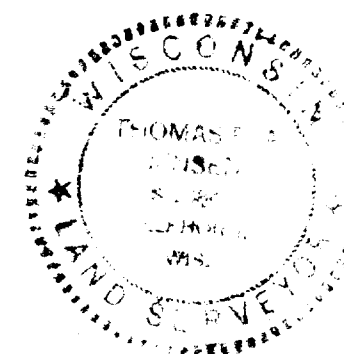

NOTE: ORIGINAL PLAT ON RECORD
SHOWS BLK 10 AS BEING 495'
NORTH & SOUTH AND 264' EAST
AND WEST WITH THE LOTS BEING
138' X 82.5' - MR. TUBBS AS
CITY ENG. RESURVEYED ELKHORN
AND FOUND THE OVERRUN AND
UNDERRUN IN THE BLOCKS AND
RECORDED THE REAS. IN THE
CITY ENG. RECORDS.

- - 1 3/4" D.I.R. IRON BAR SET
- - 3/4" D.I.R. IRON ROD SET
- - 1" D.I.R. IRON PIPE FOUND
- F.I.P. - FOUND IRON PIPE
- () - CITY ENG. RECORDS BY TUBBS

NOTE: LOT 6 BLK 10 D.R. APPEARS TO
HAVE BEEN SURVEYED PREVIOUSLY AND
THE SURVEYOR ADJUSTED THE LOT
USING THE "ON RECORD" DISTANCES
AND PUTTING THE BLK OVER RUN
INTO THE NORTH & LOTS OF THE
BLK. ON REGARDING TUBBS RECORDS
IN THE CITY OFFICE.

SURVEYED FOR: Lyle Schinke, ELKHORN, WIS

PLAT OF SURVEY OF

LOT 6 BLOCK 10 ORIGINAL PLAT TO THE
CITY OF ELKHORN, WAL. CO. WIS.

Thomas P. Jensen
SURVEYOR

SCALE 1" = 30'

DATE MAY 9, 1979