


SCALE-1"=20'

BENCH MARK-TOP OF CURB ON
THE EAST LINE OF EAMES STREET
AND THE SOUTH LINE OF W. JEFFERSON
STREET. ELEV. = 192.95

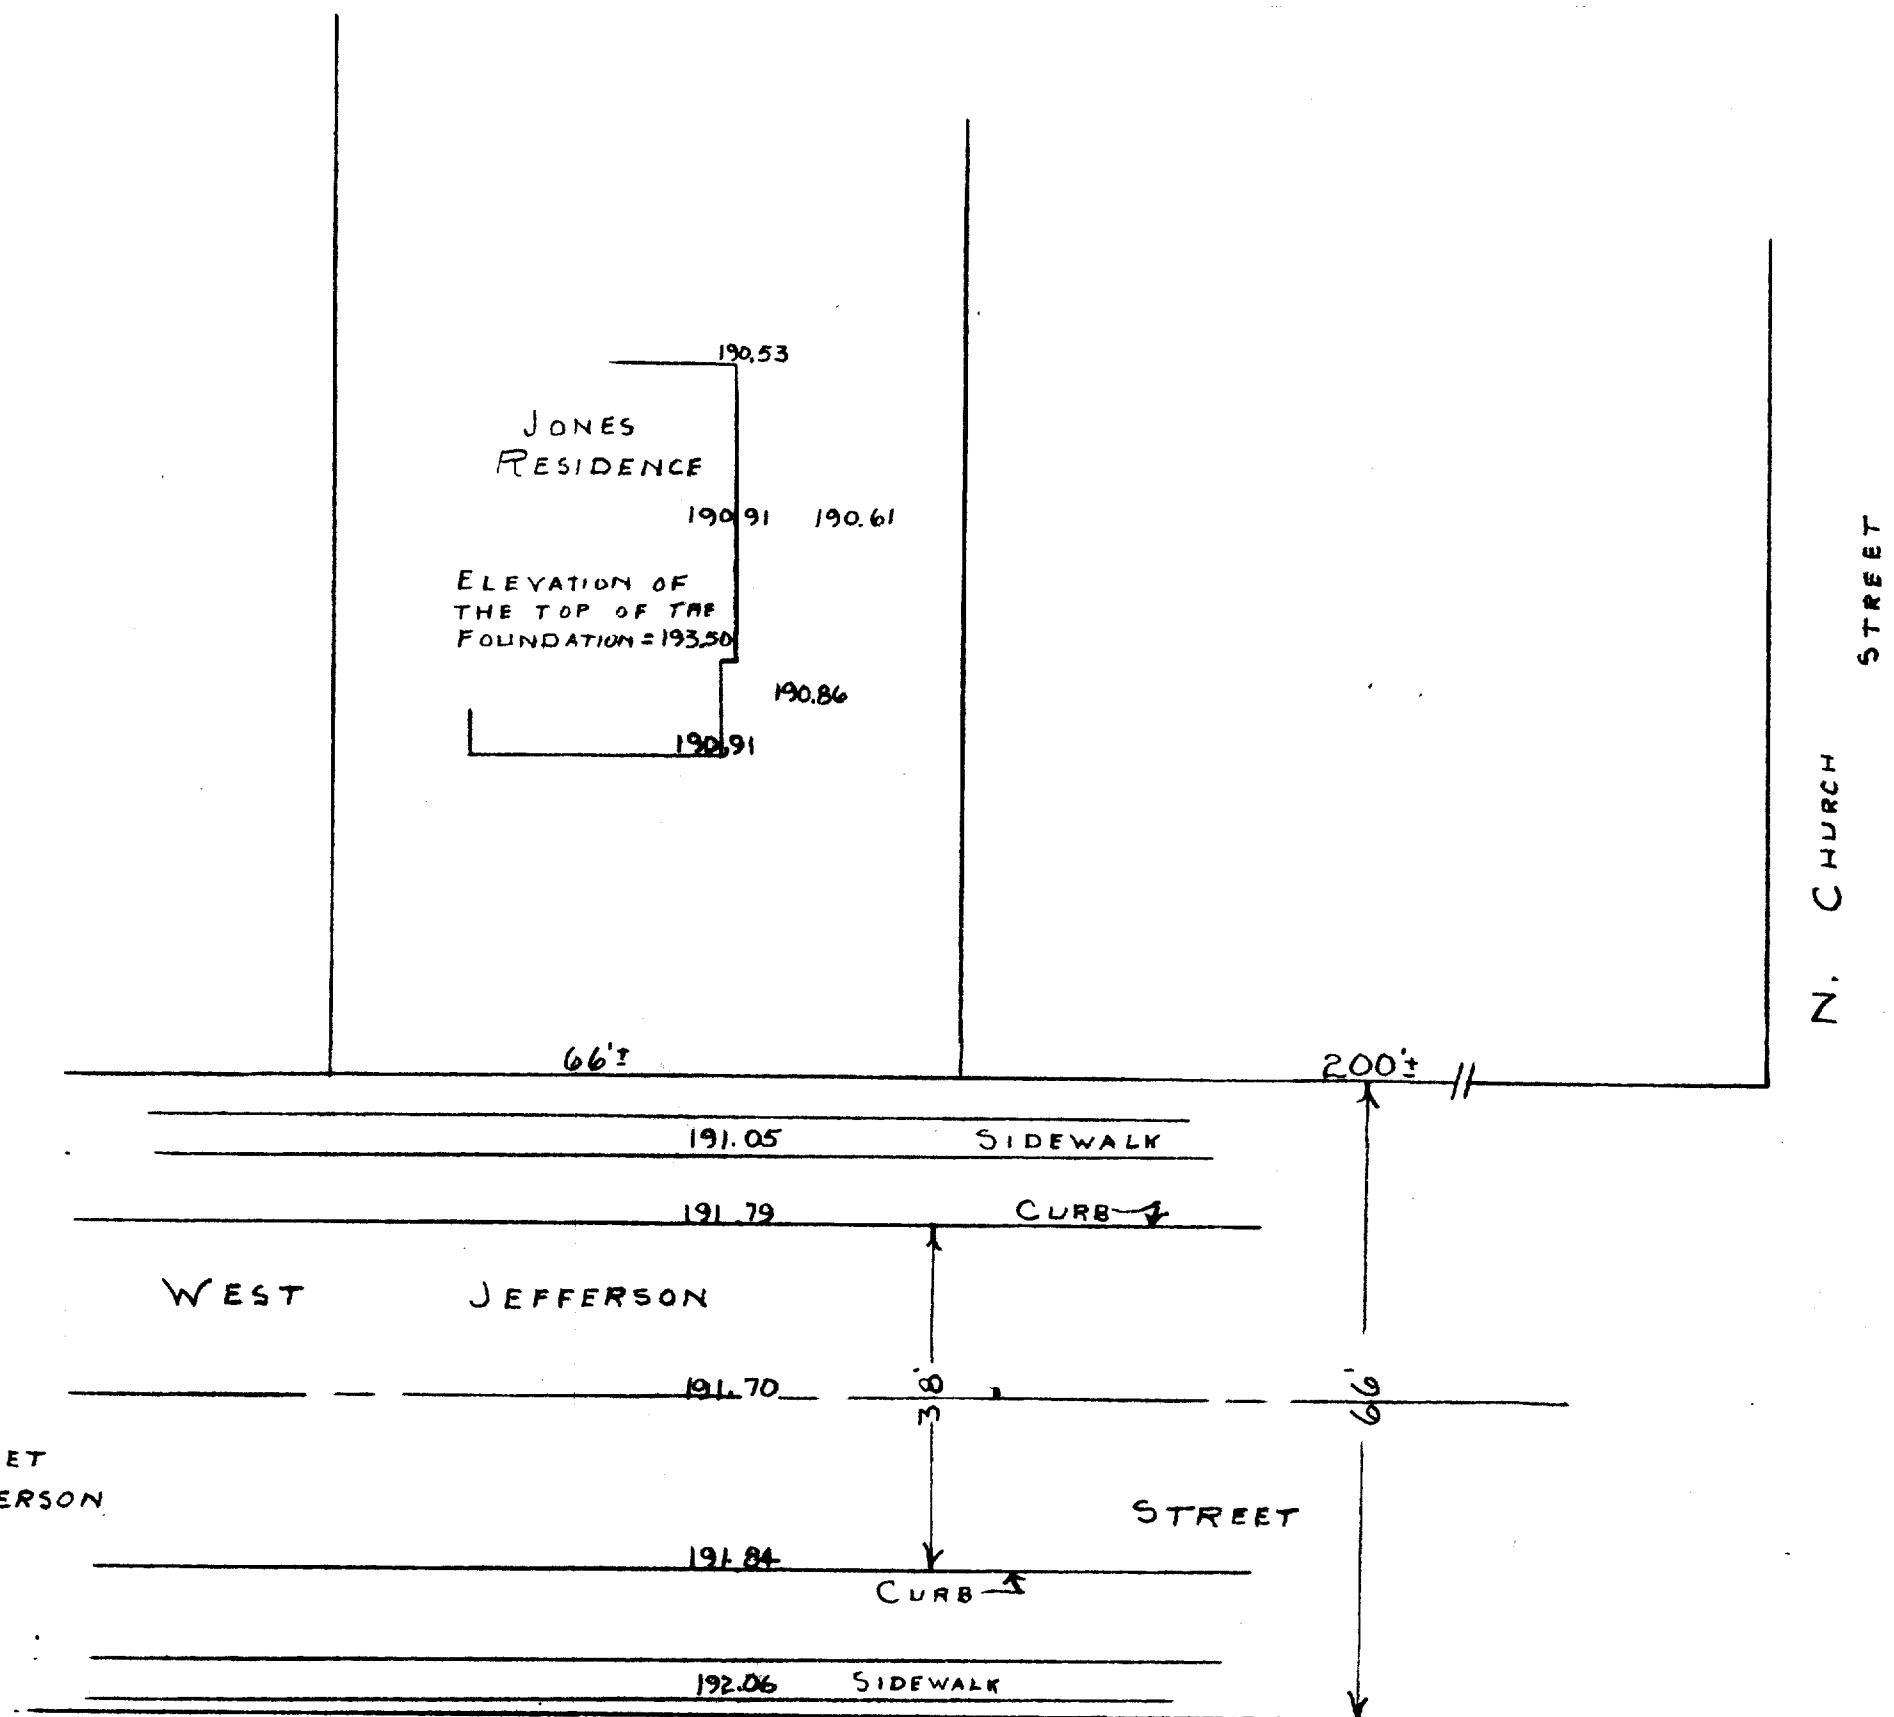

SKETCH SHOWING ELEVATIONS ON THE JONES PROPERTY AND ON
WEST JEFFERSON STREET, CITY OF ELKHORN, WALWORTH
COUNTY, WISCONSIN
OCT. 1954

George T. Dunham
GEORGE T. DUNHAM, SURVEYOR 4-3
DELAWARE, WISCONSIN