


**FARRIS, HANSEN & COOPER, INC.**  
ENGINEERING, SURVEYING AND LAND PLANNING  
715 W. WALWORTH ST. - P.O. BOX 487 - ELKHORN, WI 53121

PLAT OF SURVEY

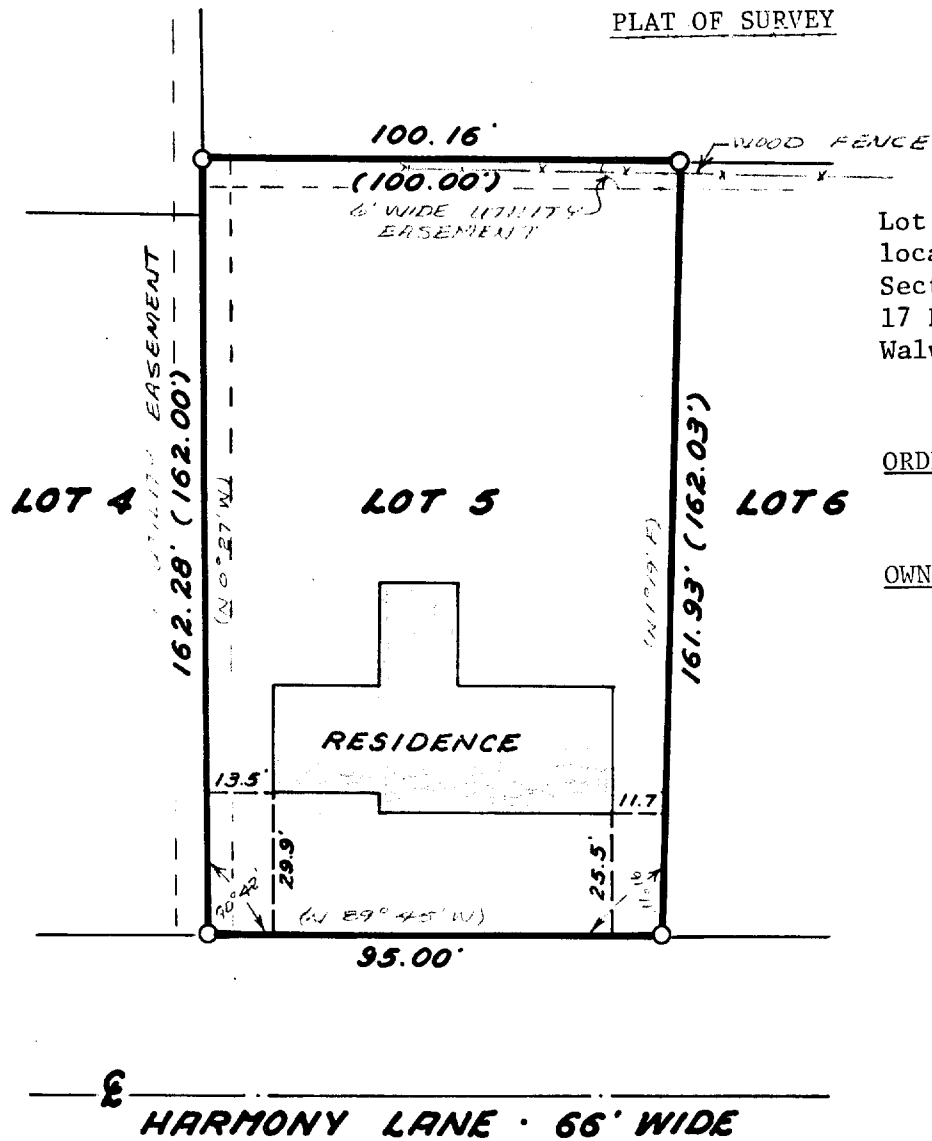

Lot 5, Harmony Acres subdivision,  
located in the Northwest 1/4 of  
Section 6, Town 2 North, Range  
17 East, City of Elkhorn,  
Walworth County, Wisconsin.


ORDERED BY: Larson Realty/  
Mutual Savings

OWNER: Alvin Schroeder

LEGEND

○—Iron Pipe  
Found

( )—Record  
Dimension

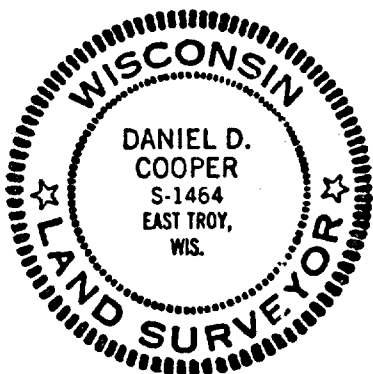

I HEREBY CERTIFY that this map is a true  
representation of the location of the  
structure with respect to the survey monu-  
ments indicated as found to the best of  
my professional knowledge and belief.

*Daniel D. Cooper*  
Daniel D. Cooper, RLS No. 1464

Dated this 26 day of Sept. 1979.

0 10 20 40  
SCALE IN FEET  
1"=40'

PROJ. NO. 1613