

FARRIS, HANSEN & COOPER, INC.

ENGINEERING, SURVEYING AND LAND PLANNING
715 W. WALWORTH ST. - P.O. BOX 487 - ELKHORN, WI 53121


PLAT OF SURVEY OF

LOT 6, BLOCK 3, PRESTON'S ADDITION, SECTION 1,
TOWN 2 NORTH, RANGE 16 EAST, CITY OF
ELKHORN, WALWORTH COUNTY, WIS.

OWNER: Robert E. Liebnow Estate

S. WISCONSIN STREET - 66' WIDE

FOUND IRON PIN
0.15'S. 5 0.07' W. OF
LOT COR.
318.20' to LOT COR.

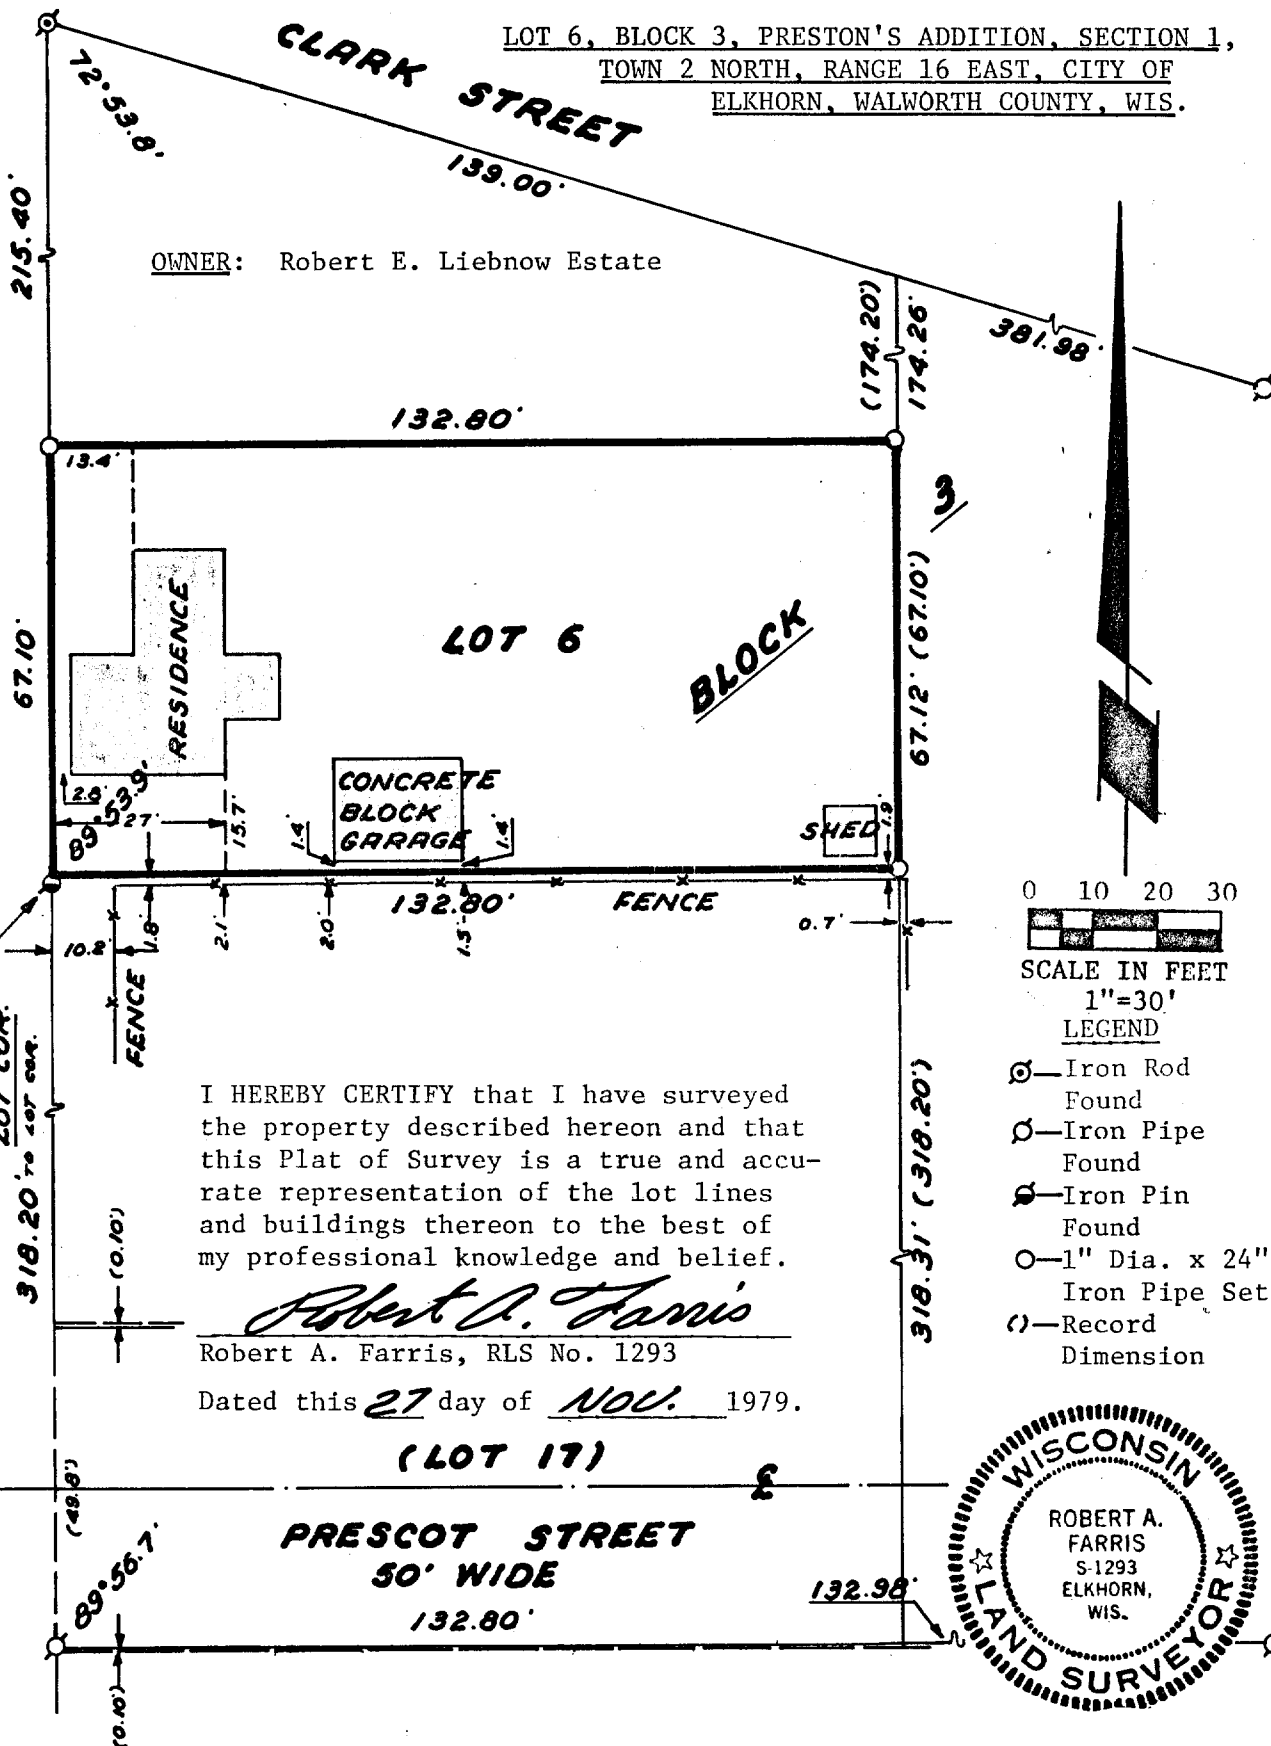

0 10 20 30

SCALE IN FEET

1"=30'

LEGEND

- ⊙—Iron Rod Found
- ⊙—Iron Pipe Found
- ⊙—Iron Pin Found
- 1" Dia. x 24" Iron Pipe Set
- ()—Record Dimension

