

HOME OFFICE
116 E. CHESTNUT STREET
BURLINGTON, WISCONSIN 53105
PHONE: 414-763-2652
414-763-7834

ROBERS & BOYD, INC.
CONSULTING ENGINEERS
LAND SURVEYORS

BRANCH OFFICE
809 - 43RD STREET
KENOSHA, WISCONSIN 53140
PHONE: 414-658-4488



PLAT OF SURVEY AND PROPOSED HOUSE LOCATION
FOR
SOUTHEASTERN WISCONSIN HOUSING CORPORATION
OF

Lot 34 of Landmark Subdivision, Addition #1, City of Elkhorn, Walworth County, Wisconsin.

I certify that the existing foundation is as shown on this "Plat of Survey", and that all ties are as shown. Dated this 16th day of July, 1980.

Kenneth R. Reesman
KENNETH R. REESMAN, WRLS-1351

~ LEGEND ~
• FOUND IRON PIPE
○ SET 1"X24" IRON PIPE
* EXISTING GROUND ELEVATIONS
ADD 1000.00 TO ELEVATIONS FOR
U.S. G.S. DATUM - B.M. S. BOLT
OF HYDRANT @ 36 MARIA DRIVE
EL. 1032.62
SCALE 1" = 30'

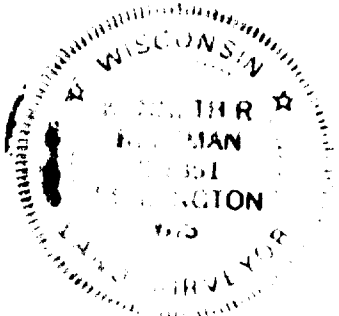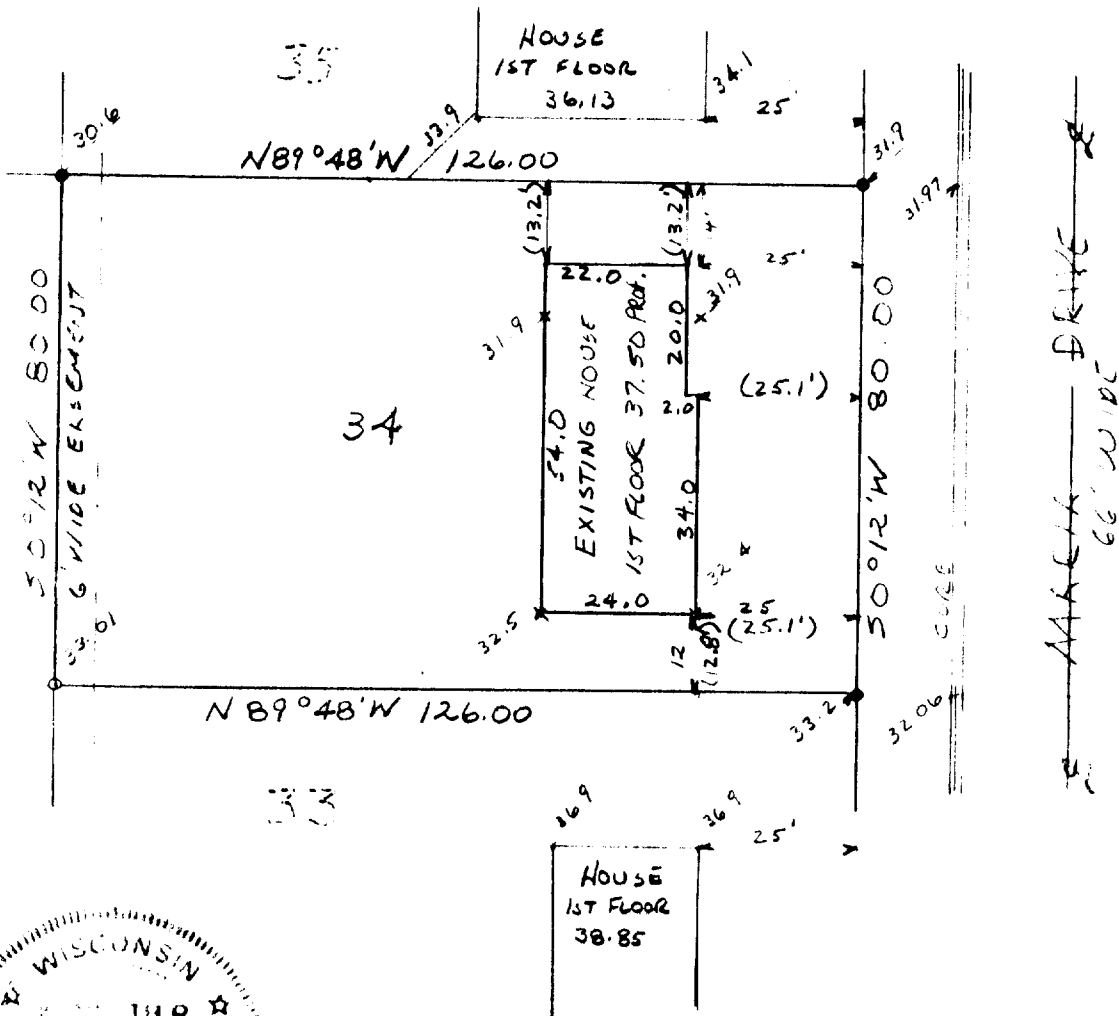

"I CERTIFY THAT I HAVE SURVEYED THE ABOVE DESCRIBED PROPERTY AND THAT THE ABOVE PLAT IS AN ACCURATE SURVEY AND A TRUE REPRESENTATION THEREOF AND CORRECTLY SHOWS THE EXTERIOR BOUNDARY LINES AND LOCATION OF BUILDINGS ON SAID PROPERTY AND THE CORRECT MEASUREMENTS THEREOF."

Kenneth R. Reesman
WISCONSIN REGISTERED LAND SURVEYOR

REVISED 7-16-80, HOUSE RECERTIFICATION

10/17/77
DATE

80093

77240
JOB NUMBER