


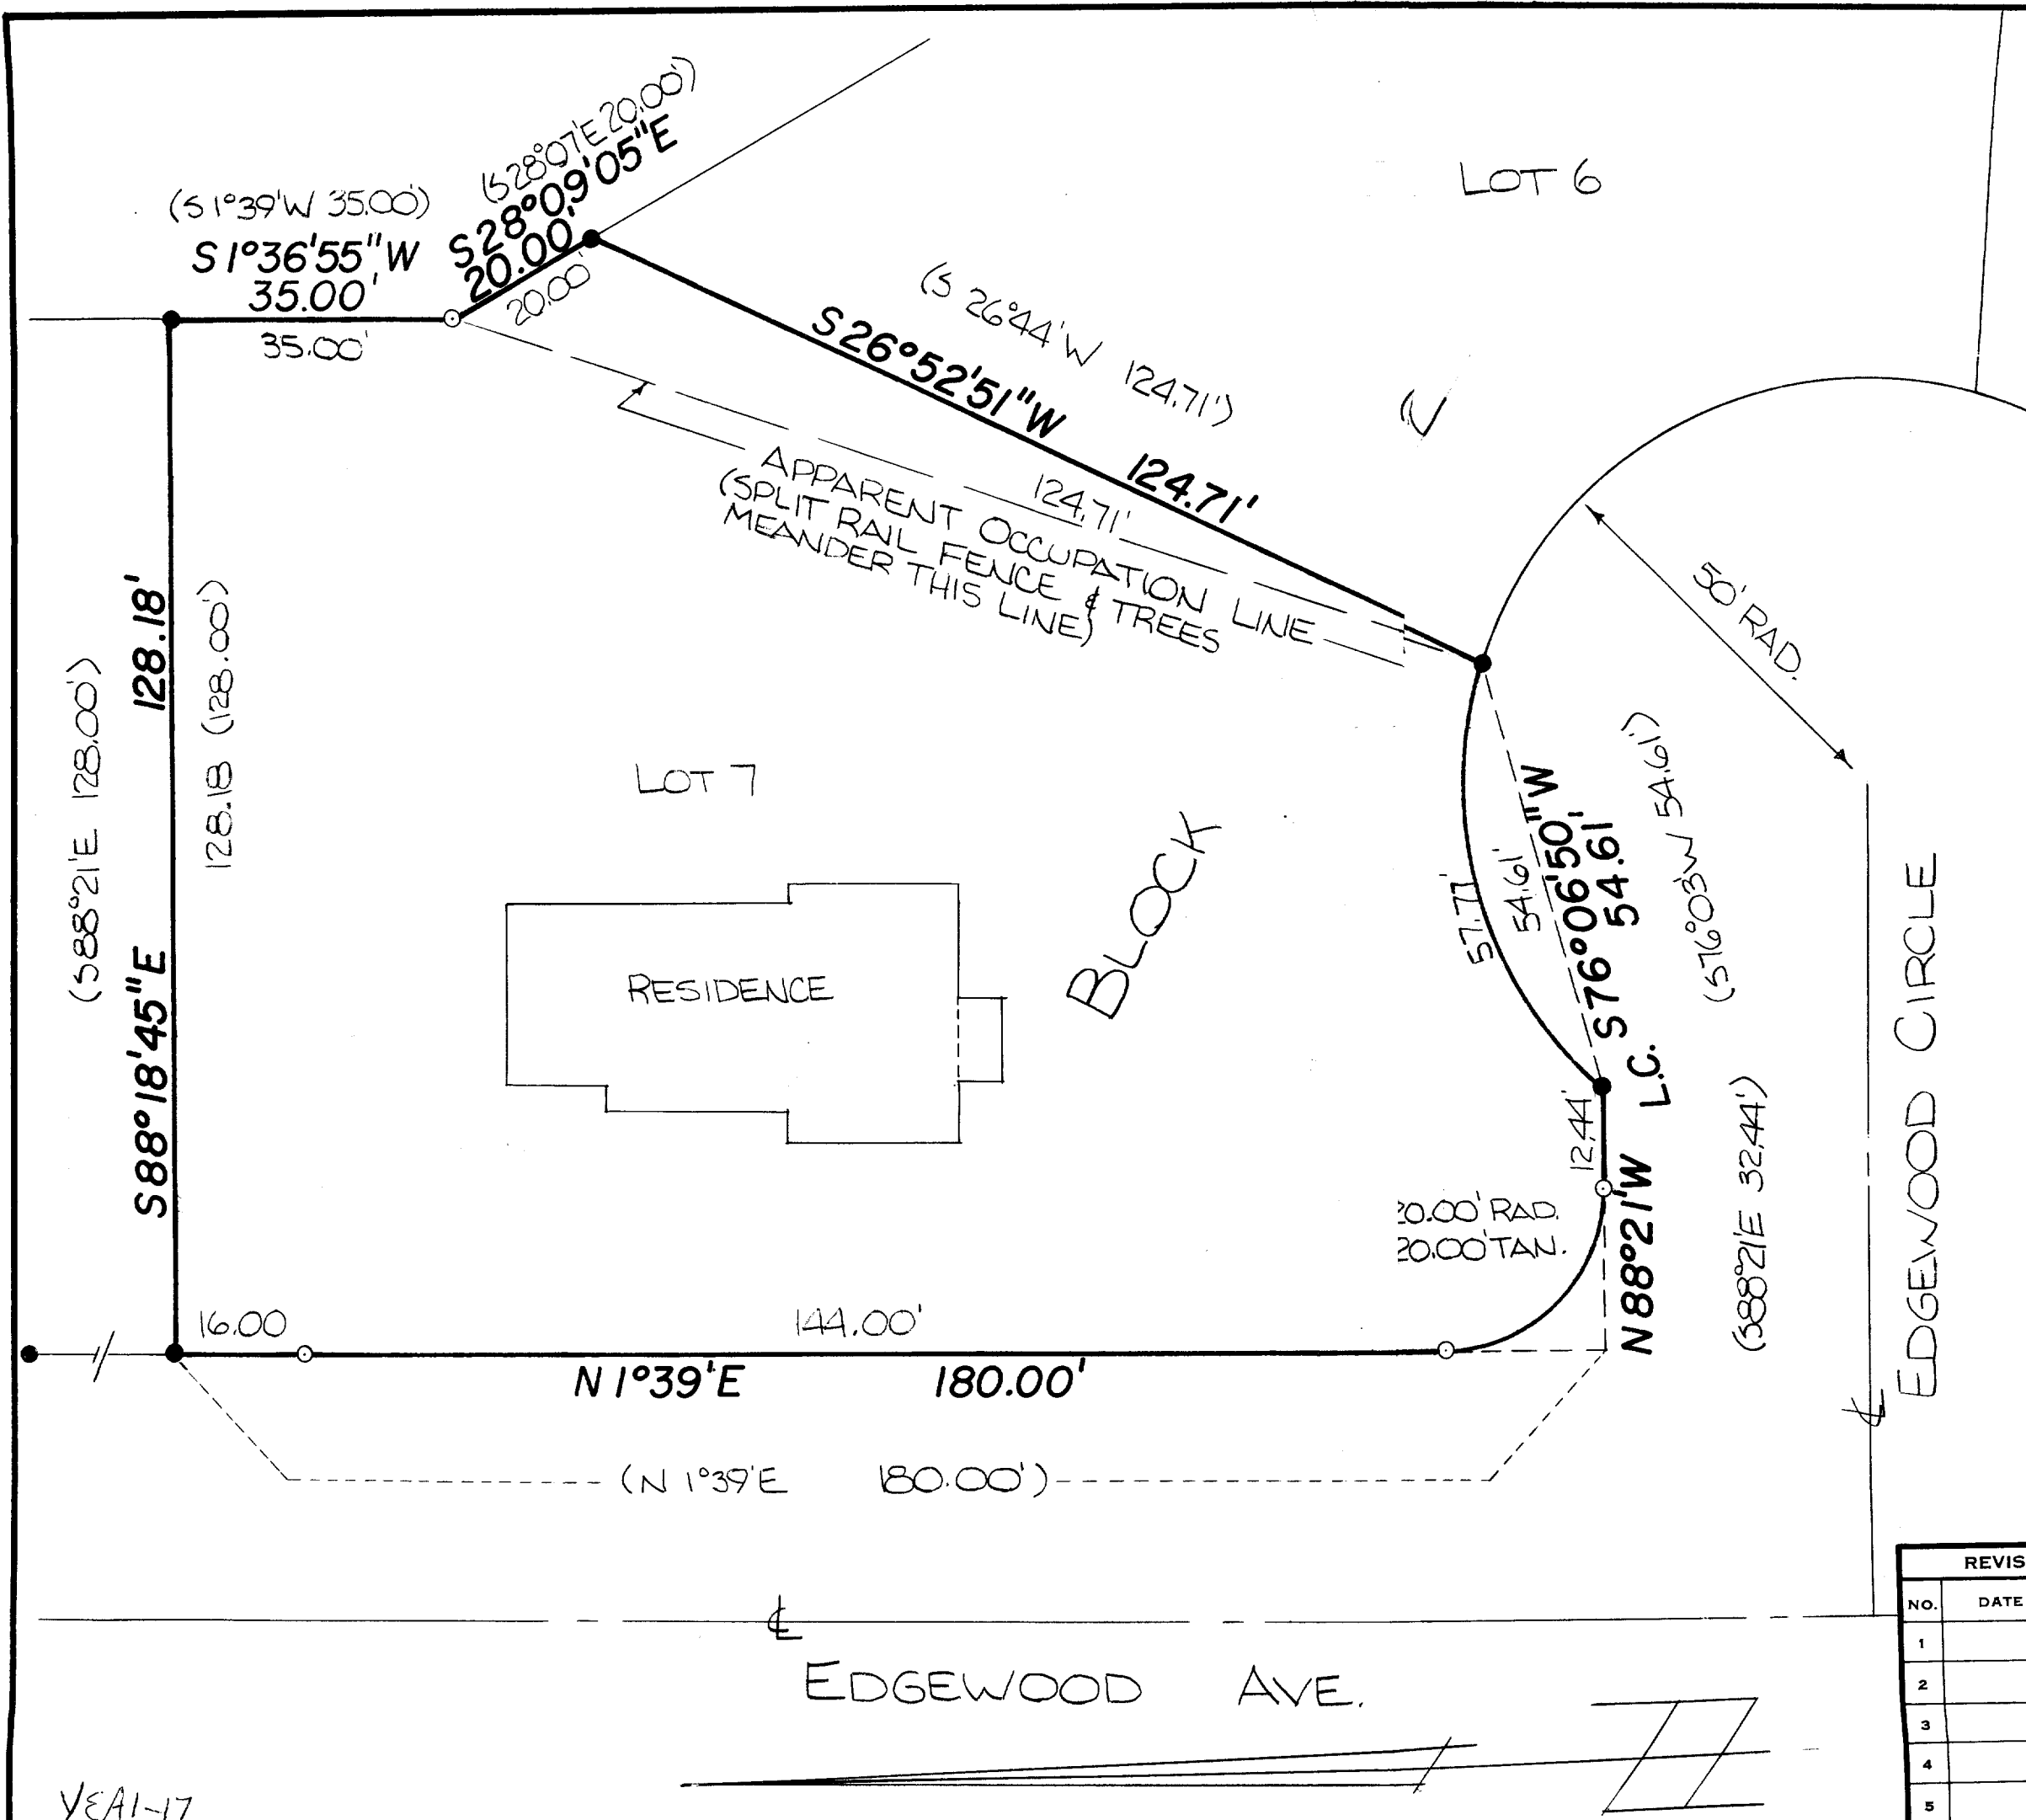

DESCRIPTION:

LOT 7 OF BLOCK 2 OF
EDGEWOOD 1ST ADDITION
IN THE CITY OF ELKHORN,
WALWORTH COUNTY, WIS-
CONSIN.

CERTIFICATE:

I, JOSEPH M. BIAGI, SUR-
VEYOR, DO HEREBY CER-
TIFY THAT I HAVE SUR-
VEYED THE PROPERTY
HEREON DESCRIBED.

DATE:
AUGUST 29, 1975

Joseph M. Biagi
JOSEPH M. BIAGI
S-12



LEGEND:

- IRON PIPE FOUND
- IRON PIPE SET
- () RECORDED AS

REVISIONS			LOT 7 BLK 2 EDGEWOOD 1 ST ADD		
NO.	DATE	BY	FRANK GRONERT		
1			DRAWN BY	GW	SCALE 1" = 20'
2			CHK'D		DATE 8/29/75
3			TRACED		APP'D
4			DRAWING NO. 84-75		
5					