


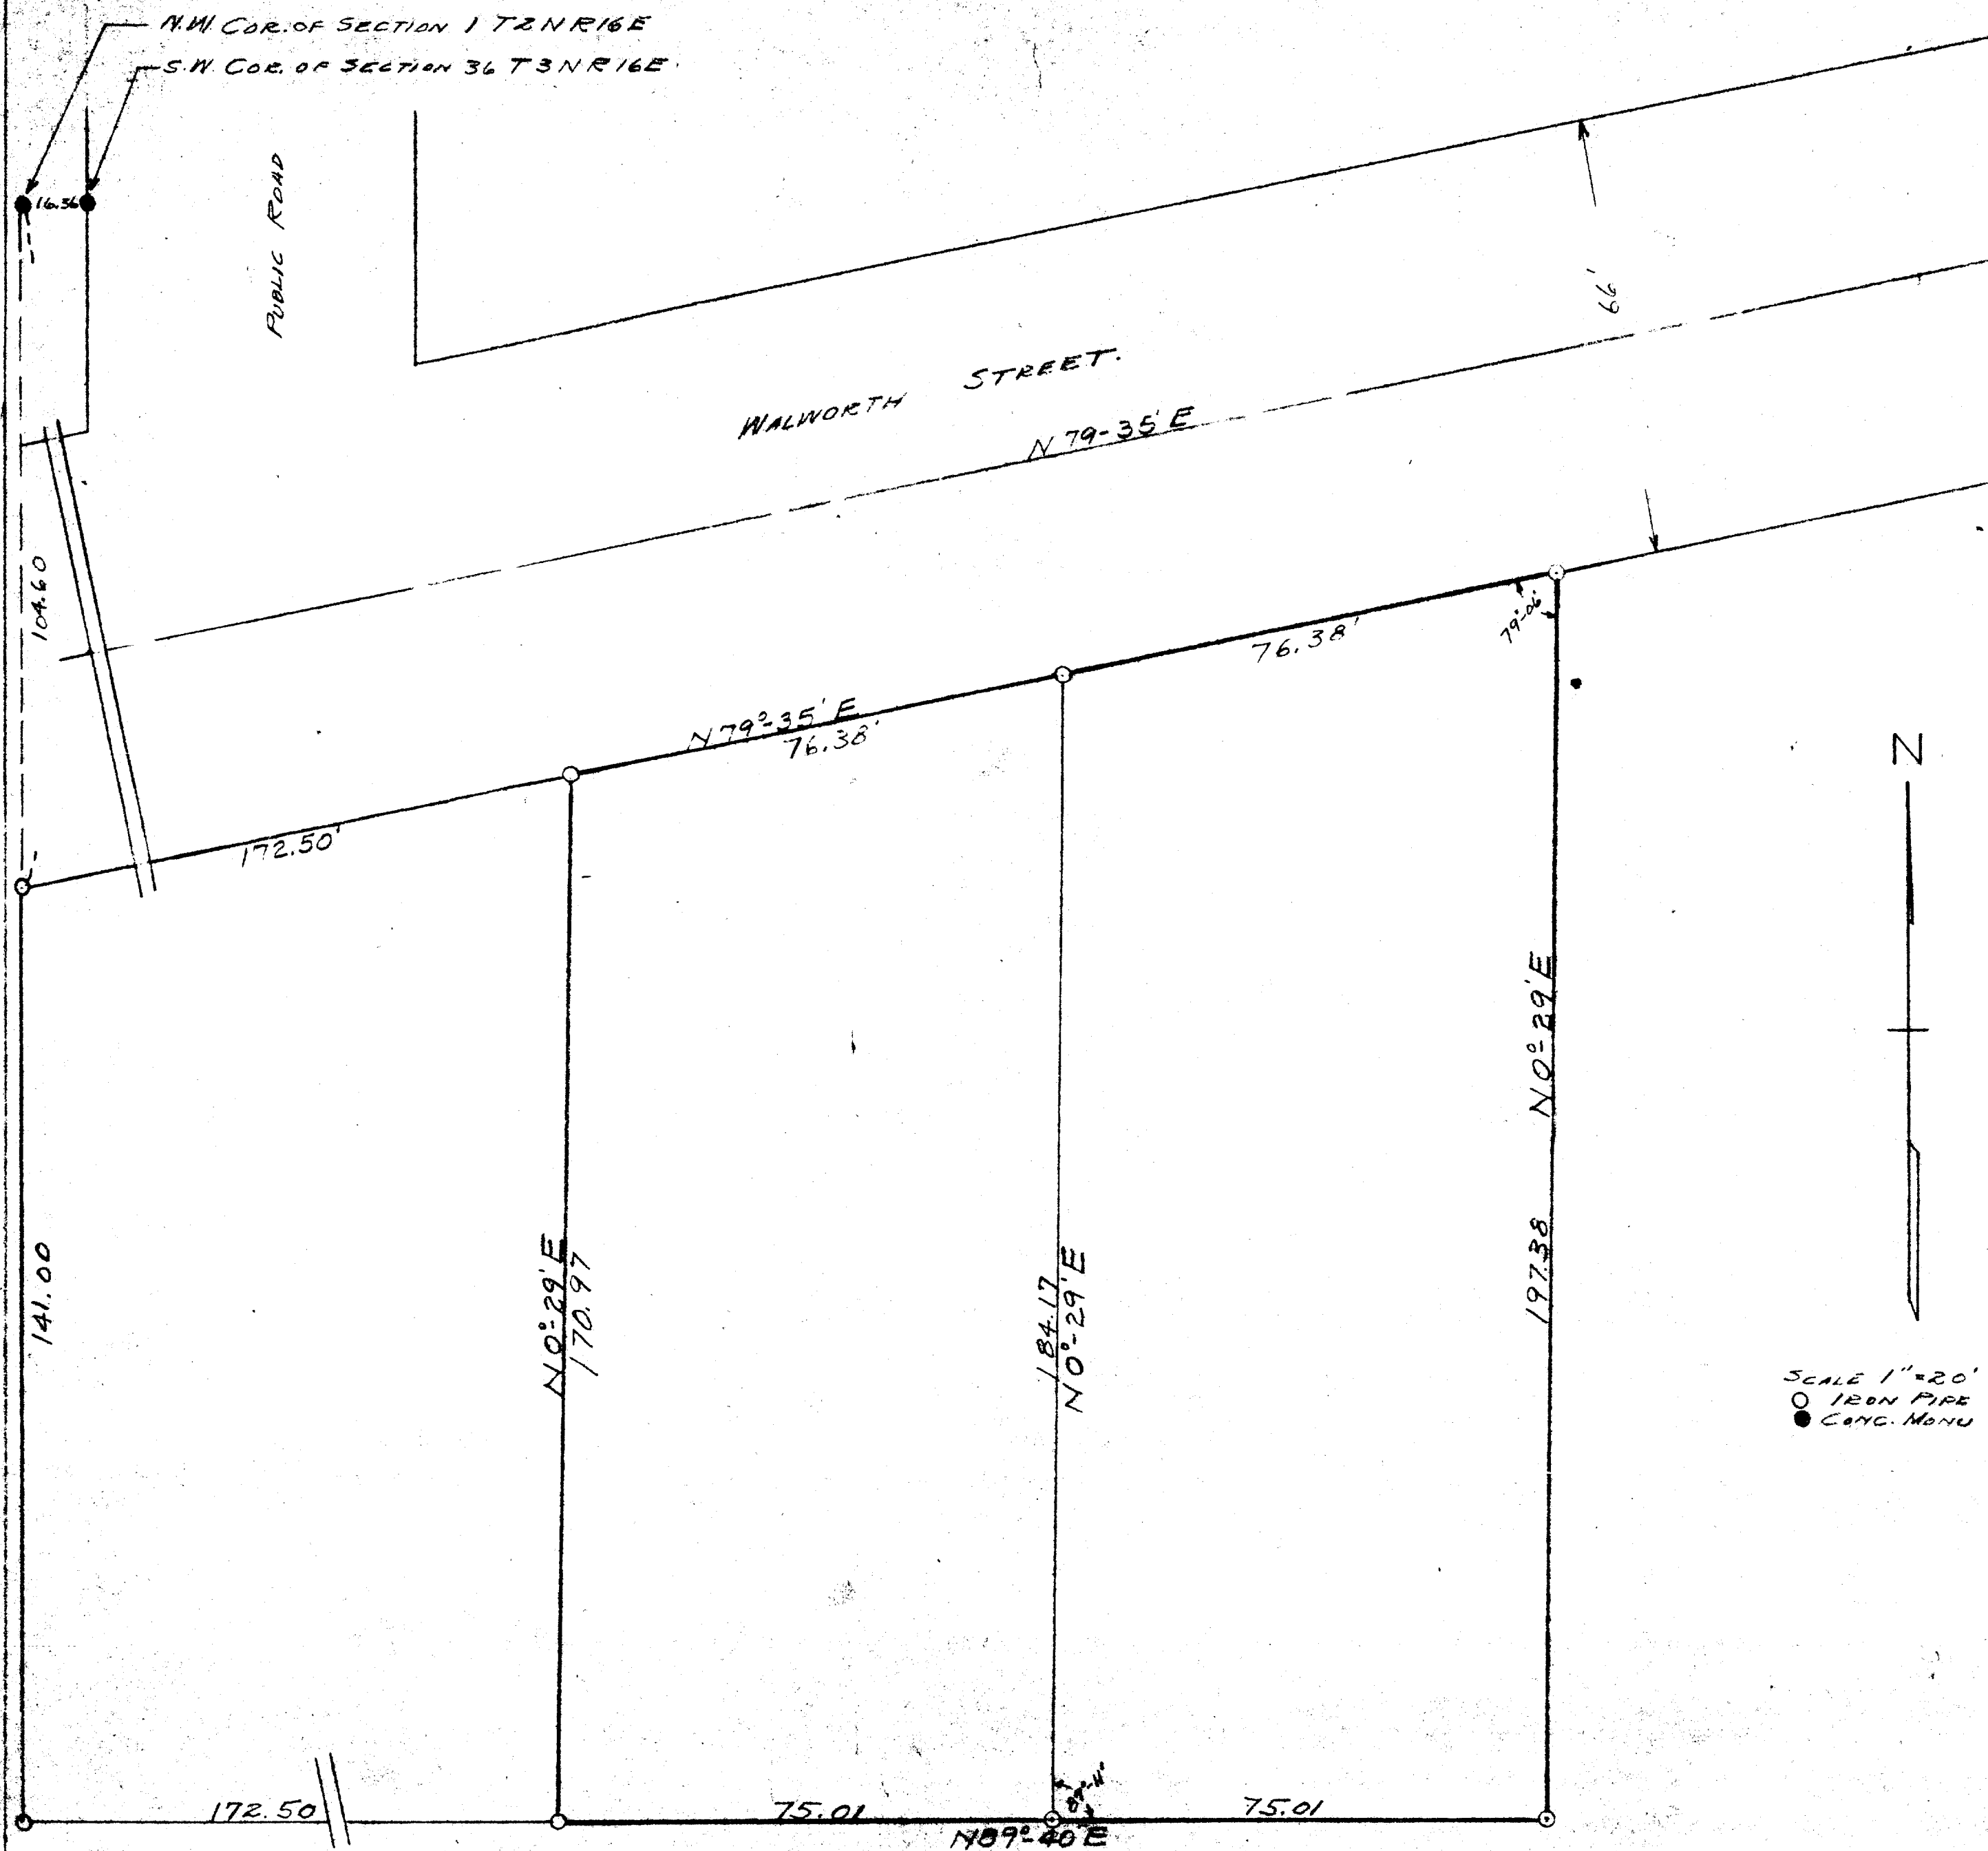

SCALE 1"=20'
 ○ IRON PIPE
 ● CONC. MONU

PLAT OF SURVEY OF LAND LOCATED IN THE NORTHWEST 1/4
 OF SECTION 1, T2N R16E, CITY OF ELKHORN, WALWORTH
 COUNTY, WISCONSIN
 JULY 26, 1951

Lloyd L. Jensen
 COUNTY SURVEYOR