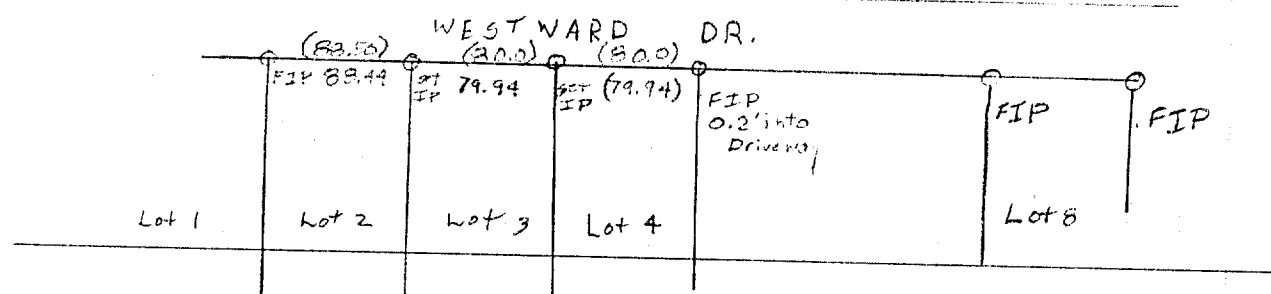


Copy of Notes in James Jones 2nd Add. Elkhorn

Job # 1651

Jan 7 1980

T Loomis
B. Ohberg

James Jones 2nd Add. IP on lot 3 BL1

Found IPs on lot 6 - 1st lot - 1st lot 2nd lot
IPs fell in a straight line, the dist. bet.
IP were lot 4 and E cor lot 2 was 0.18 ft.
short so we proposed to add a 1 set
IP on lot 2

IV
↓

Work Ordered By: City of Elkhorn Light & Water Com.

Reset pipes claimed to have been removed
by utility construction.