


FARRIS, HANSEN & COOPER, INC.

ENGINEERING, SURVEYING AND LAND PLANNING
715 W. WALWORTH ST. - P.O. BOX 487 - ELKHORN, WI 53121
OFFICE: 414/723-2098

PLAT OF SURVEY OF LOTS 8 & 9 OF BLOCK 45 OF DAVIS ADDITION TO THE CITY OF ELKHORN, WALWORTH COUNTY WISCONSIN

LEGEND

- = FOUND IRON ROD SURVEY STAKE
- ⊙ = FOUND IRON PIPE SURVEY STAKE
- = SET IRON PIPE SURVEY STAKE
(RECORD DIMENSION)

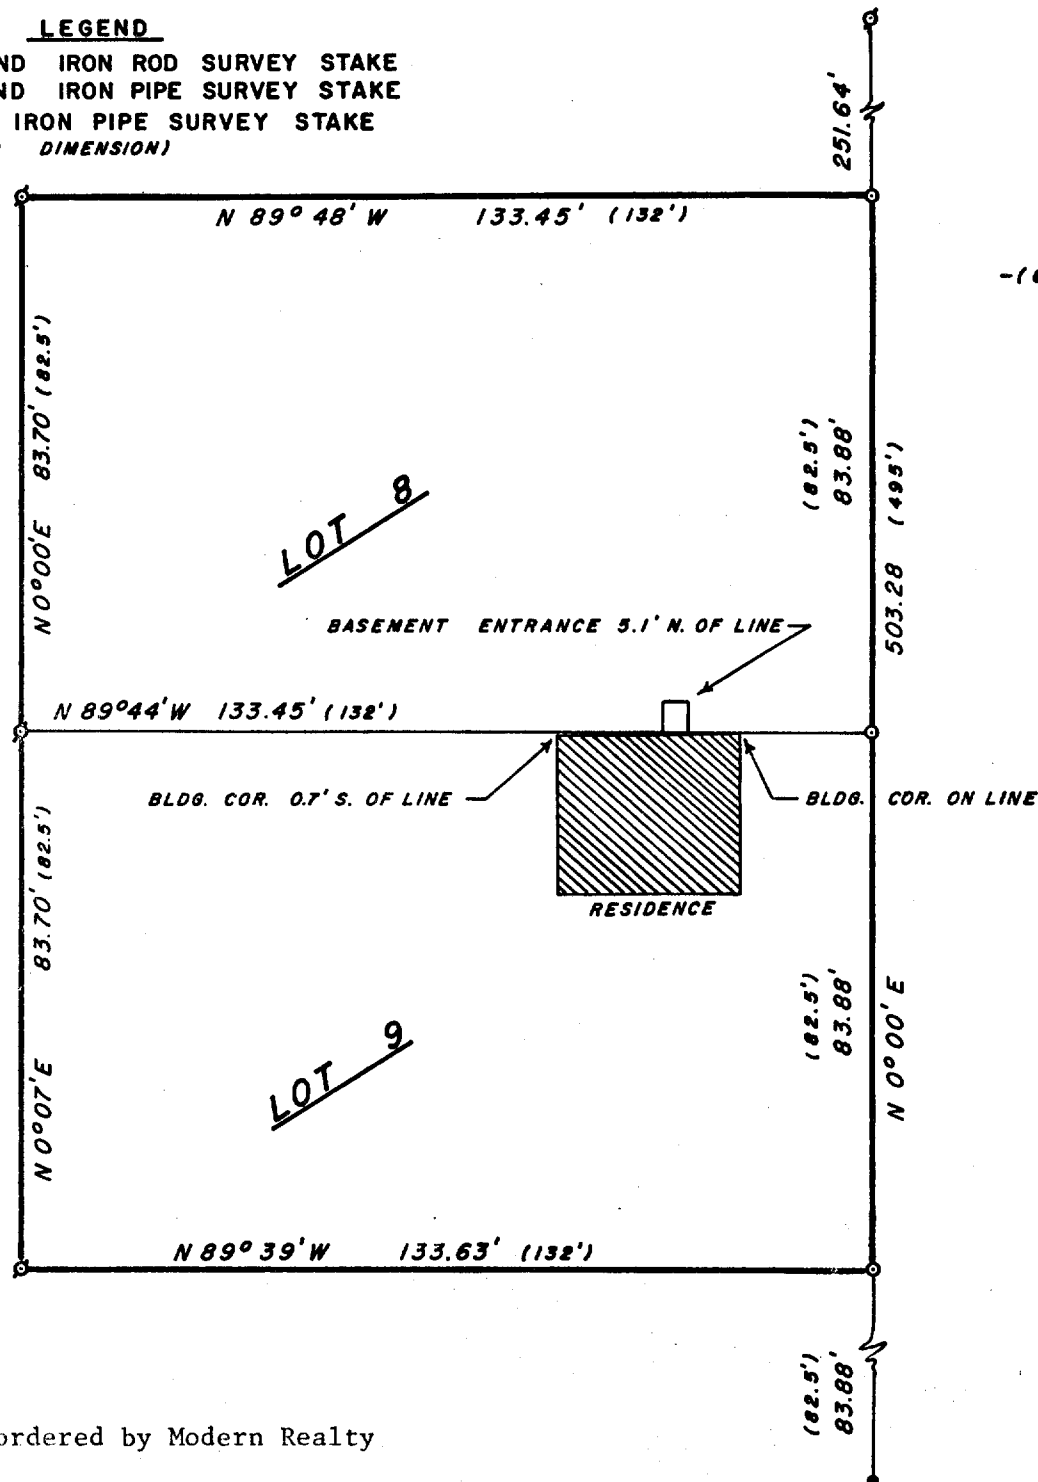

Work ordered by Modern Realty

I HEREBY CERTIFY that this Plat of survey is a true and accurate representation of the lot lines and building located thereon to the best of my professional knowledge and belief.

Robert A. Farris
Robert A. Farris RLS

Dated this 26th day of August 1980

DRAWING NUMBER 1740

YD-60A.61

4-312-F