



Commencing at a point in the North line of West Centralia Street that is 132' West of the West line of South Church Street thence North 194° thence West 100' thence South 194° to North line of West Centralia Street thence East 100' to point of beginning. City of Elkhorn.

Commencing at a point in the North line of West Centralia Street that is 232' West of West line of South Church Street thence North 198' thence West 60' thence South 198' thence East 60' to point of beginning, City of Elkhorn.

I hereby certify that I have surveyed the above described lands according to plats of survey on file in the Walworth County Surveyor's Office and that this Plat of Survey is a true and accurate representation of the location of buildings on said lands to the best of my professional knowledge and belief.

Dated this 12th day of June, 1980.

Robert A. Farris
Robert A. Farris, RLS No. 1293.

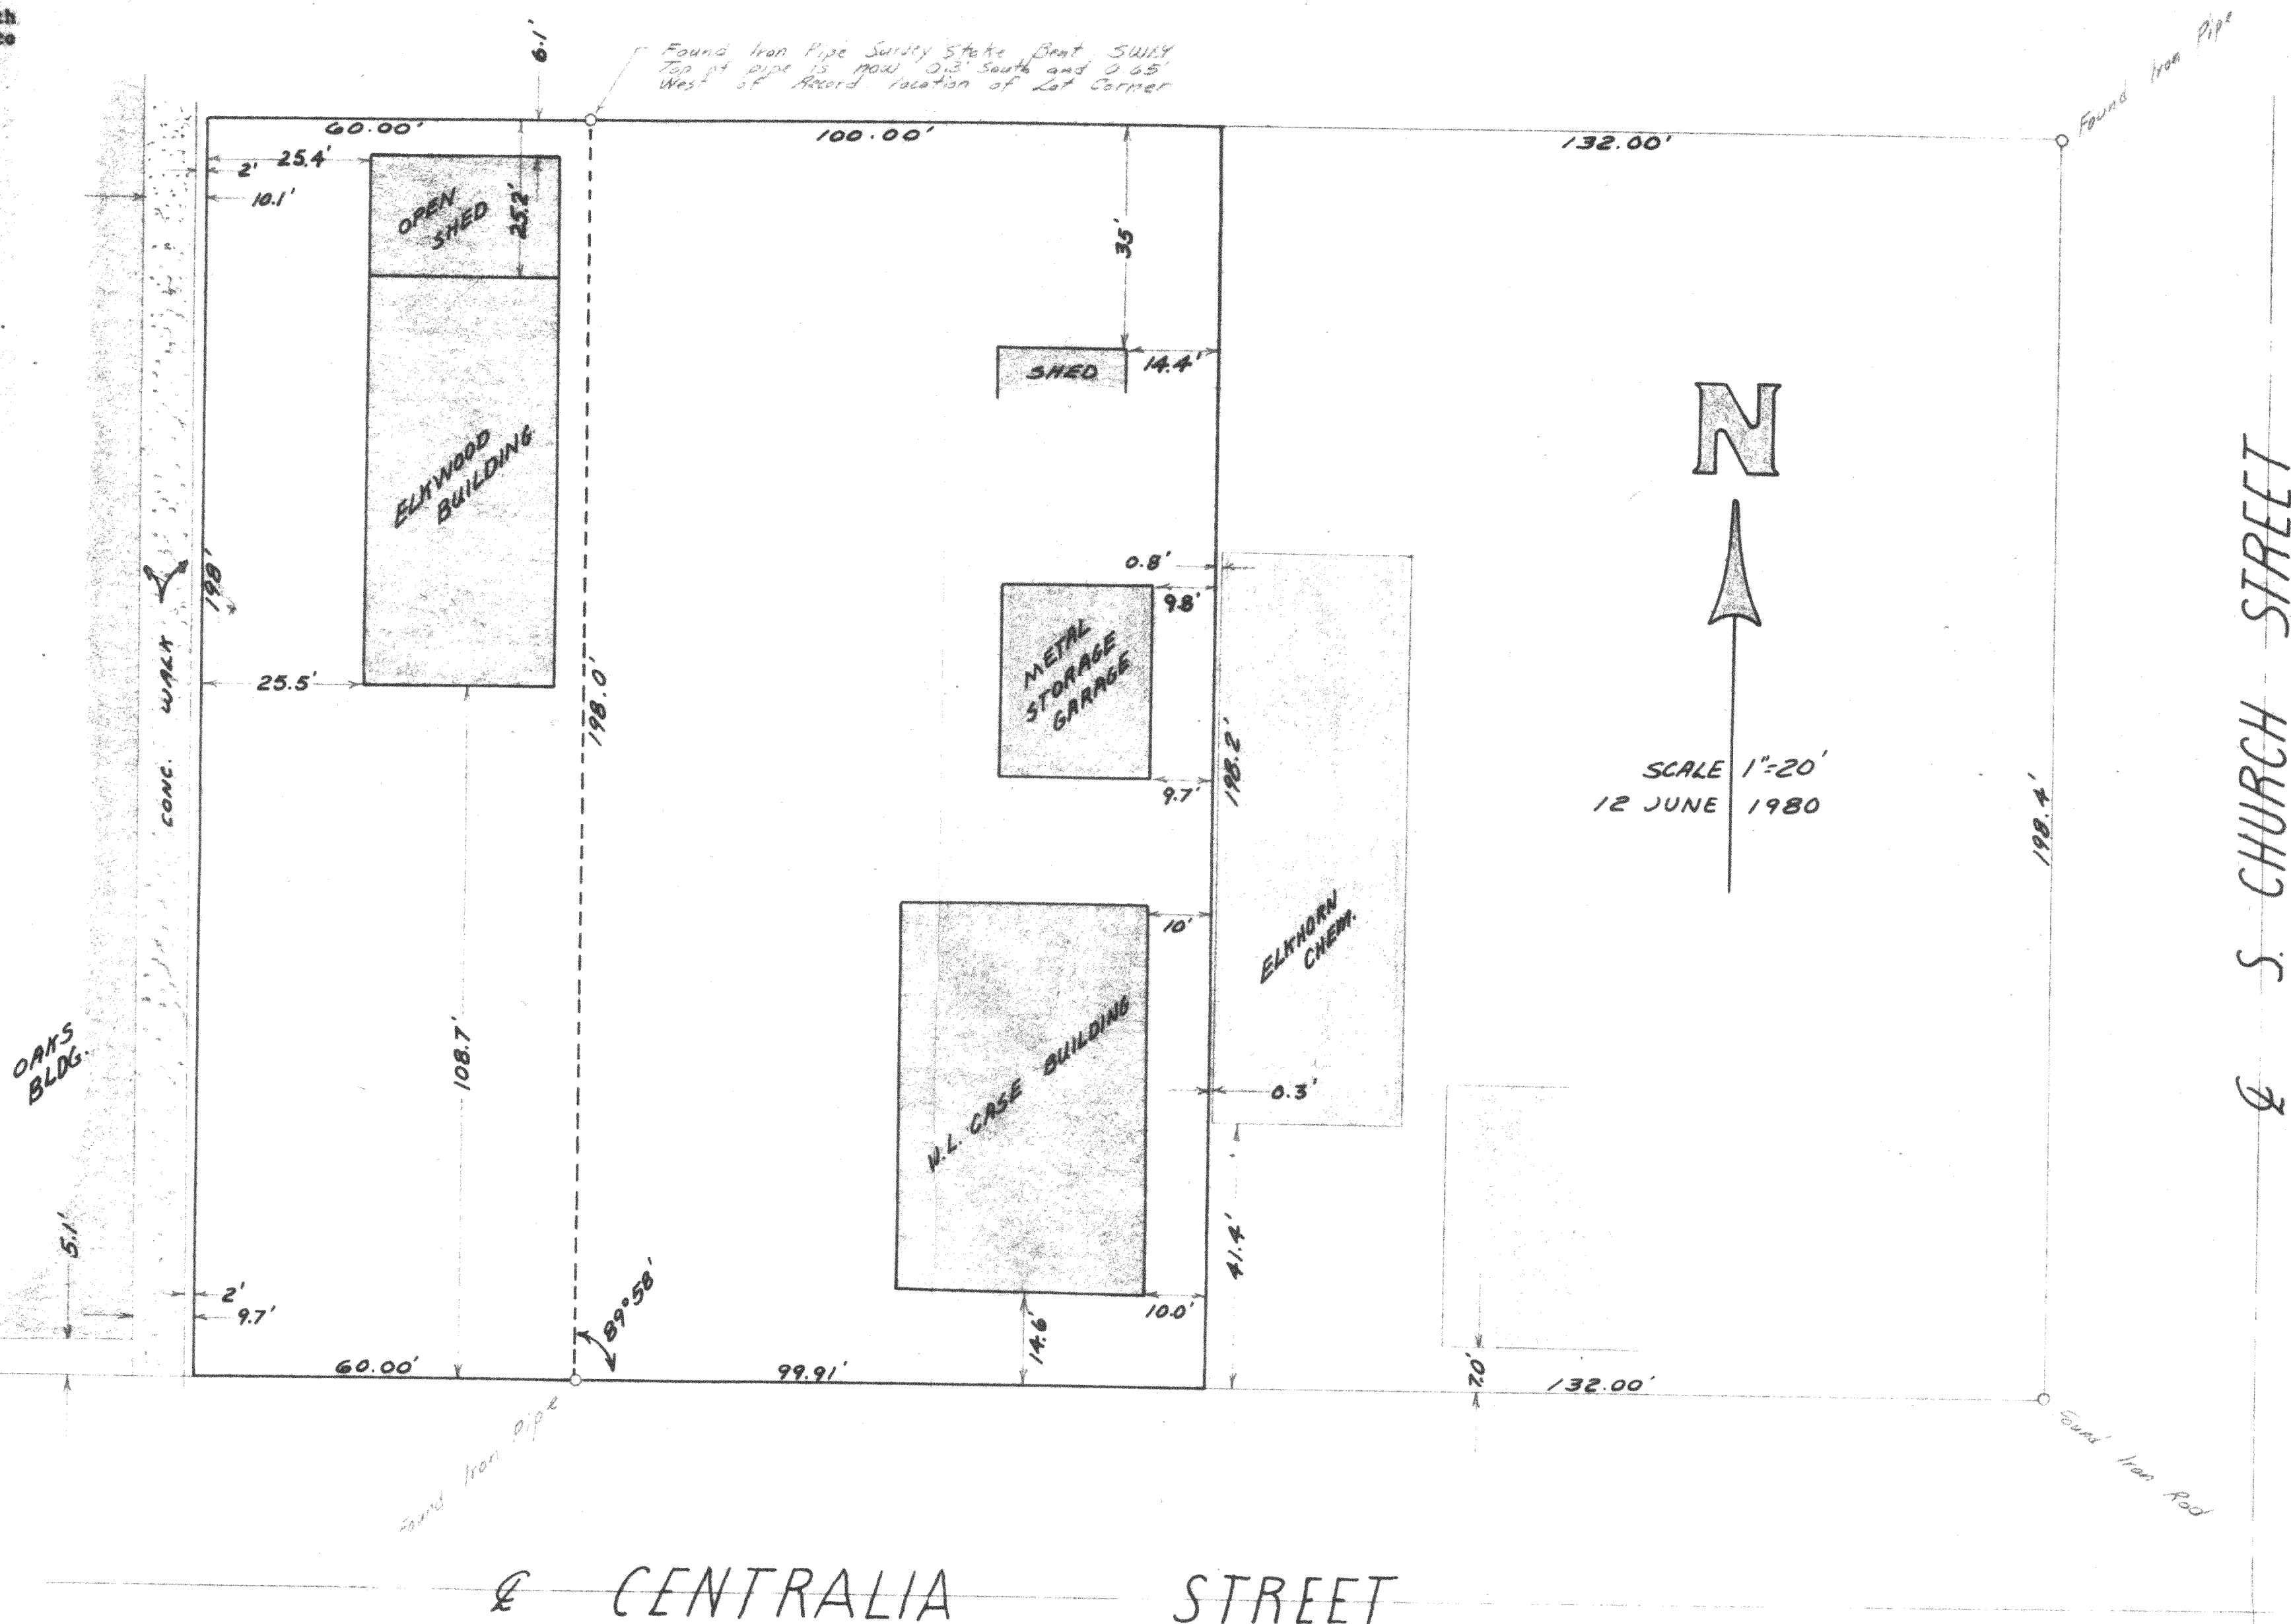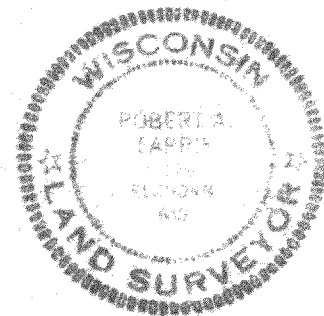

PLAT OF SURVEY OF A PARCEL LOCATED IN THE NE 1/4 OF SECTION 1, T. 2N., R. 16 E. CITY OF ELKHORN, WALWORTH CO. WISCONSIN

FARRIS, HANSEN & COOPER, INC.
ENGINEERING, SURVEYING AND LAND PLANNING
715 W. WALWORTH ST. • P.O. BOX 457 • ELKHORN, WI 53121

U-SW-53D ~~53E~~

PROJECT 1710 4313F