



FARRIS, HANSEN & COOPER, INC.  
ENGINEERING, SURVEYING AND LAND PLANNING  
715 W. WALWORTH ST. - P.O. BOX 487 - ELKHORN, WI 53121

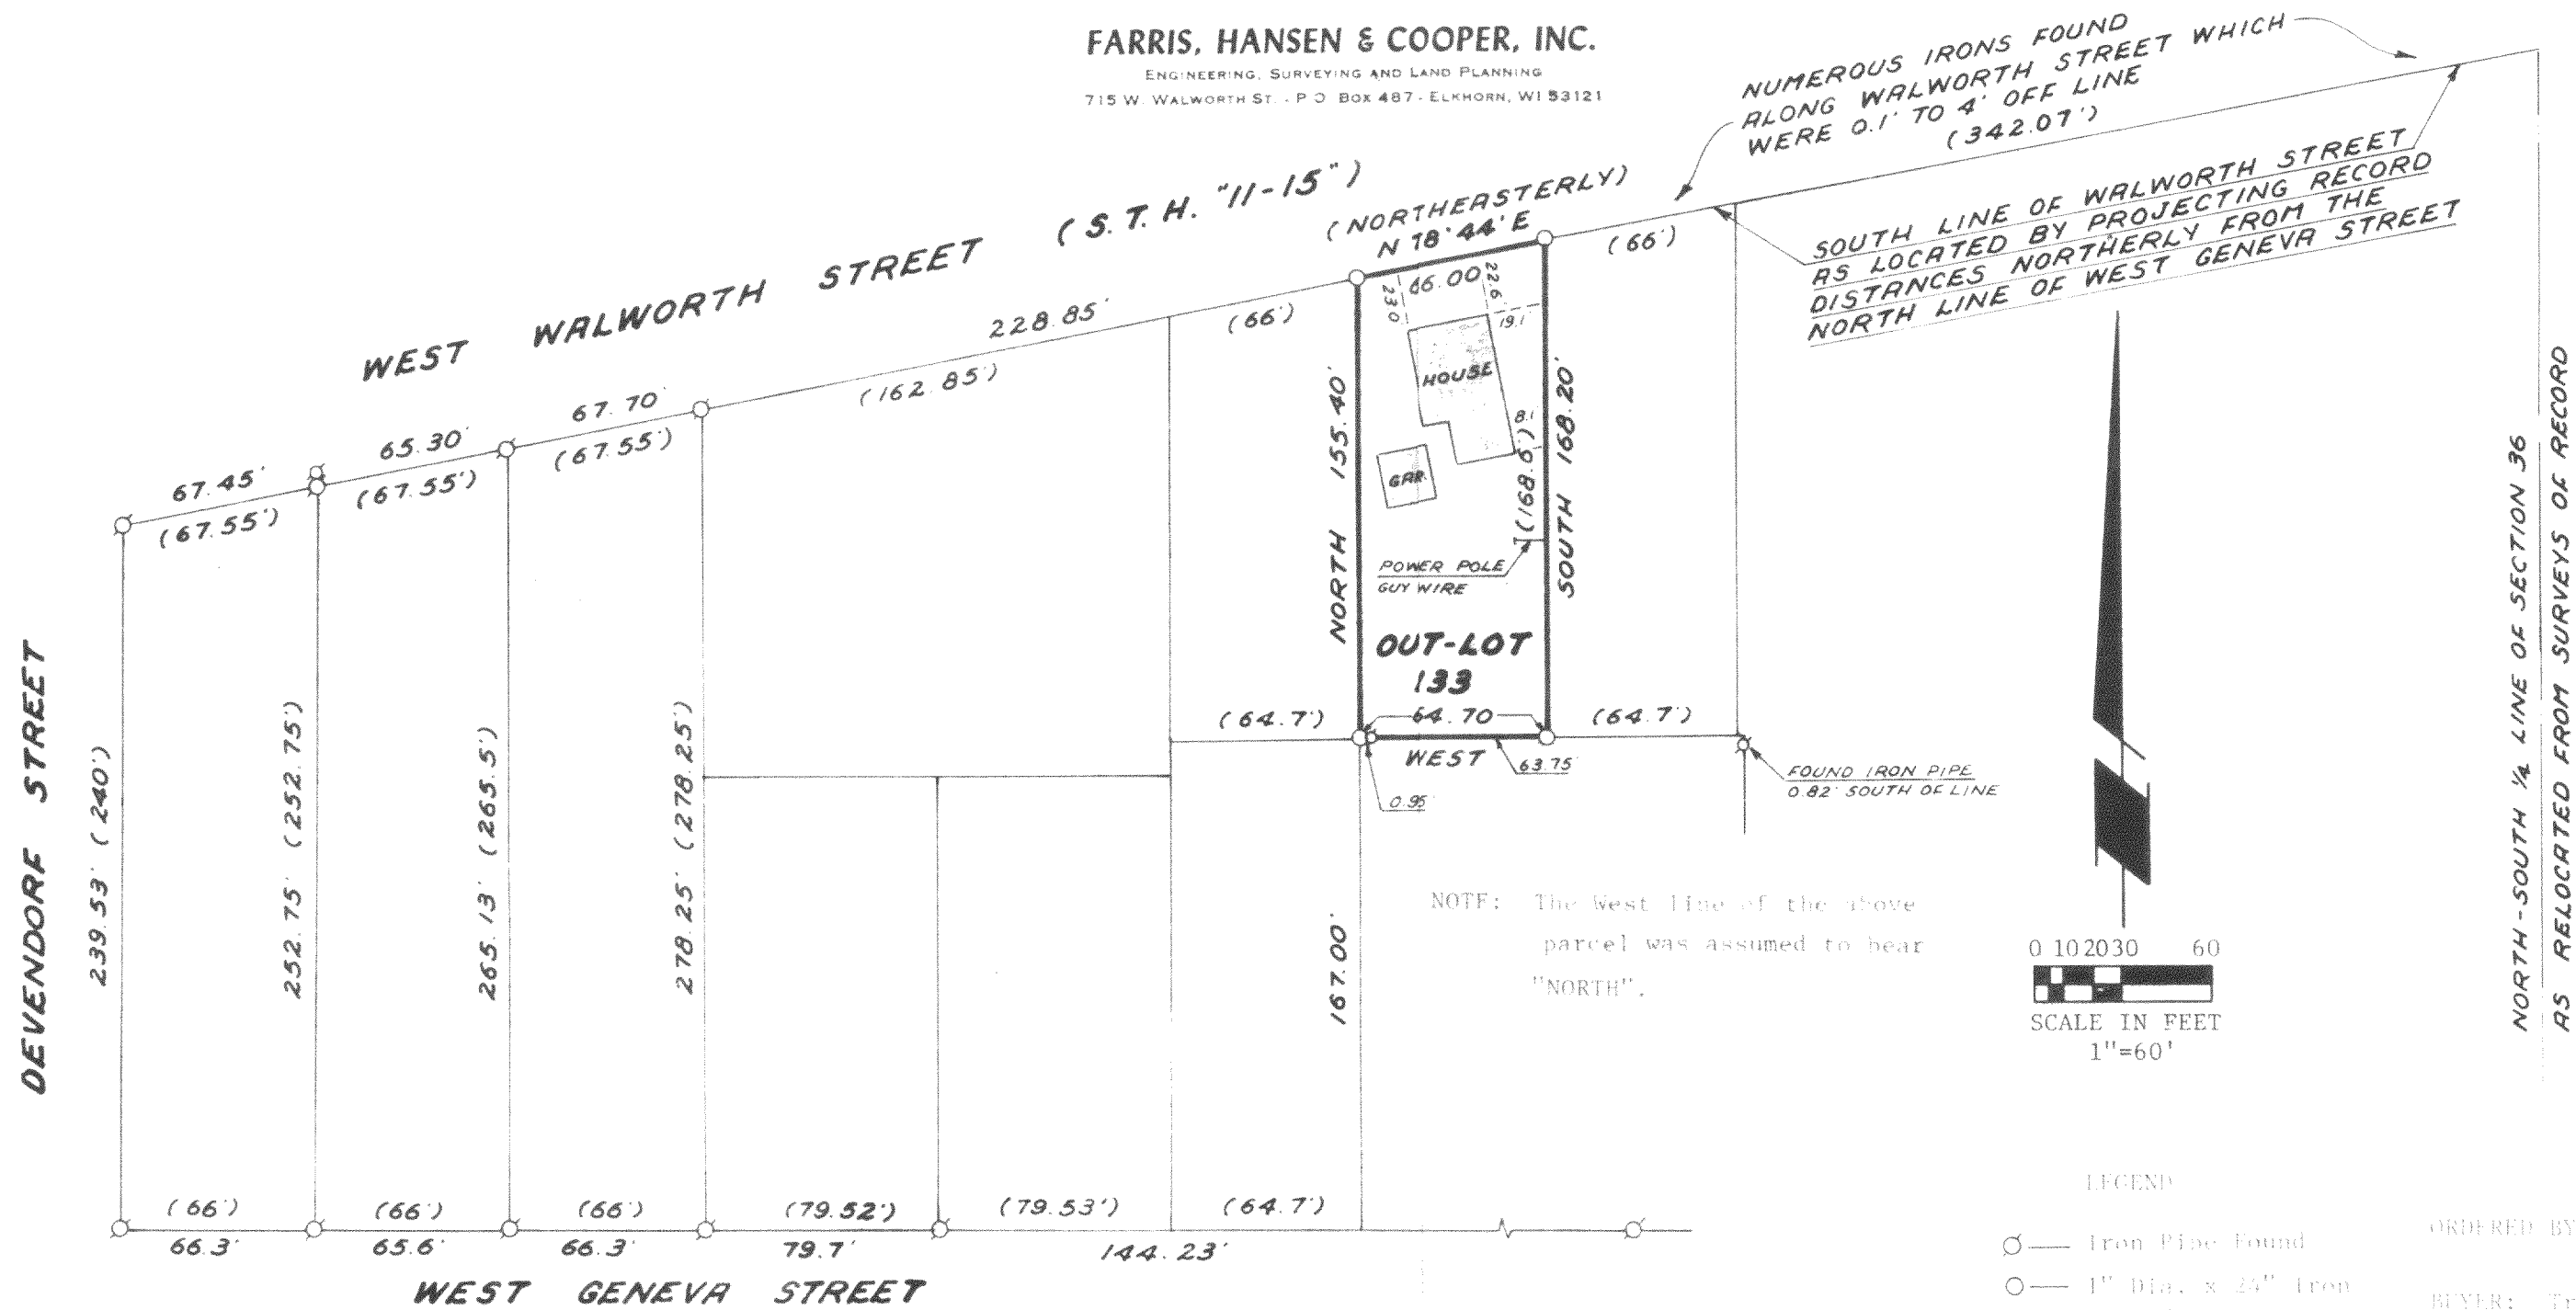

PLAT OF SURVEY OF

A piece or parcel of land situated in the SW 1/4 of Section 36, Town 3 North, Range 16 East, City of Elkhorn, Walworth County, Wisconsin described as follows, to-wit: Beginning in the south line of Walworth Street at a point 342.07 feet southwest of the intersection of said south line with the north and south quarter line of said section, thence south in the west line of land formerly owned by A. C. Oleson and wife, 168.6 feet to a stake, thence west 64.7 feet to a stake, thence north 155.4 feet to a stake in the south line of Walworth Street, thence northeasterly in said south line 66 feet to the place of beginning.

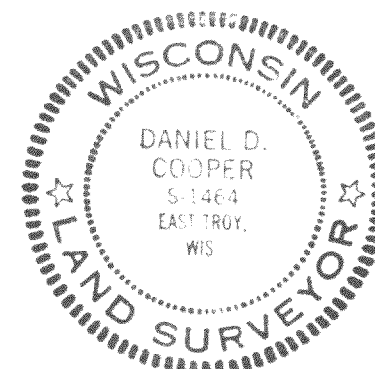

I HEREBY CERTIFY that I have surveyed the property described hereon and that this Plat of Survey is a true and accurate representation of the lot lines to the best of my professional knowledge and belief.

*Daniel D. Cooper*  
Daniel D. Cooper, RLS No. 1464

Dated this 7 day of Sept 1979.

PROJ. NO. 1607