


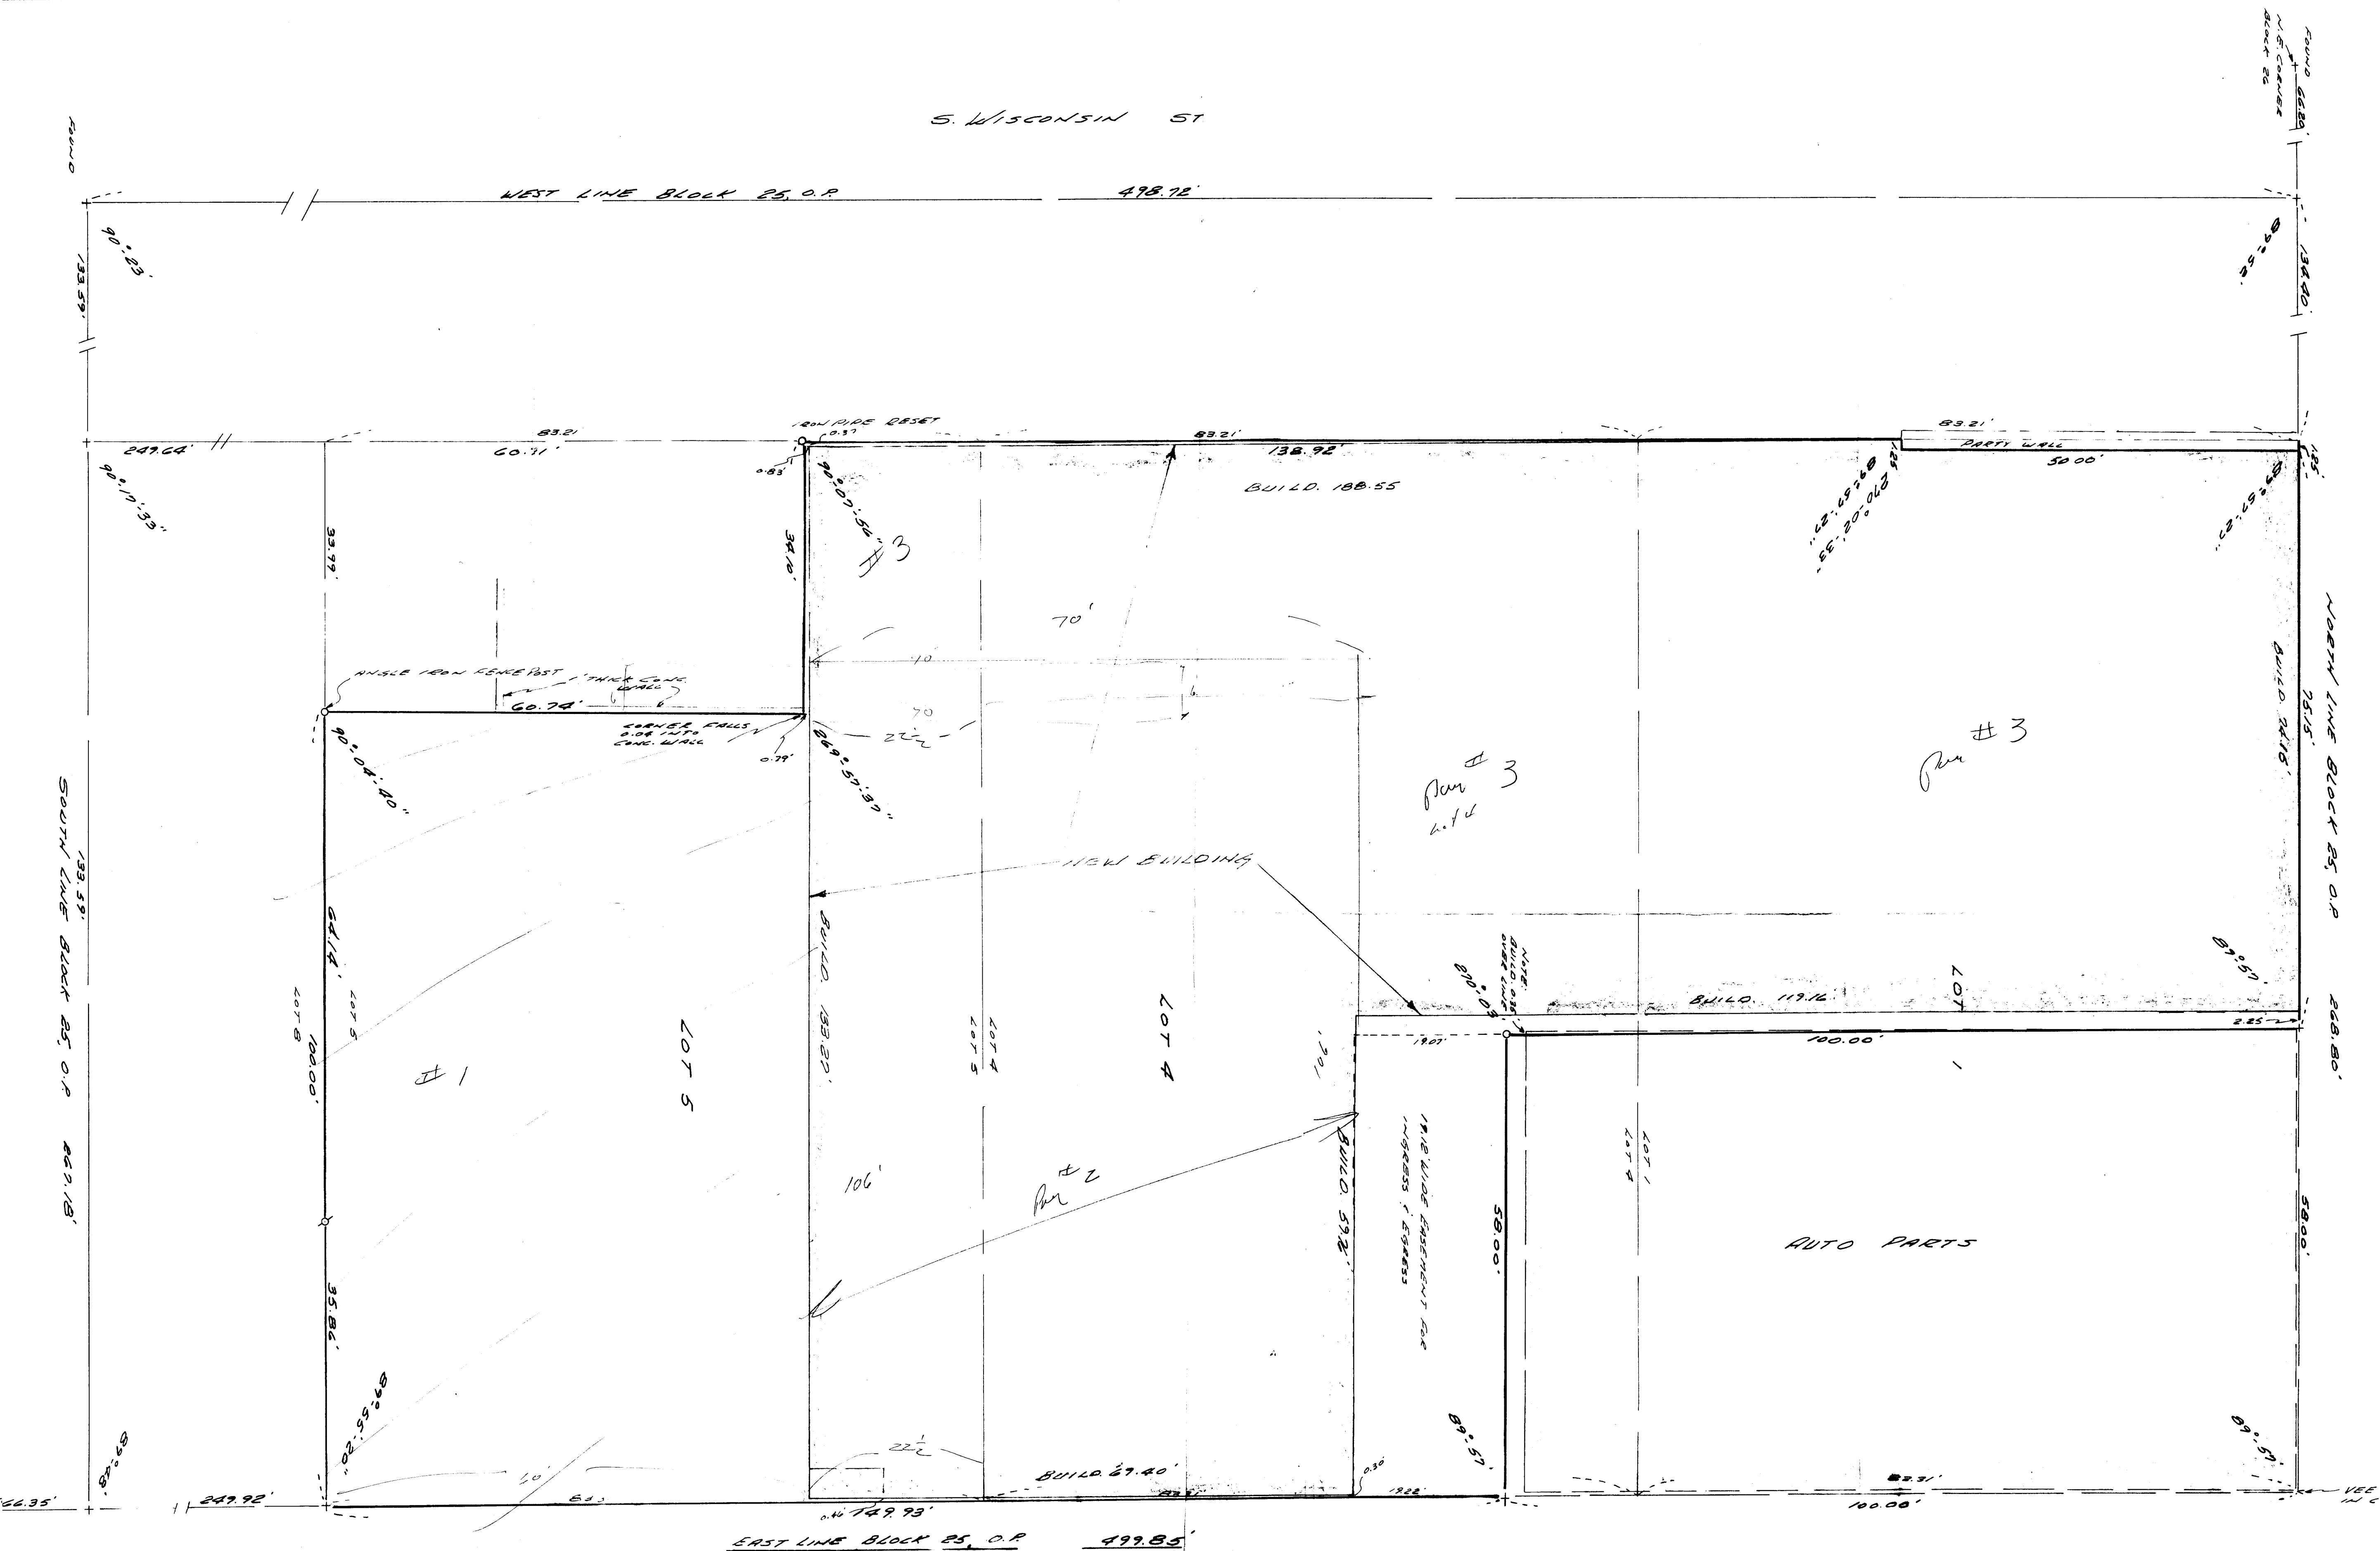

WE HEREBY CERTIFY THAT WE HAVE SURVEYED THE ABOVE PROPERTY AND THAT THE PLAT SHOWS THEREON A TRUE AND CORRECT SURVEY AND A TRUE REPRESENTATION OF THE SAME. WE CORRECTLY SHOWS THE EXTERIOR BOUNDARY LINES AND DIVISIONS OF SAID PROPERTY AND THE LOCATION OF ALL BUILDINGS ON SAID PROPERTY.

S. WASHINGTON ST.

~ CHISEL CROSS CUT IN CONC WALK
 X- IRON PIPE FOUND
 O- IRON PIPE SET
 NOTE:
 THE ESTABLISHMENT OF ALL BLOCK CORNERS IN ORIGINAL PLAT ARE BASED ON AVAILABLE RECORDS IN THE CITY ENGINEERS OFFICE. UNDER RUN & OVER RUN OF LOT & BLOCK DISTANCES WERE ESTABLISHED FROM SAID RECORDS.

PLAT OF SURVEY OF PART 1, 4, 5, BLOCK 25, ORIGINAL CITY OF ELKHORN, WALWORTH COUNTY, WISCONSIN.	
DRAWN BY T.P.A. JENSEN	JENSEN & JOHNSON CIVIL ENGINEERS ELKHORN, WIS. DATE JULY 1971
CHECKED BY	
APPROVED BY	