


123-60

FARRIS, HANSEN & COOPER, INC.

ENGINEERING, SURVEYING AND LAND PLANNING
715 W. WALWORTH ST. - P.O. BOX 487 - ELKHORN, WI 53121

PLAT OF SURVEY of Lot 6, Block 32
of Rockwell's Addition to the
City of Elkhorn, Walworth County,
Wisconsin

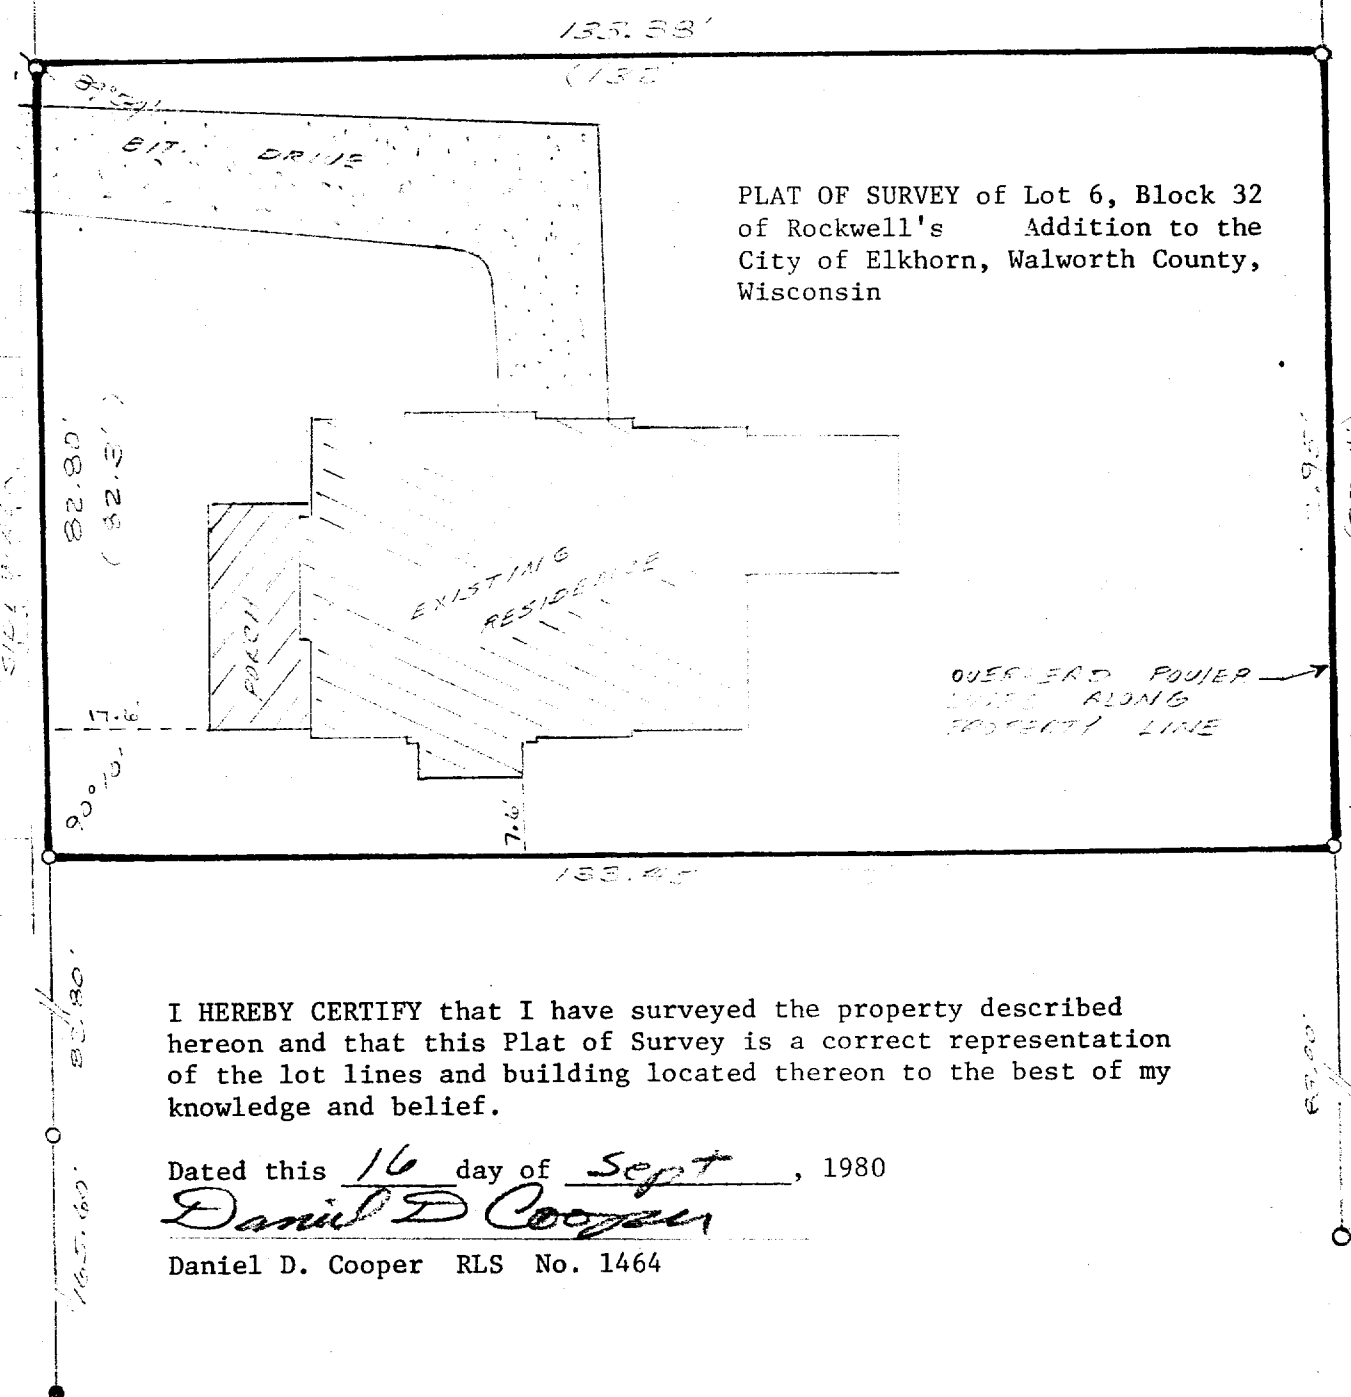


I HEREBY CERTIFY that I have surveyed the property described hereon and that this Plat of Survey is a correct representation of the lot lines and building located thereon to the best of my knowledge and belief.

Dated this 16 day of Sept, 1980

Daniel D Cooper

Daniel D. Cooper RLS No. 1464

- INDICATES IRON PIPE FOUND
- ⊗ INDICATES 5/8" DI. X 24" IRON ROD SET
- INDICATES IRON ROD FOUND

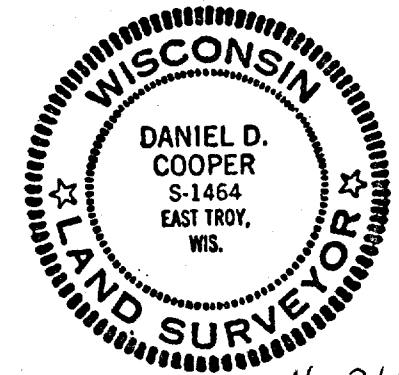

4-315-F
DRAWING NO. 1754