


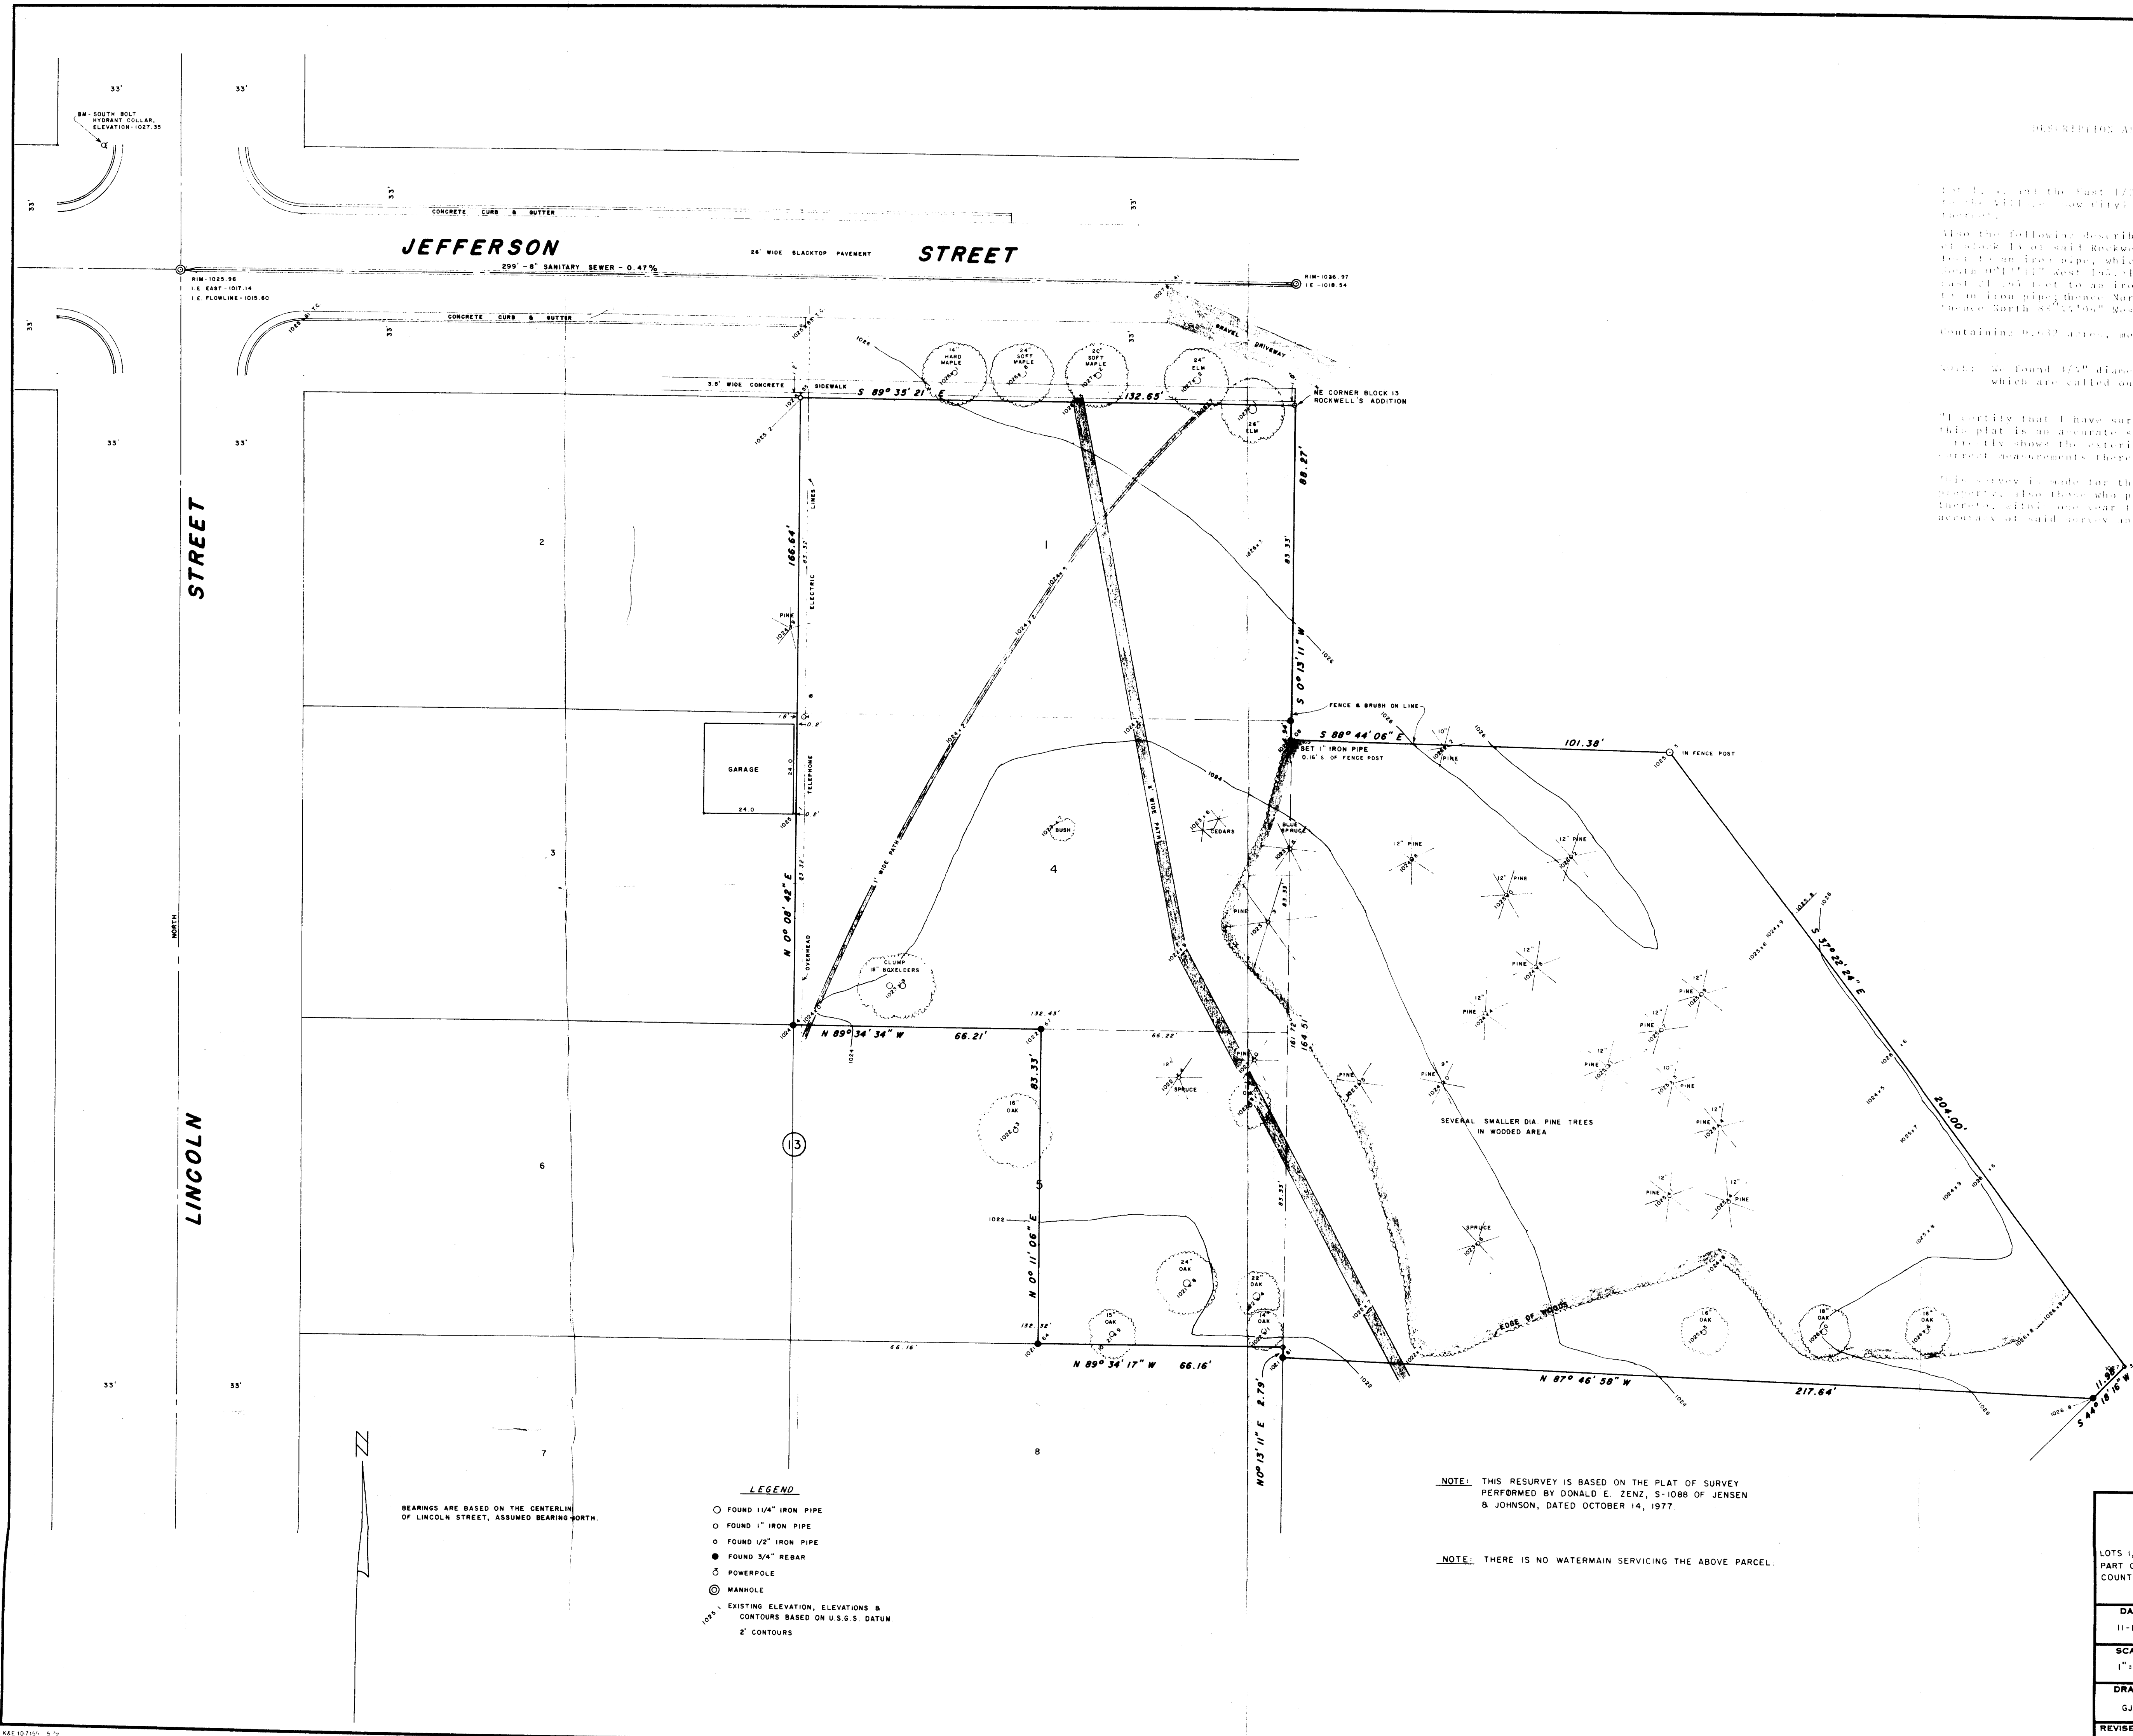

DESCRIPTION AS RECORDED IN VOLUME 216, PAGE 958
AS
RECORDED AUGUST 8, 1978

1. The East 1/2 of Lot 1, Block 13, of Rockwell's Addition to the City of Elkhorn, according to the recorded plat therein.

Also the following described parcel: commence at the Northeast corner of block 14 of said Rockwell's Addition; thence South 0°13'11" West 85.27 feet to an iron pipe, which is the point of beginning; thence continue South 0°13'11" West 104.1 feet to an iron pipe; thence South 87°26'58" East 21.25 feet to an iron pipe; thence North 88°18'16" East 14.98 feet to an iron pipe; thence North 37°22'24" West 205.90 feet to an iron pipe; thence North 88°18'16" West 104.1 feet to the point of beginning.

Containing 0.612 acres, more or less.

NOTE: We found 3/4" diameter rebar at some corners instead of iron pipe which are called out in the above description.

"I certify that I have surveyed the property described herein and that this plat is an accurate survey and a true representation thereof and that it shows the exterior boundary lines on said property and the correct measurements thereof."

This survey is made for the exclusive use of the present owners of the property, also those who purchase, mortgage or guarantee the title thereto, within one year from date hereof, and to them I warrant the accuracy of said survey and map.

Kenneth R. Reisman
KENNETH R. REISMAN, R.L.S., 1341
Dated this 15th day of November, 1980

CONTACT APPROPRIATE UTILITIES FOR LOCATION OF ANY UNDERGROUND SERVICE:

WISCONSIN SOUTHERN GAS CO.
41 S. WISCONSIN STREET
ELKHORN, WI 53121
723-4055

STATE LONG DISTANCE TELEPHONE CO.
216 W. WALWORTH STREET
ELKHORN, WI 53121
723-5300

WISCONSIN ELECTRIC POWER CO.
212 W. MAIN STREET
WHITEWATER, WI
ENTERPRISE 5621

NOTE: THIS RESURVEY IS BASED ON THE PLAT OF SURVEY PERFORMED BY DONALD E. ZENZ, S-1088 OF JENSEN & JOHNSON, DATED OCTOBER 14, 1977.

NOTE: THERE IS NO WATERMAIN SERVICING THE ABOVE PARCEL.

PLAT OF SURVEY & SITE PLAN		
FOR ORVILLE E. MADSEN & SON, INC. OF LOTS 1, 4 AND THE EAST 1/2 OF LOT 5, BLOCK 13 OF ROCKWELL'S ADDITION AND PART OF THE SW 1/4 OF SECTION 31, T. 3 N., R. 17 E., CITY OF ELKHORN, WALWORTH COUNTY, WISCONSIN.		
DATE 11-13-80	ROBERS & BOYD, INC. CONSULTING ENGINEERS LAND SURVEYORS HOME OFFICE 109 SOUTH SPRING STREET BURLINGTON, WISCONSIN 53105 PHONE: 414-783-2882 414-783-7834	JOB NO. 80157
SCALE 1" = 20'		CHECKED <i>AKR</i> SHEET
DRAWN GJA	BRANCH OFFICE 809 - 43RD STREET KENOSHA, WISCONSIN 53140 PHONE: 414-898-4488	1 OF 1
REVISED		