


OFFICE: 414/723-2000

WORK ORDERED BY SCHAUDER BUILDING & REALTY

Elevations shown are relative to the south bolt, top of flange, hydrant located at the Northwest corner of intersection 4th and Edgewood recorded as 1007.18.

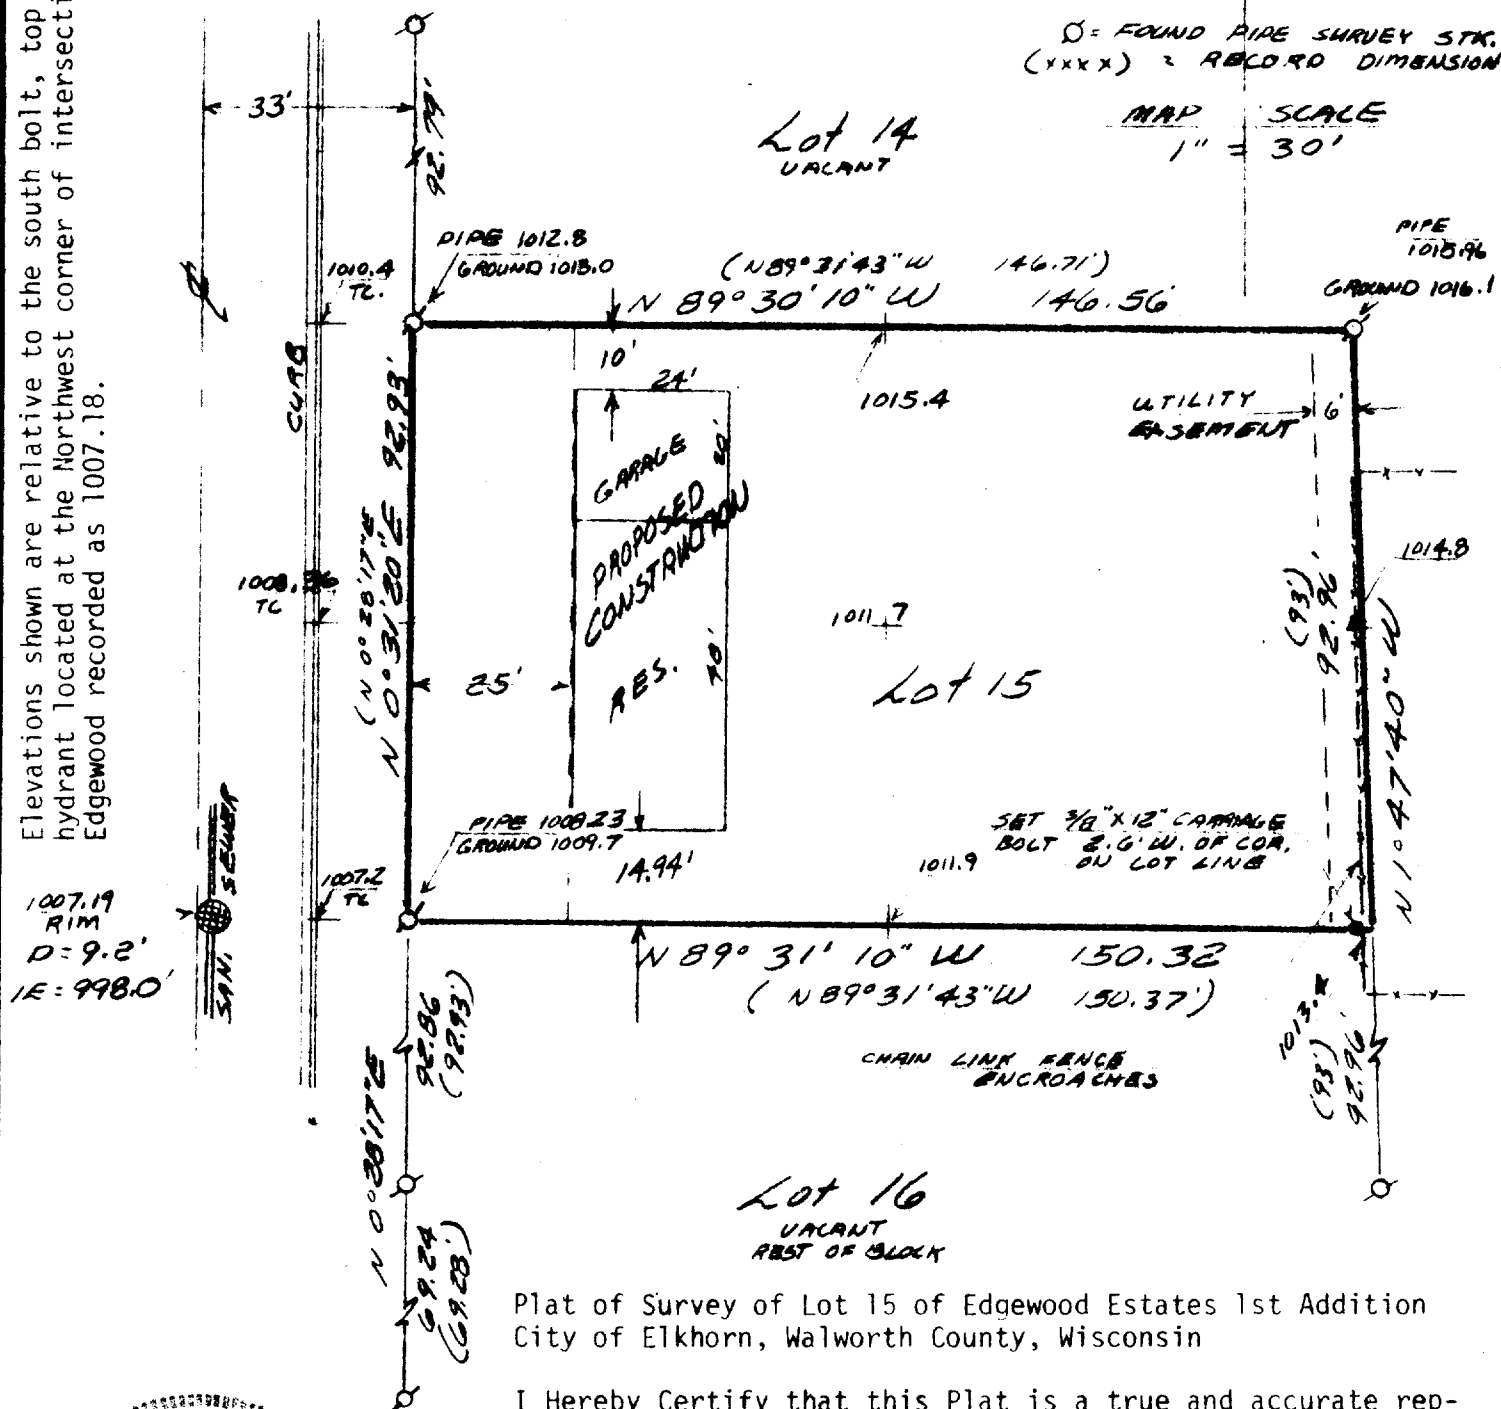

Plat of Survey of Lot 15 of Edgewood Estates 1st Addition
City of Elkhorn, Walworth County, Wisconsin

I Hereby Certify that this Plat is a true and accurate representation of the lot lines and of the elevations shown to the best of my professional knowledge and belief.

Robert A. Farris RLS
20 Apr 1983

DRAWING NUMBER 2093

