


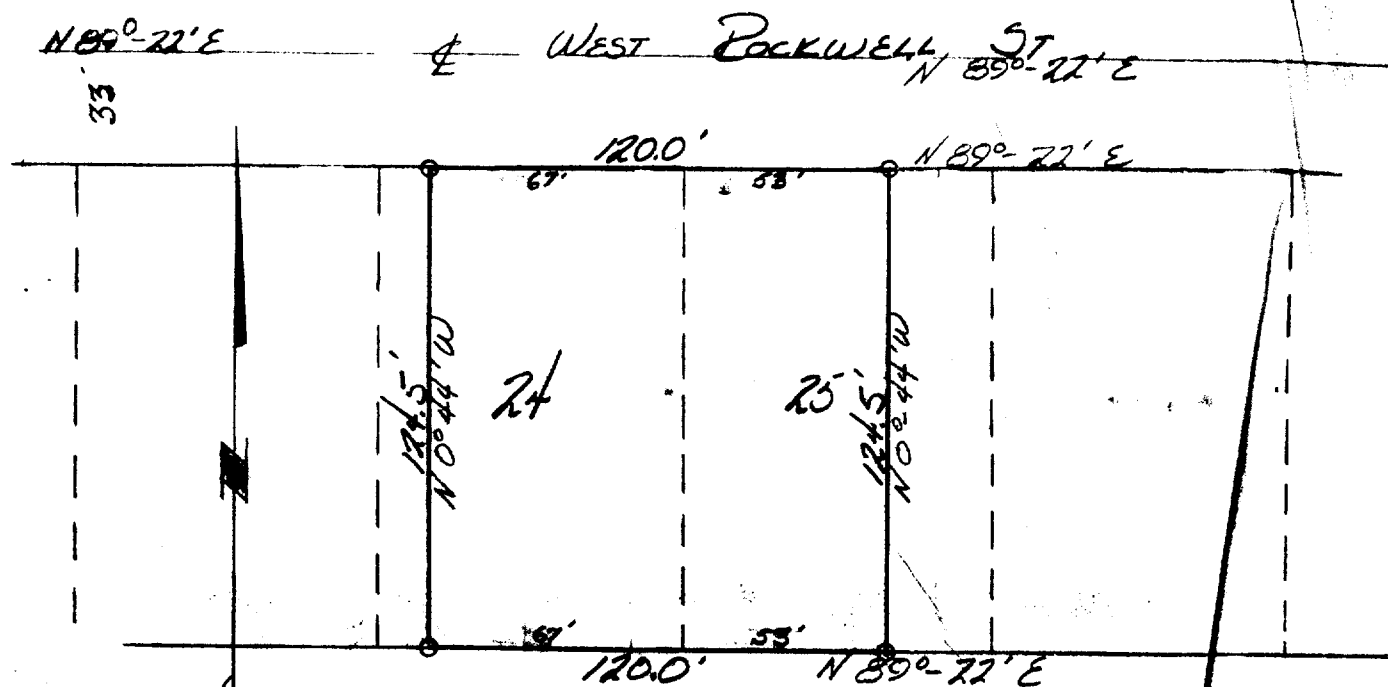

DESCRIPTION: The east 67 feet of lot 24 and the west 53 feet of lot 25 of James Jones Addition to the City of Elkhorn, Walworth County, Wisconsin.

CERTIFICATE: I, hereby certify that on this 4th day of August 1958, have surveyed the above described property according to the official plat on file in the office of the Recorder of Deeds in and for the Walworth County, Wisconsin, and find that the measurements and bearings of the boundary lines taken at the site on this day substantially agree with those on the above plat, and that no encroachments exist.

SIGNED AND SEALED ON THIS THE 4TH DAY OF AUGUST 1958



James F. Bagi
Land Surveyor (27)

VJA-24