



PLAT OF SURVEY OF LOTS 11, 12 AND 15, OF  
BLOCK 3, PRESTONS ADDITION TO THE CITY  
OF ELKHORN, WALWORTH COUNTY, WIS.

I CERTIFY THAT I HAVE SURVEYED THE DESCRIBED PROPERTY  
AND THAT THE PLAT SHOWN HEREON IS AN ACCURATE SURVEY  
A TRUE REPRESENTATION THEREOF & CORRECTLY SHOW THE  
BOUNDARY LINES OF SAID PROPERTY.

JULY 28, 1987

*Thomas P. A. Jensen*

THOMAS P. A. JENSEN  
JENSEN SURVEYING & MAPPING  
P.O. BOX 322  
ELKHORN, WISCONSIN 53124

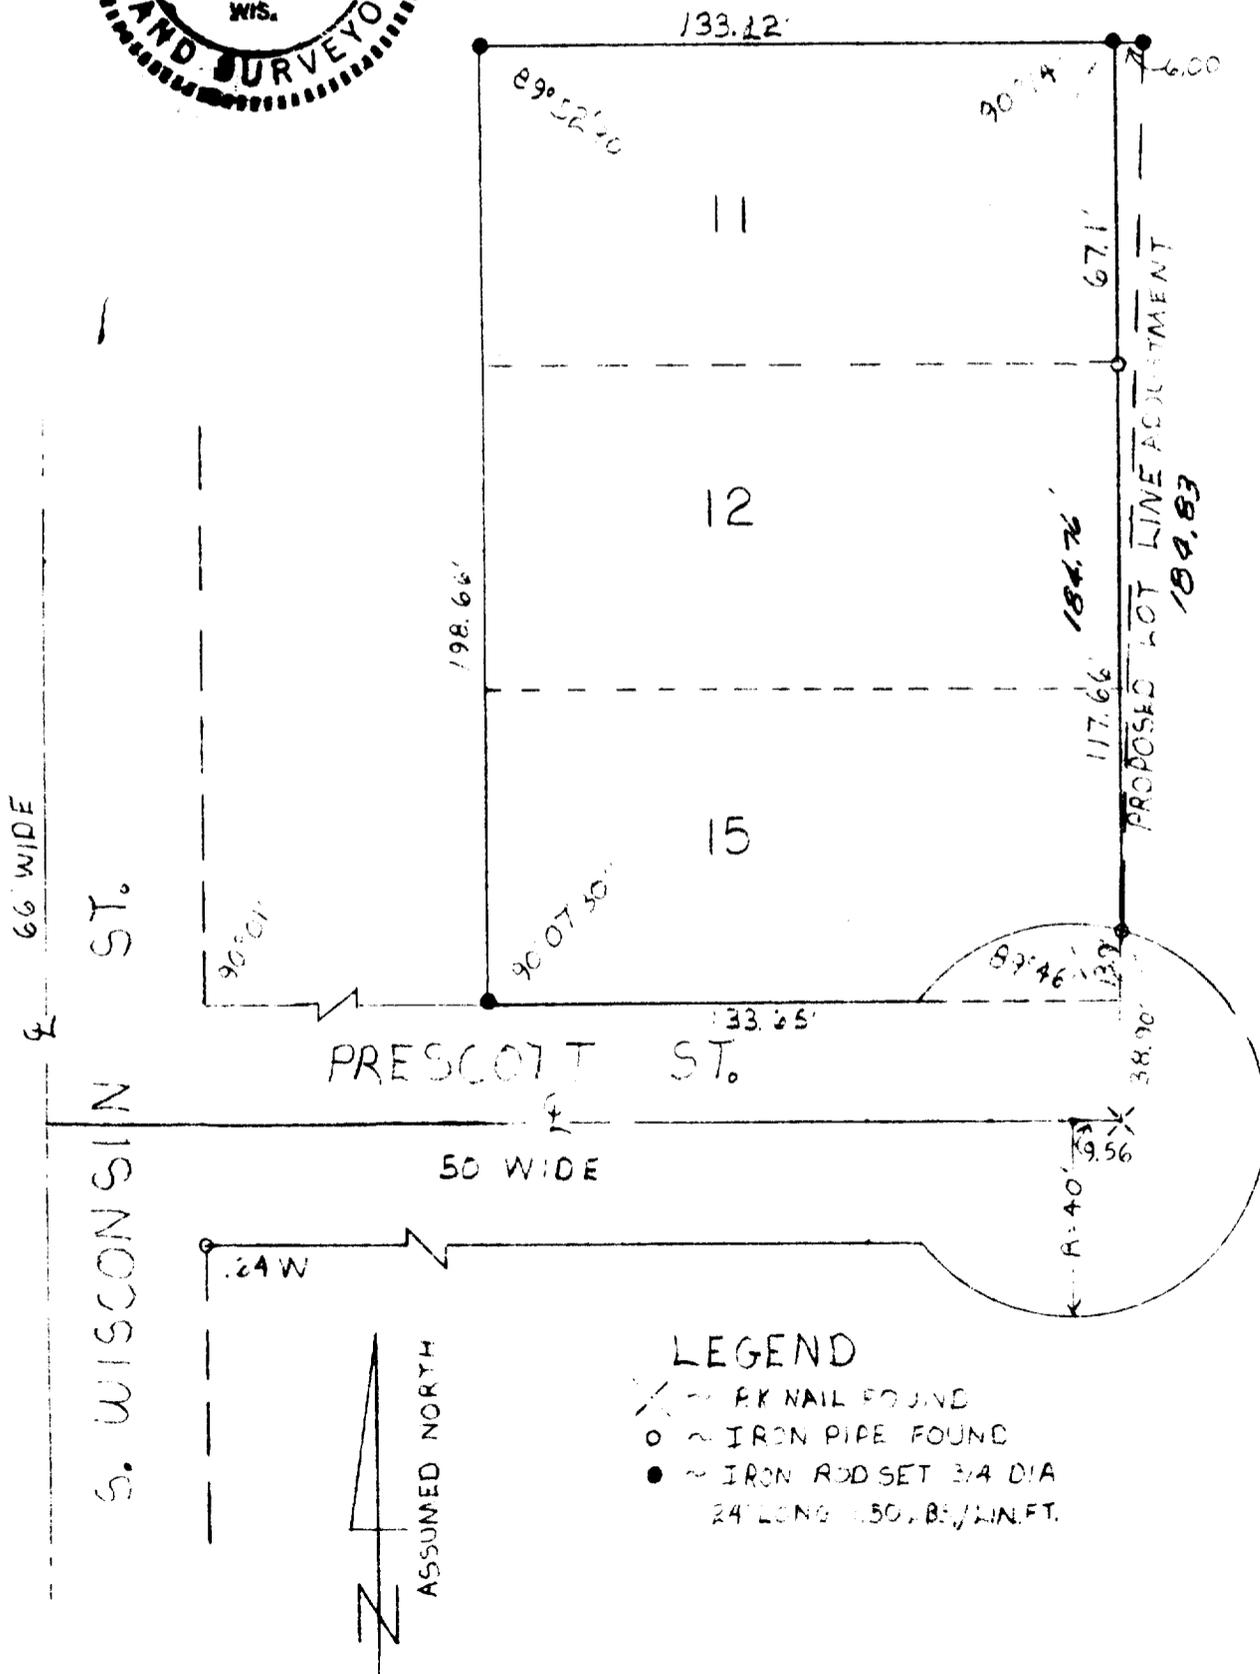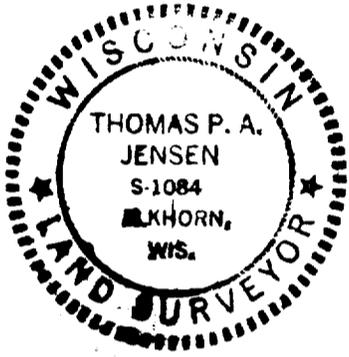

SCALE 1" = 40'

1980.032