


KOLB LAND CONSULTING, INC.
LAND SURVEYING • SUBDIVIDING • LAND PLANNING

LAKE GENEVA, WISCONSIN 53147

WHITEWATER, WISCONSIN 53190

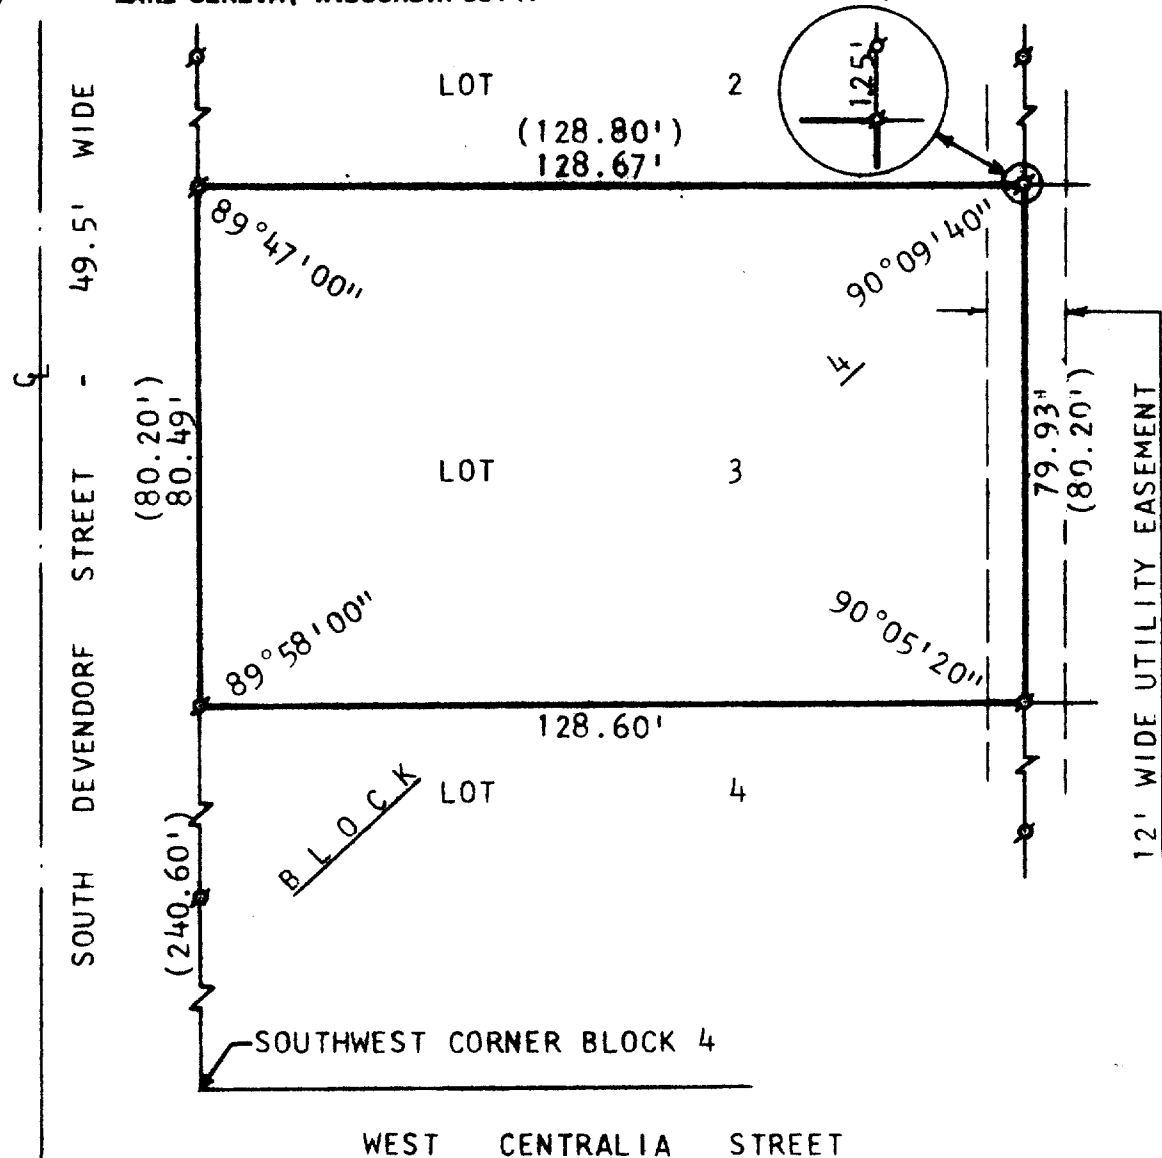

PLAT OF SURVEY OF

LOT 3, BLOCK 4, JAMES JONES 2ND
ADDITION, CITY OF ELKHORN, WALWORTH
COUNTY, WISCONSIN.



ORDERED BY: SORENSEN & JOHNSON CORPORATION
433 BROAD STREET
LAKE GENEVA, WI 53147



SCALE : 1"=30'
LEGEND

- ⊙ - IRON PIPE FOUND
- - IRON PIPE PLACED
- () - AS PLATTED

I, HAROLD H. KOLB, DO HEREBY CERTIFY THAT I HAVE
SURVEYED THE PROPERTY HEREON DESCRIBED ACCORDING
TO THE OFFICIAL RECORDS, AND THAT THE PLAT HEREON
IS A CORRECT REPRESENTATION OF THE LOT LINES TO THE
BEST OF MY KNOWLEDGE AND BELIEF.

Harold H. Kolb

HAROLD H. KOLB
WISCONSIN REGISTERED LAND SURVEYOR, S-187

DATE Aug 28, 1979