


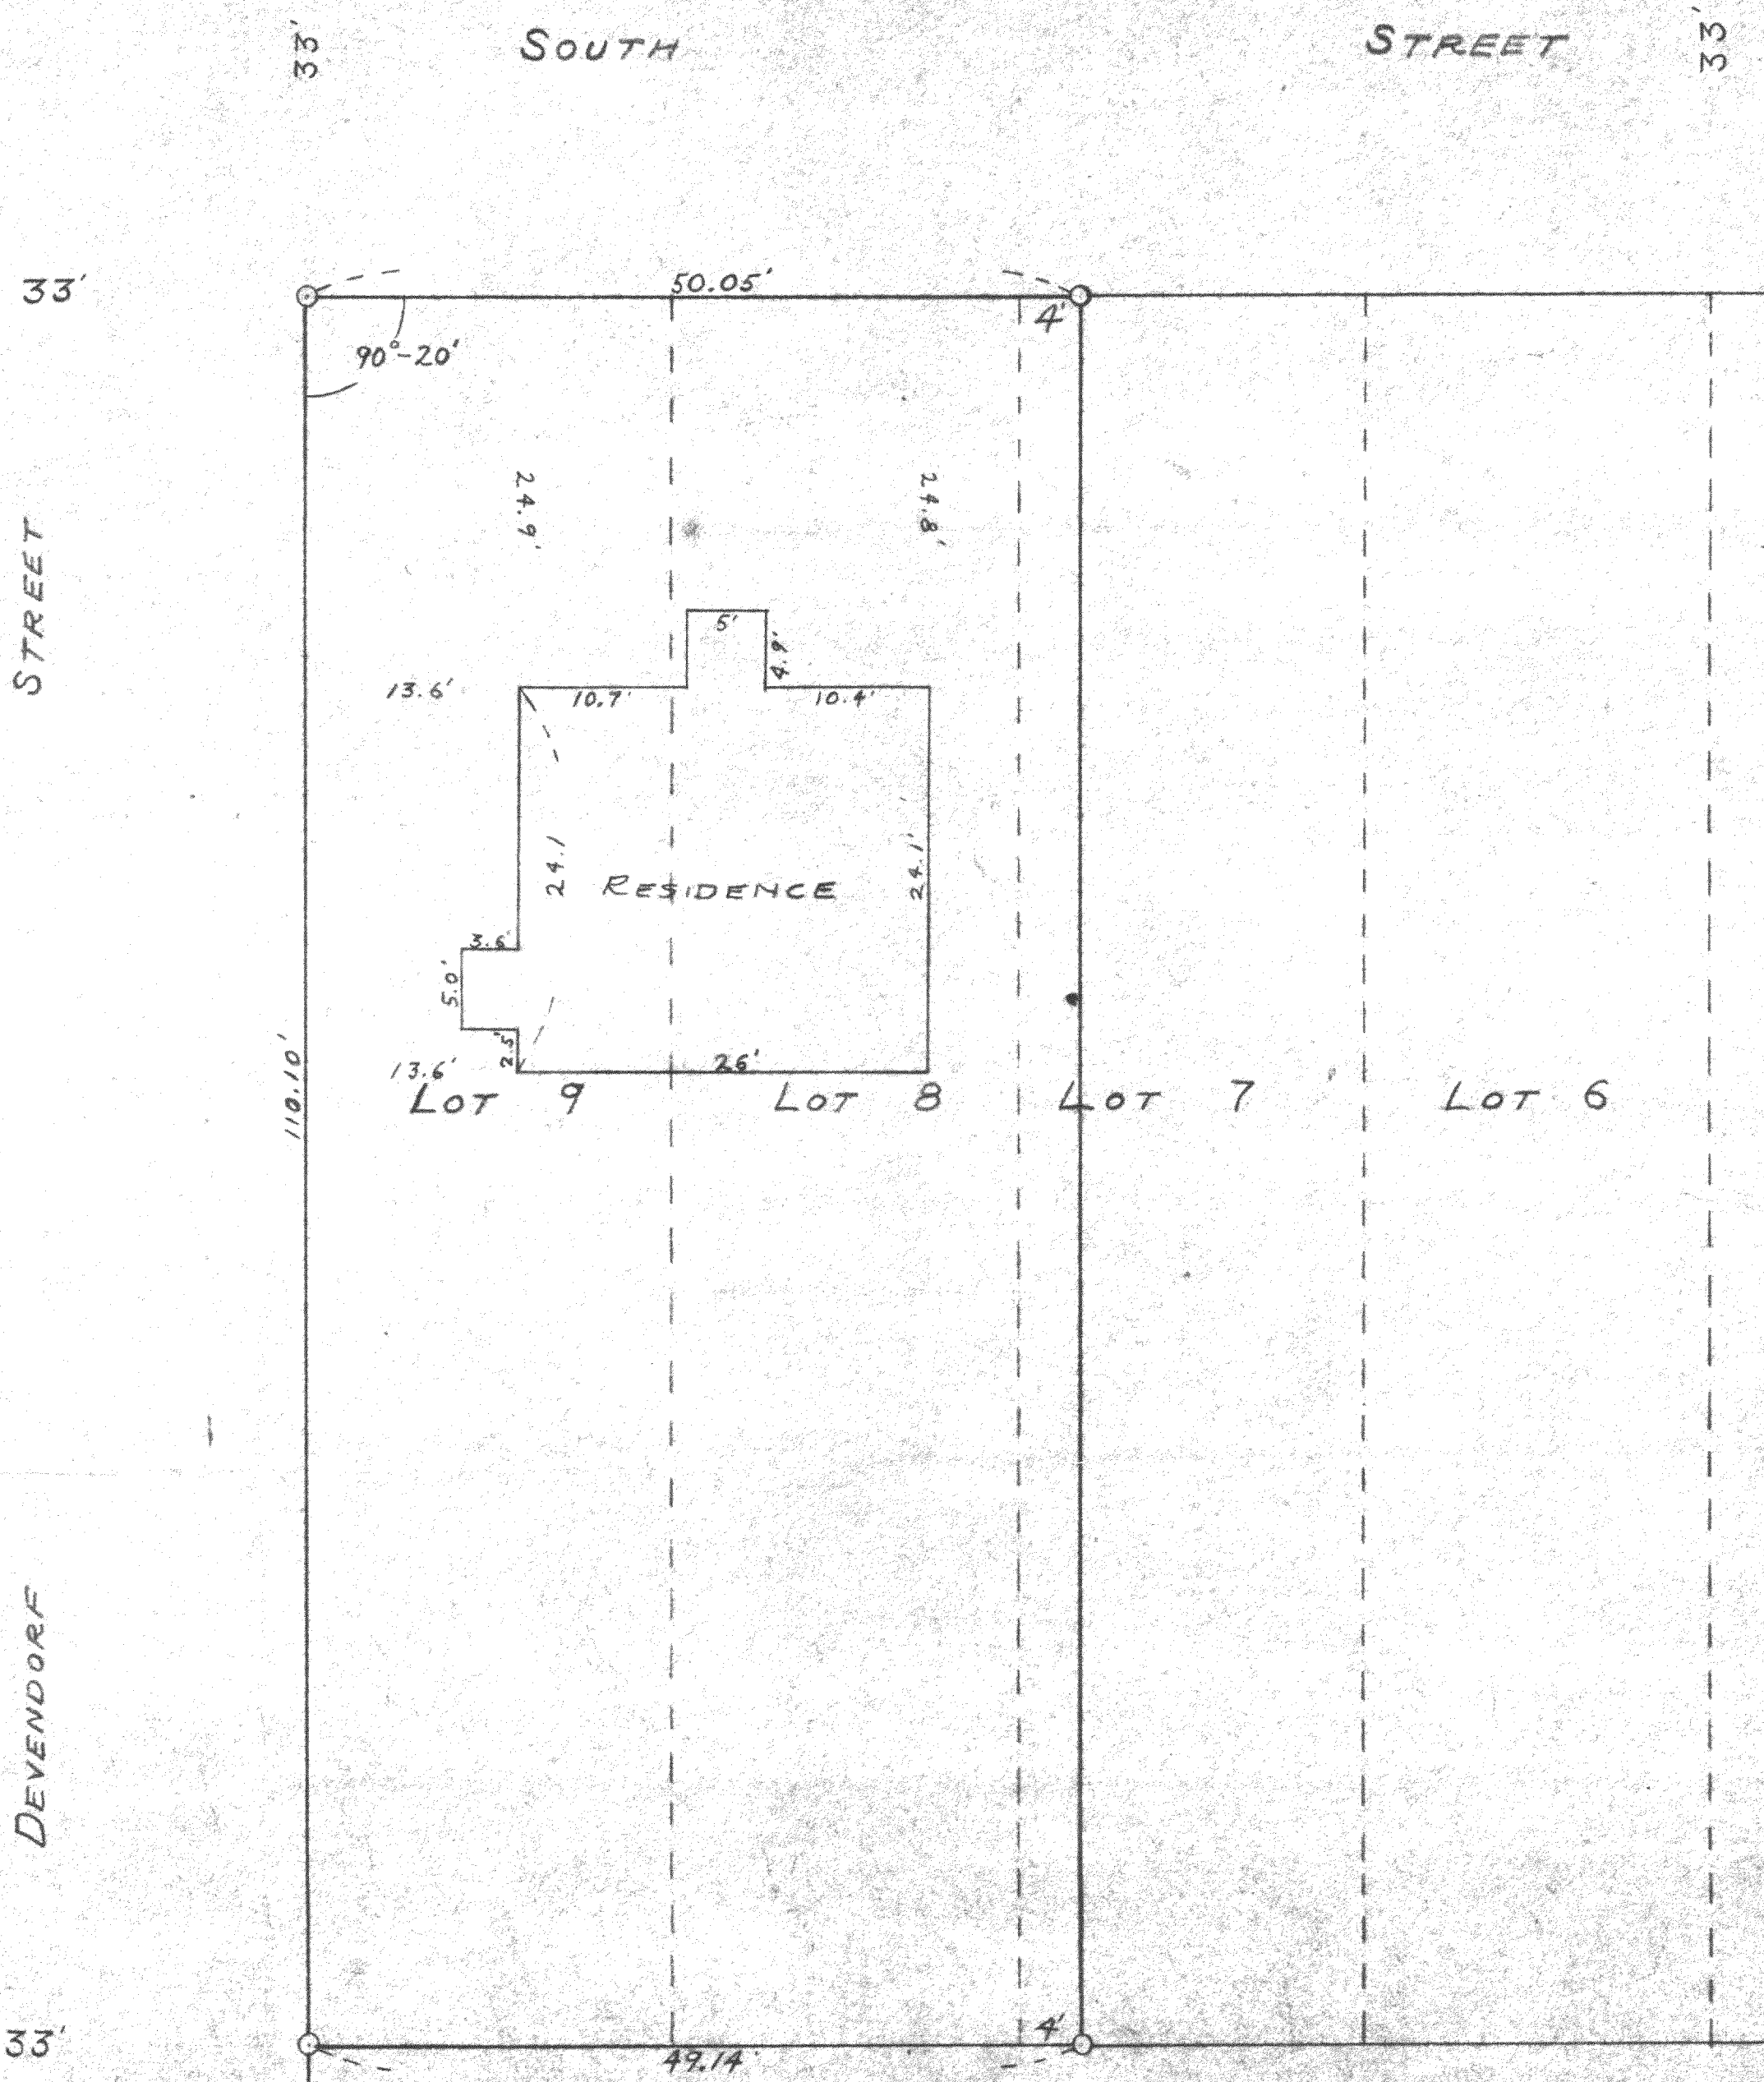

SCALE 1" = 10'
O = IRON STAKE

VEN 17C

PLAT OF SURVEY OF THE WEST 4' OF LOT 7 AND
LOTS 8 AND 9, BLOCK 3 IN ELKHORN GARDENS; LOCATED
IN THE CITY OF ELKHORN WALWORTH COUNTY, WISCONSIN
APRIL 3, 1952

Lloyd L. Jensen
COUNTY SURVEYOR

4-32