


0000-4

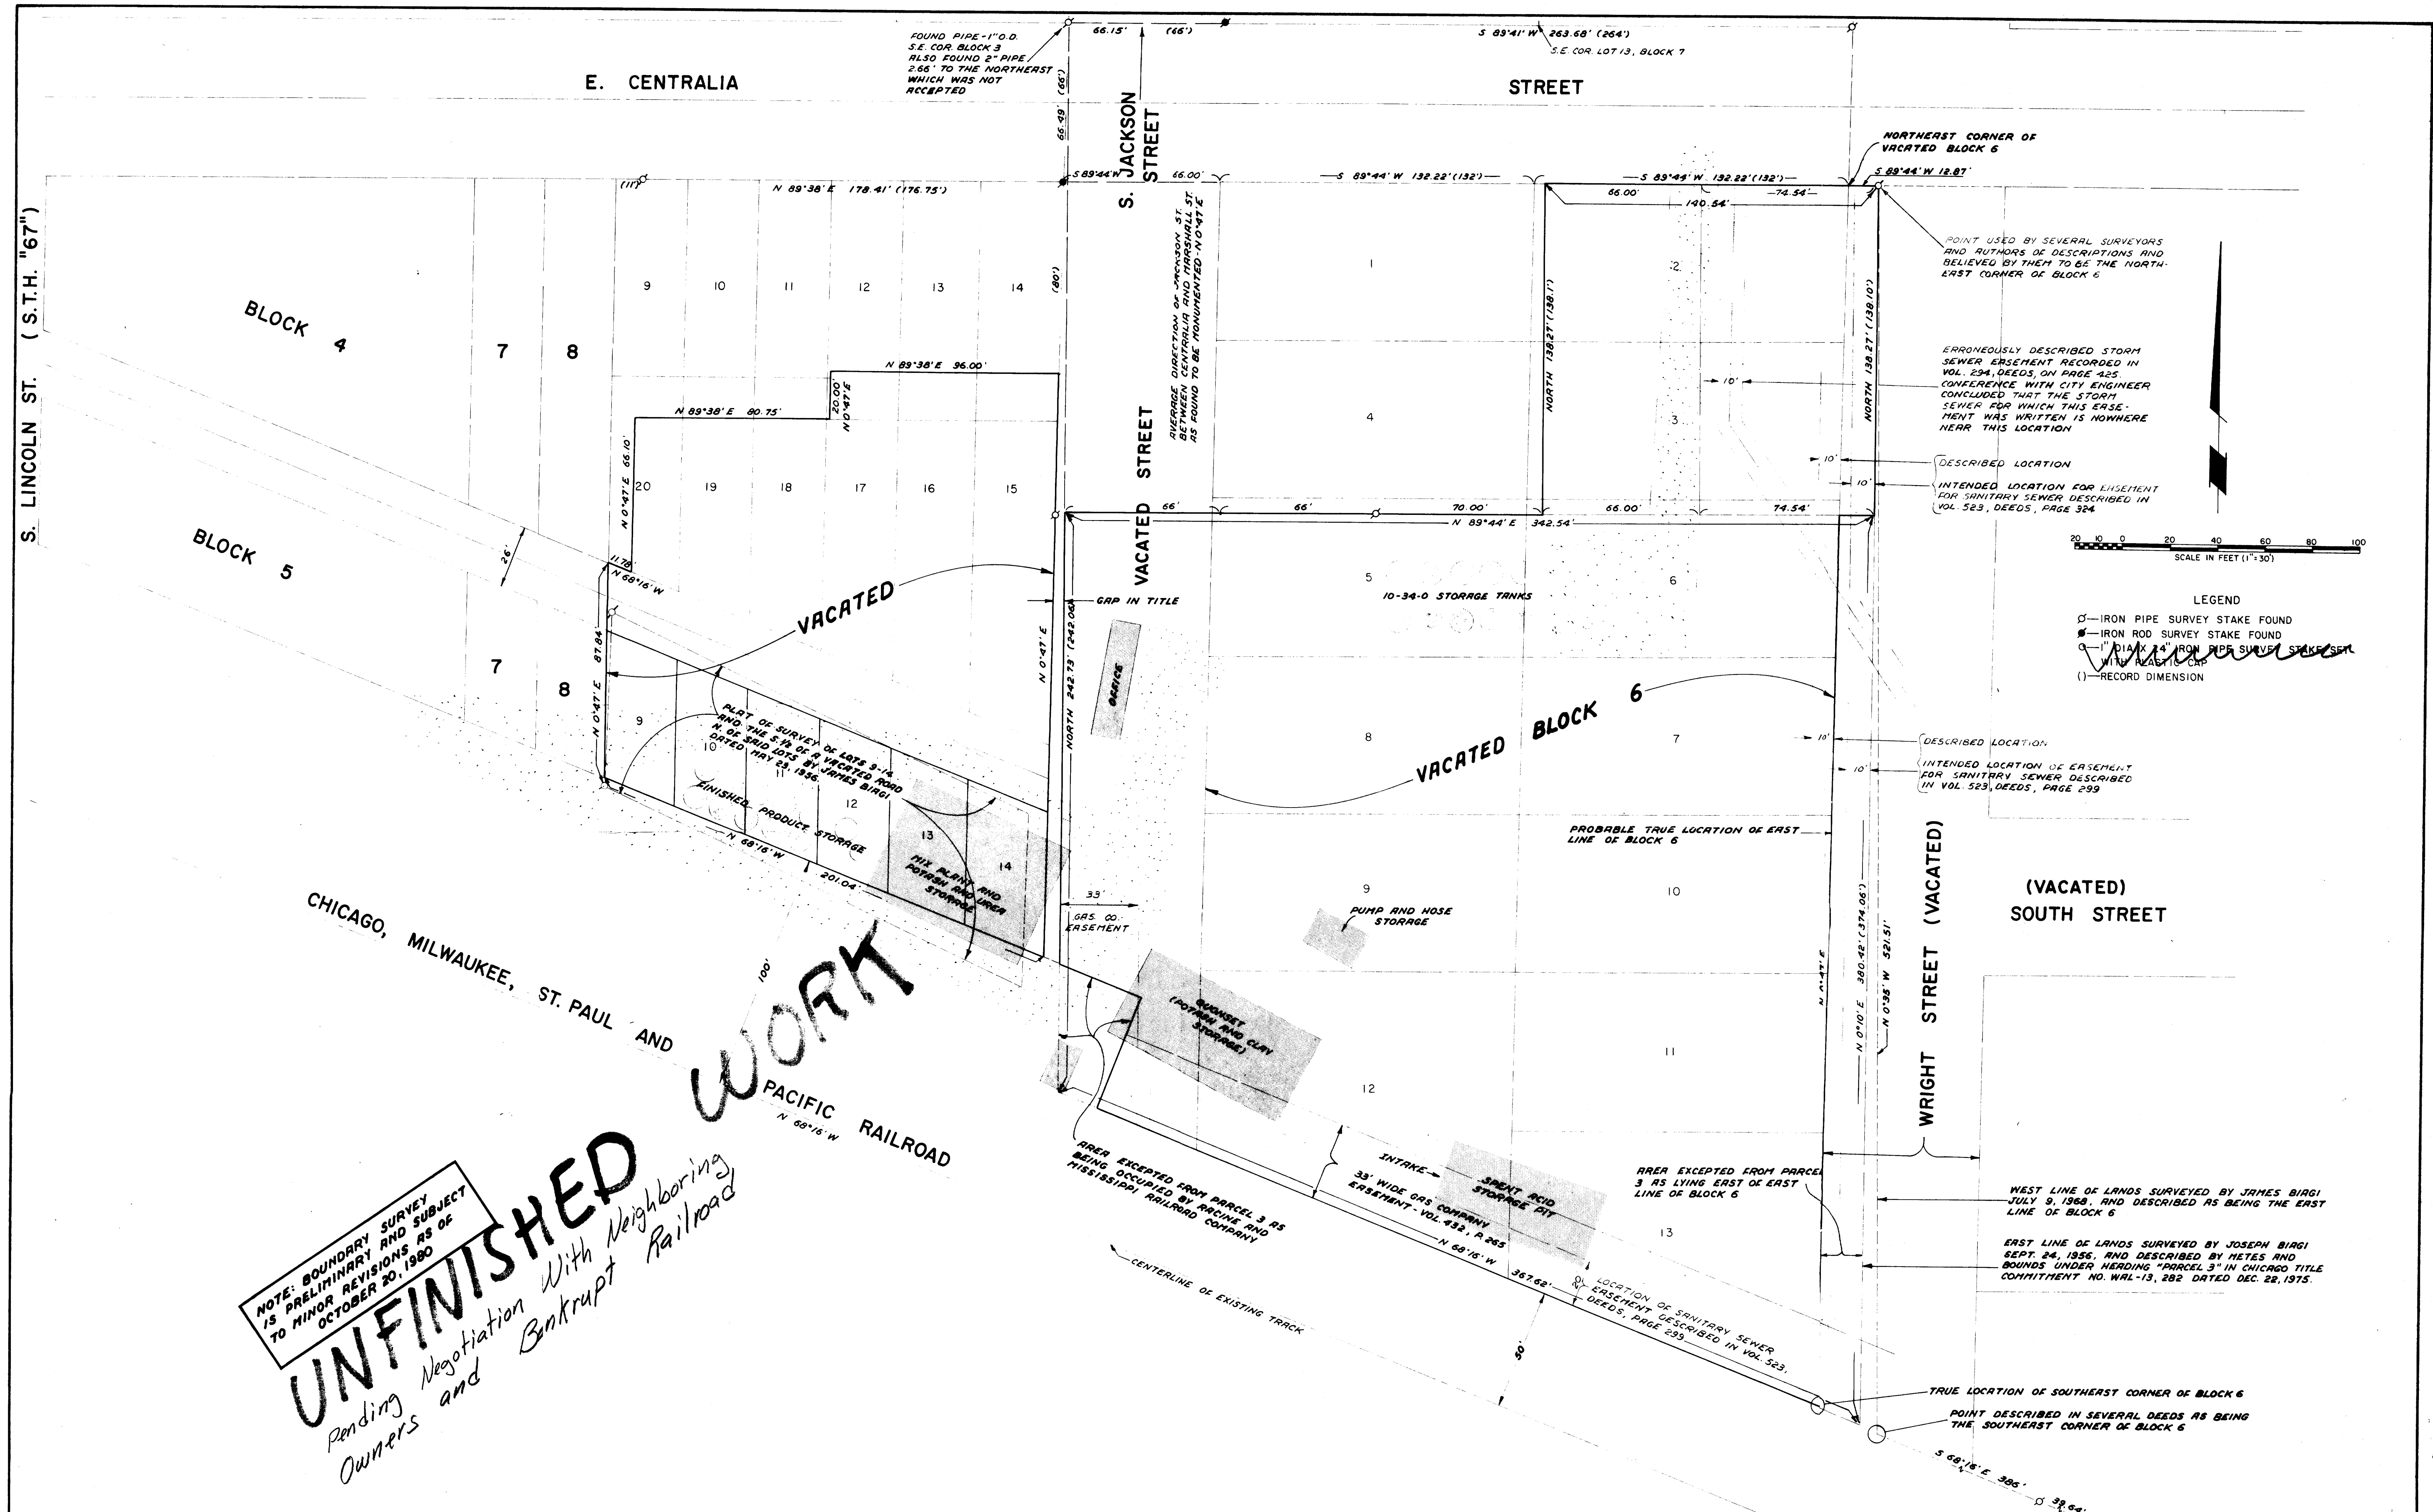


NOTE: BOUNDARY SURVEY IS PRELIMINARY AND SUBJECT TO MINOR REVISIONS AS OF OCTOBER 20, 1980

UNFINISHED

Pending Negotiation With Neighboring Owners and Bankrupt Railroad

DATE	DRAWN BY	REVISIONS	BY	DATE
AUG. 21, 1980	R. FARRIS			
	CHECKED BY			
	APPROVED BY			
	R. FARRIS			

SCALE	1" = 30'
-------	----------

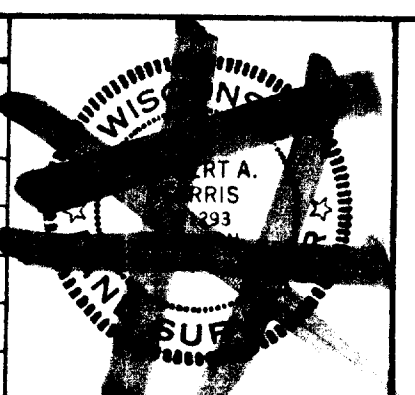

FARRIS, HANSEN & COOPER, INC.

ENGINEERING, SURVEYING & LAND PLANNING

715 W. WALWORTH ST.-BOX 487-ELKHORN, WI 53121
PHONE: 414-723-2098

PLAT OF SURVEY	PROJECT NO.
ELKO FERTILIZER COMPANY LANDS	1721
	SHEET NO.
	1 OF 1