


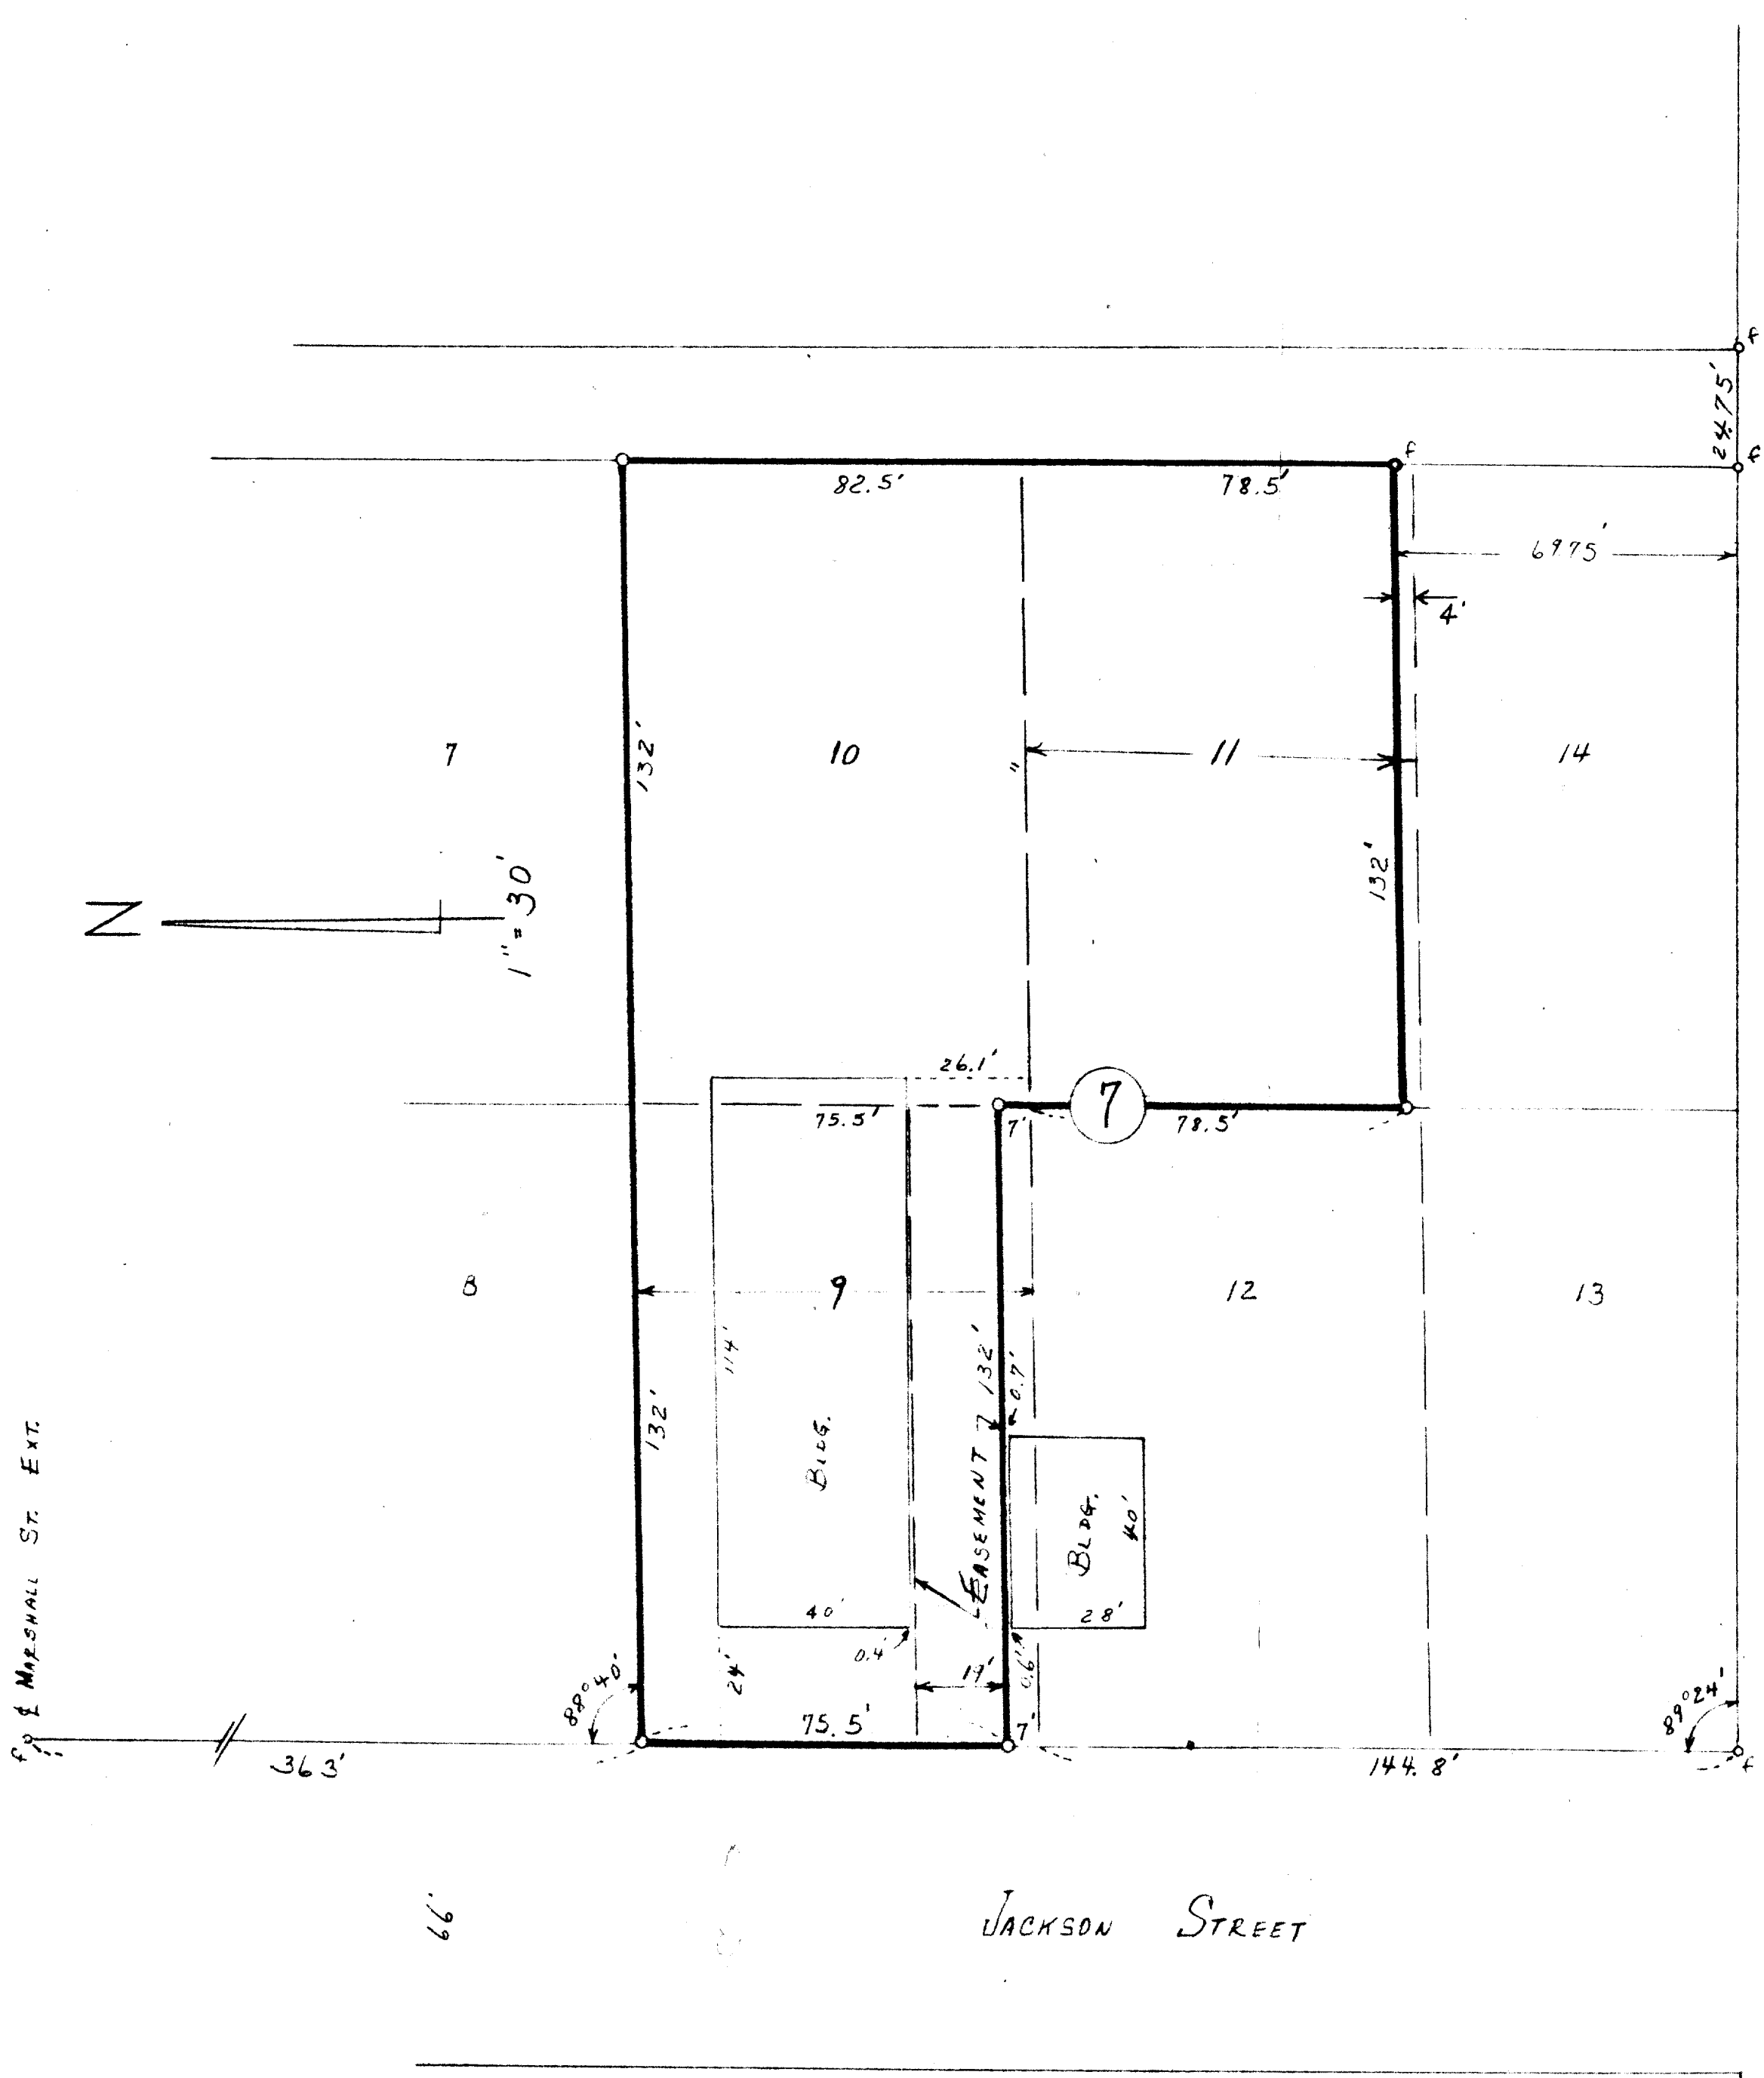

PLAT OF SURVEY
 OF LOTS 9, 10,
 & 11 of BLOCK
 7 of ELDERKINS
 ADDITION, CITY OF
 ELKHORN, WALWORTH
 COUNTY, WISCONSIN.

Charles Shick
 Nov. '81

FE/IRON PIPE FOUND
 O=IRON PIPE SET

