


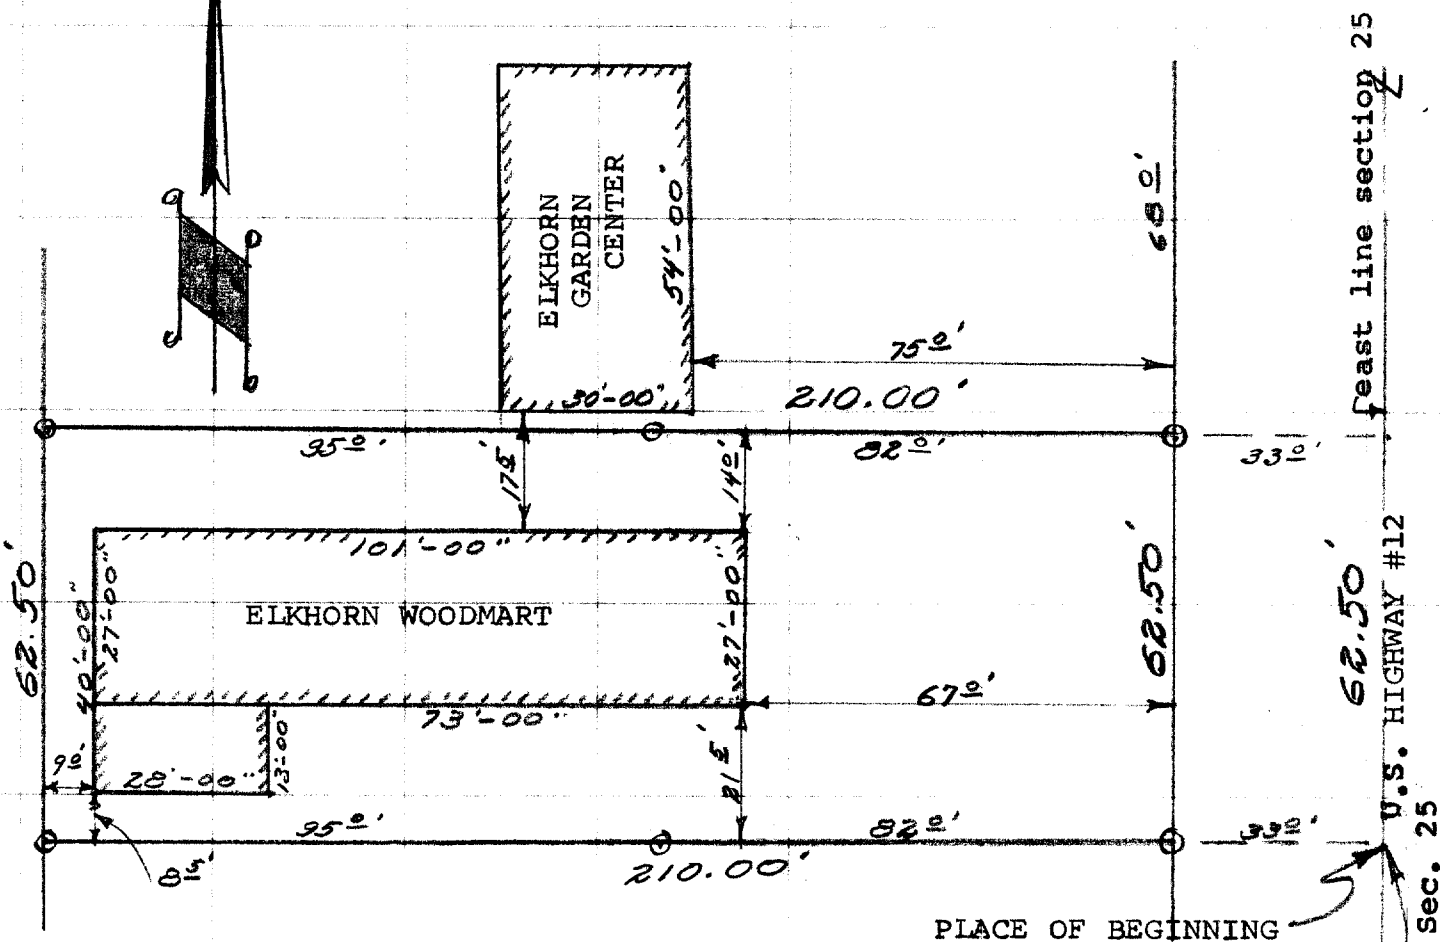

○ Indicates, Iron Pipe

DESCRIPTION:

Commencing at a point in the east line of Section 25, Town 3 north, Range 16 east, which is 635.60 feet North of the southeast corner of said section, thence North 62.50 feet, thence West 210.00 feet, thence South 62.50 feet, thence 210.00 feet to the place of beginning.

CERTIFICATE:

I, James F. Biagi, surveyor do hereby certify that I have surveyed the property hereon described on this the 29th day of July, 1968.

Dated July 22nd 1968.

James F. Biagi
 RLS. 272
 Elkhorn, Wisconsin.