


Rural - Residential - Commercial

SURVEYING & PLANNING
SUBDIVISIONS - LOT SURVEYS
CONSTRUCTION STAKING - MAPPING

LOT 9 OF EDGEWOOD ESTATES FIRST ADDITION TO THE CITY OF ELKHORN
WALWORTH COUNTY WISCONSIN

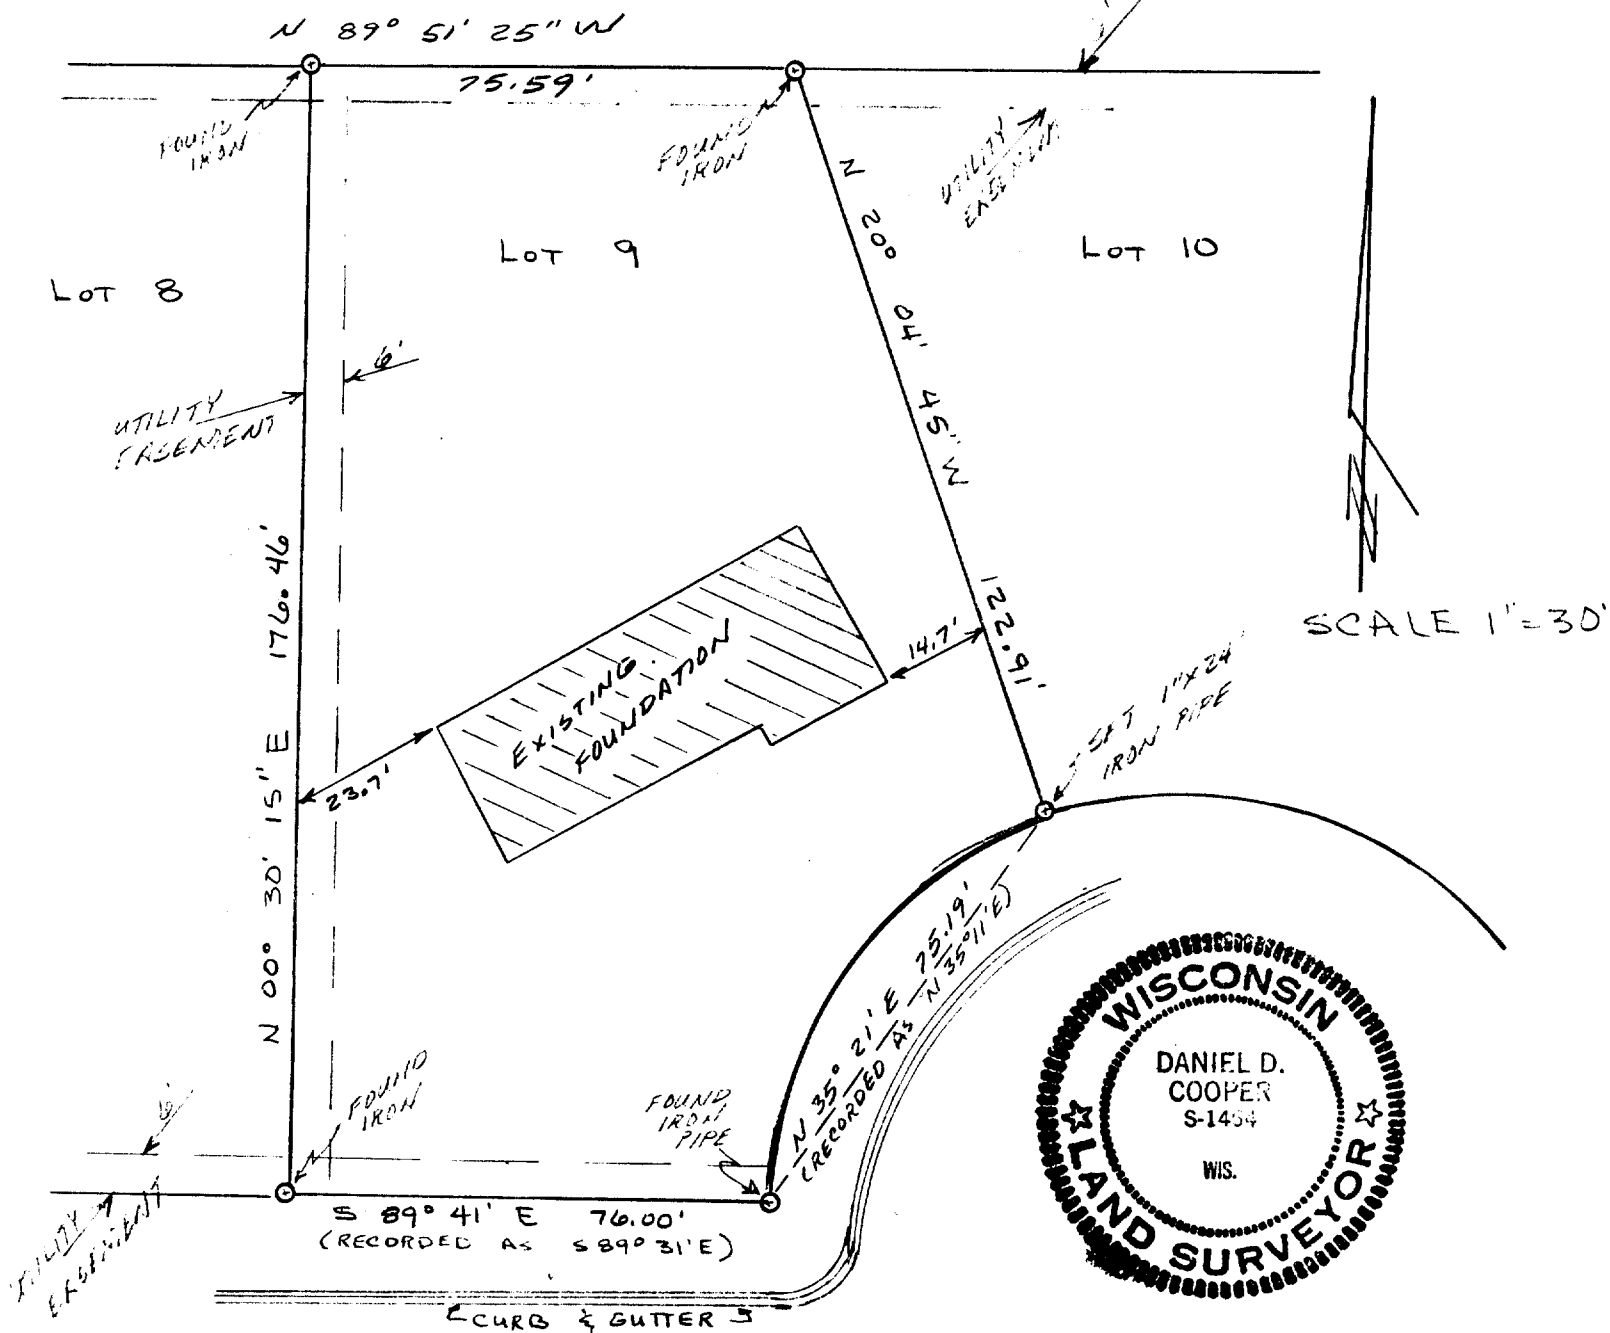

OWNEF
PAT ROMENESKO

ESTATE COURT

I, DANIEL D. COOPER, REGISTERED SURVEYOR, DO HEREBY CERTIFY THAT I HAVE SURVEYED THE PROPERTY DESCRIBED HEREON AND THAT THE MAP SHOWN HEREON IS A TRUE AND ACCURATE REPRESENTATION THEREOF TO THE BEST OF MY PROFESSIONAL KNOWLEDGE AND BELIEF.

DATED THIS 14 DAY OF DEC. 1983

DANIEL D. COOPER, RLS NO. S-1464