


ENGINEERING, SURVEYING AND LAND PLANNING
715 W WALWORTH ST. - P.O. BOX 487 - ELKHORN, WI 53121
OFFICE: 414/723-2098

WORK ORDERED BY:
BETH SMITH

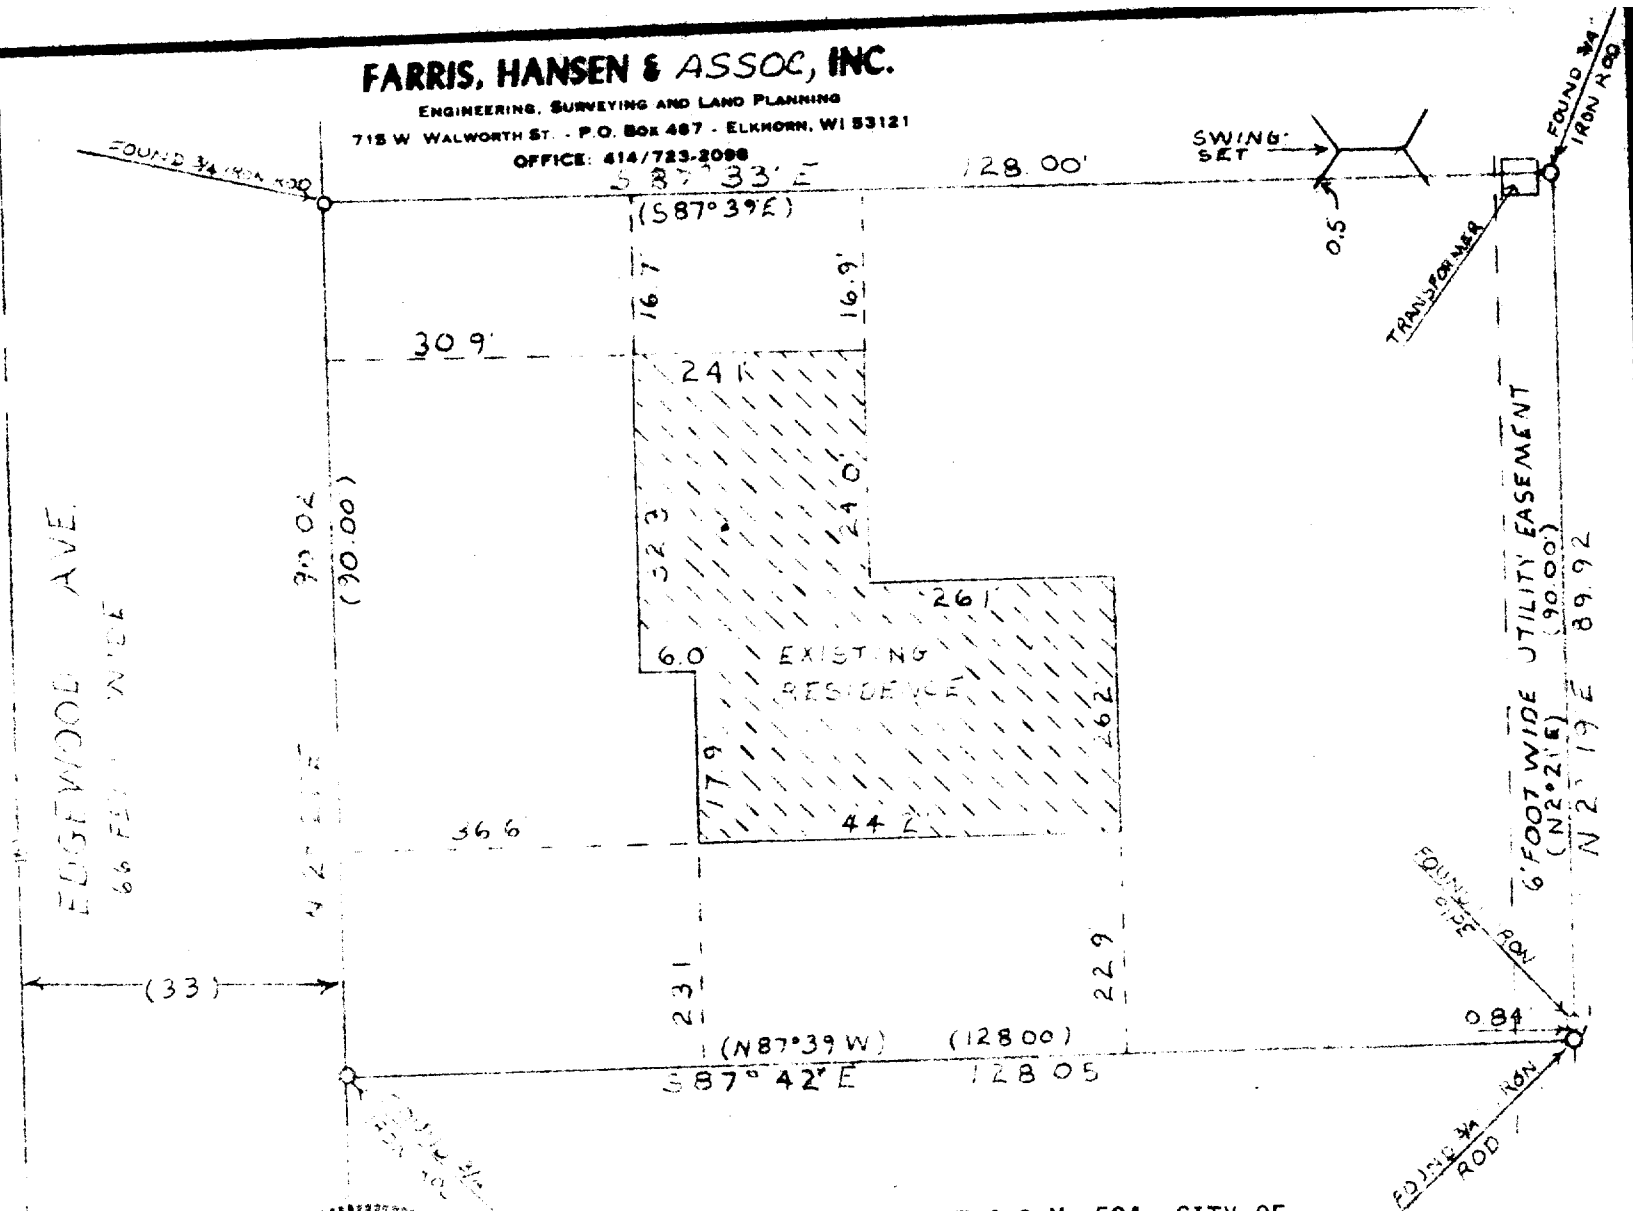

I hereby certify that this plat of survey is a true and accurate representation of the lot lines and building location to the best of my professional knowledge and belief.

DRAWING NUMBER 2037

4-335-F

✓ A 574-3