


JENSEN SURVEYING & MAPPING, S.C.
P.O. BOX 322
ELKHORN, WI. 53121

WASHINGTON STREET

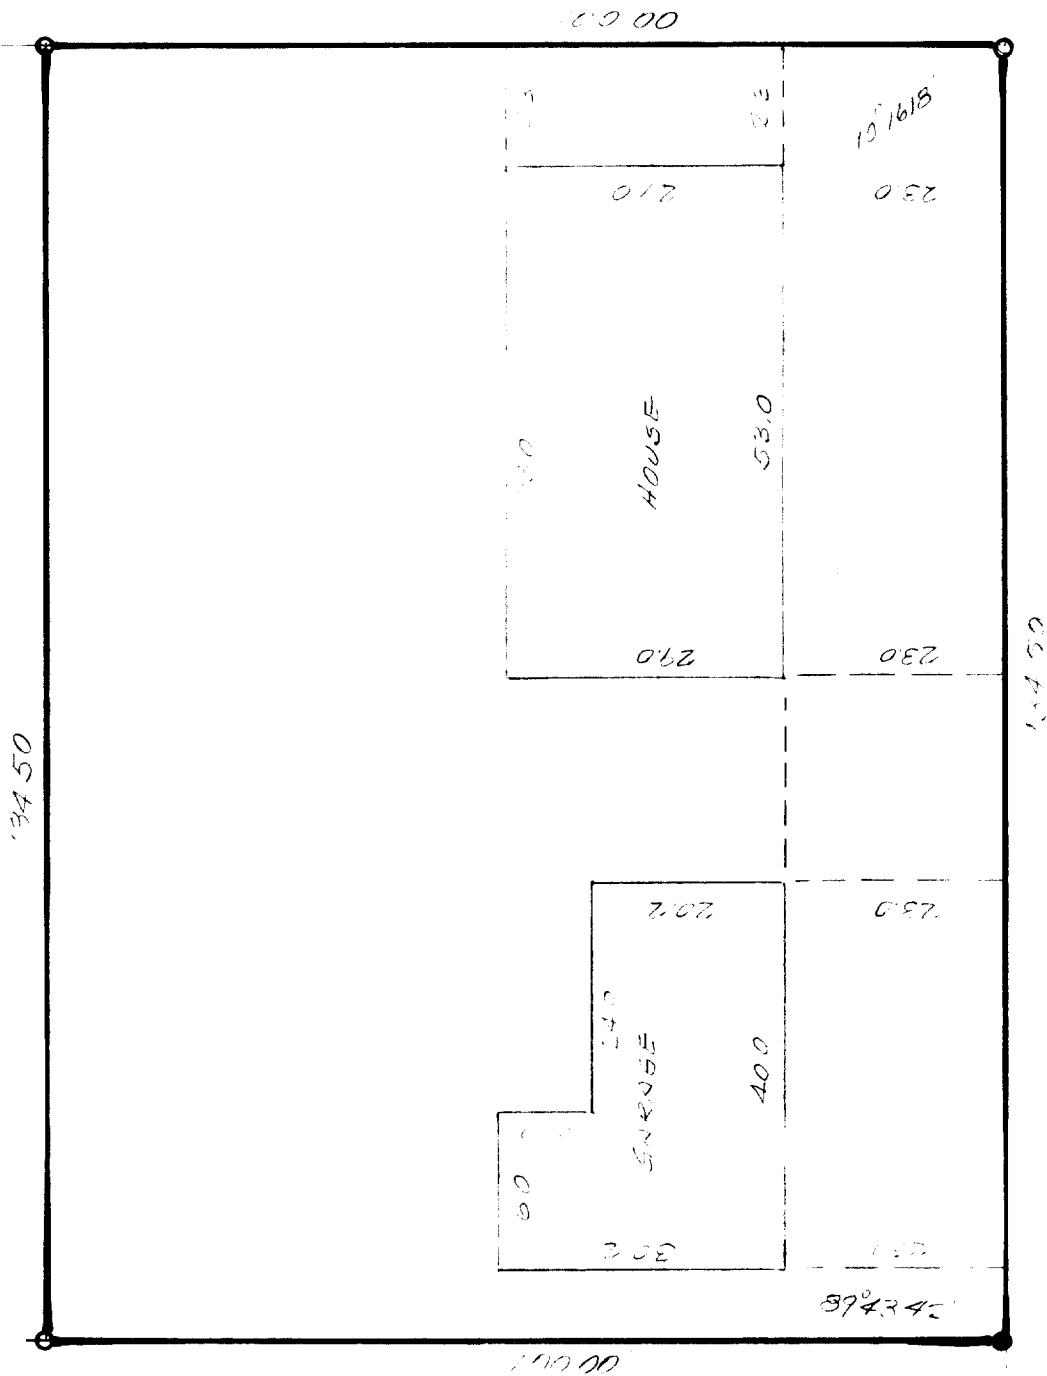

PLAT OF SURVEY
OF

A PARCEL OF LAND LOCATED IN THE CITY
OF ELKHORN, WALWORTH COUNTY, WISCONSIN AS
DESCRIBED IN VOL. 79 PAGE 443 OF RECORDS.

HEREBY CERTIFY THAT I HAVE SURVEYED THE ABOVE
DESCRIBED PROPERTY THAT THE PLAT SHOWN HEREON
IS AN ACCURATE SURVEY & TRUE REPRESENTATION
THEREOF. CORRECTLY SHOWS THE EXTERIOR BOUNDARY
LINES ON EACH CORNER AND THE CORRECT MEASUREMENTS
THEREOF AND BUILDINGS THEREON.



SCALE - 1" = 20'

- IRON PIPE FOUND
 - CONCRETE MONUMENT FOUND
- MAY 18 1983

THOMAS P. JENSEN, S.C.

1983,020