

KOLB LAND CONSULTING, INC.
LAND SURVEYING • SUBDIVIDING • LAND PLANNING

LAKE GENEVA, WISCONSIN 53147

CSM # 1162

PLAT OF SURVEY OF


A PARCEL OF LAND LOCATED IN BLOCK
1, ELDERKIN ADDITION TO THE CITY
OF ELKHORN AND IN THE NORTHWEST
1/4 OF SECTION 6, T 2 N, R 17 E,
WALWORTH COUNTY, WI.
TAX KEY NO. YEK-8

ORDERED BY: I.D.L. MORTGAGE CORP.
P.O. BOX 1256
KENOSHA, WI. 53141

NOTE: THE PLACEMENT OF MONUMENTS
HAS BEEN WAIVED BY THE
CLIENT AS PERMITTED IN
A-E 5.01(B).


LEGEND

- IRON PIPE FOUND
- IRON ROD FOUND
- (3') RECORDED DISTANCE
- UTILITY POLE

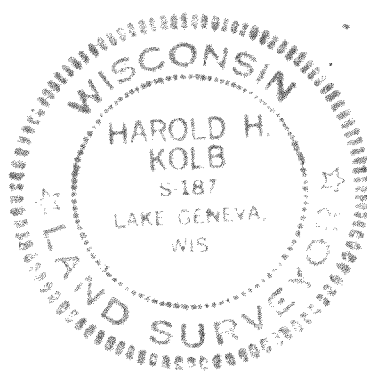

I HEREBY CERTIFY THAT I HAVE SUR-
VEYED THE ABOVE DESCRIBED PROPERTY
AND THAT THE ABOVE MAP IS A TRUE
REPRESENTATION THEREOF AND SHOWS
THE SIZE AND LOCATION OF THE PRO-
PERTY, ITS EXTERIOR BOUNDARIES, THE
LOCATION OF ALL VISIBLE STRUCTURES
AND DIMENSIONS OF ALL PRINCIPAL
BUILDINGS THEREON, BOUNDARY FENCES,
APPARENT EASEMENTS, ROADWAYS AND
VISIBLE ENCROACHMENTS, IF ANY.

THIS SURVEY IS MADE FOR THE USE OF
THE PRESENT OWNERS OF THE PROPERTY,
AND ALSO THOSE WHO PURCHASE, MORT-
GAGE, OR GUARANTEE THE TITLE
THERETO WITHIN ONE (1) YEAR FROM
THE DATE HEREOF.

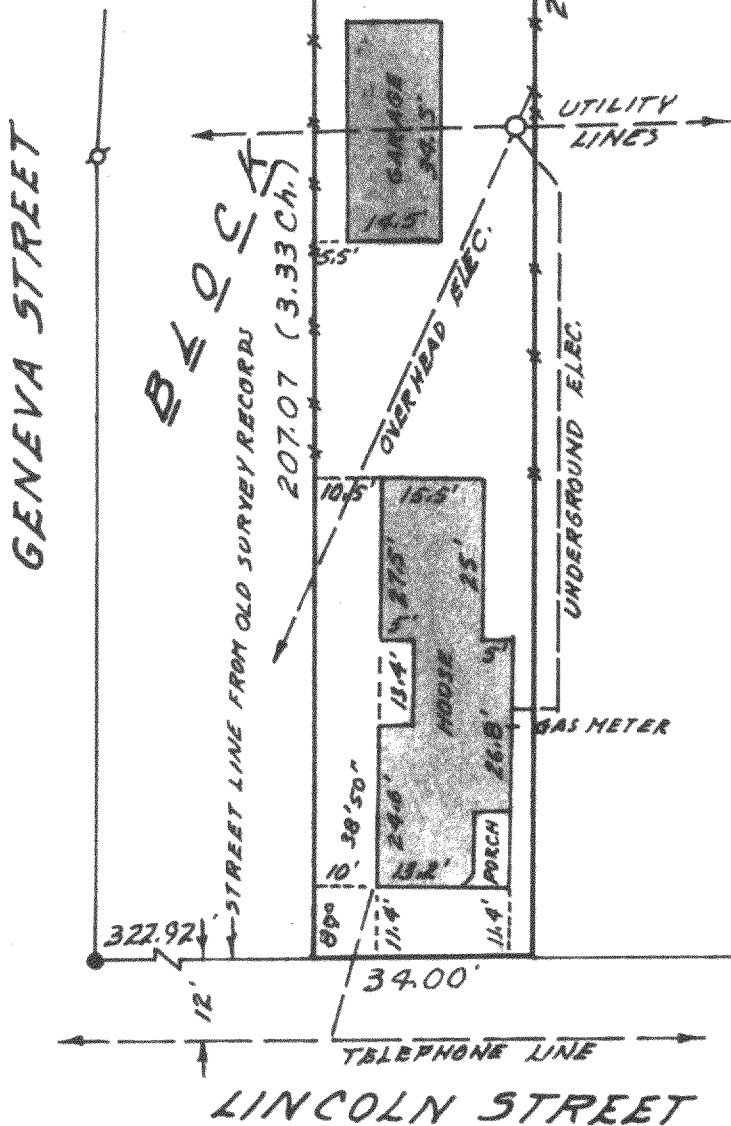

SCALE: 1"=30'

Harold H. Kolb

WISCONSIN REGISTERED LAND SURVEYOR, S- 187
DATE MARCH 14, 1983

YEK-8