


SCALE - 1" = 30'

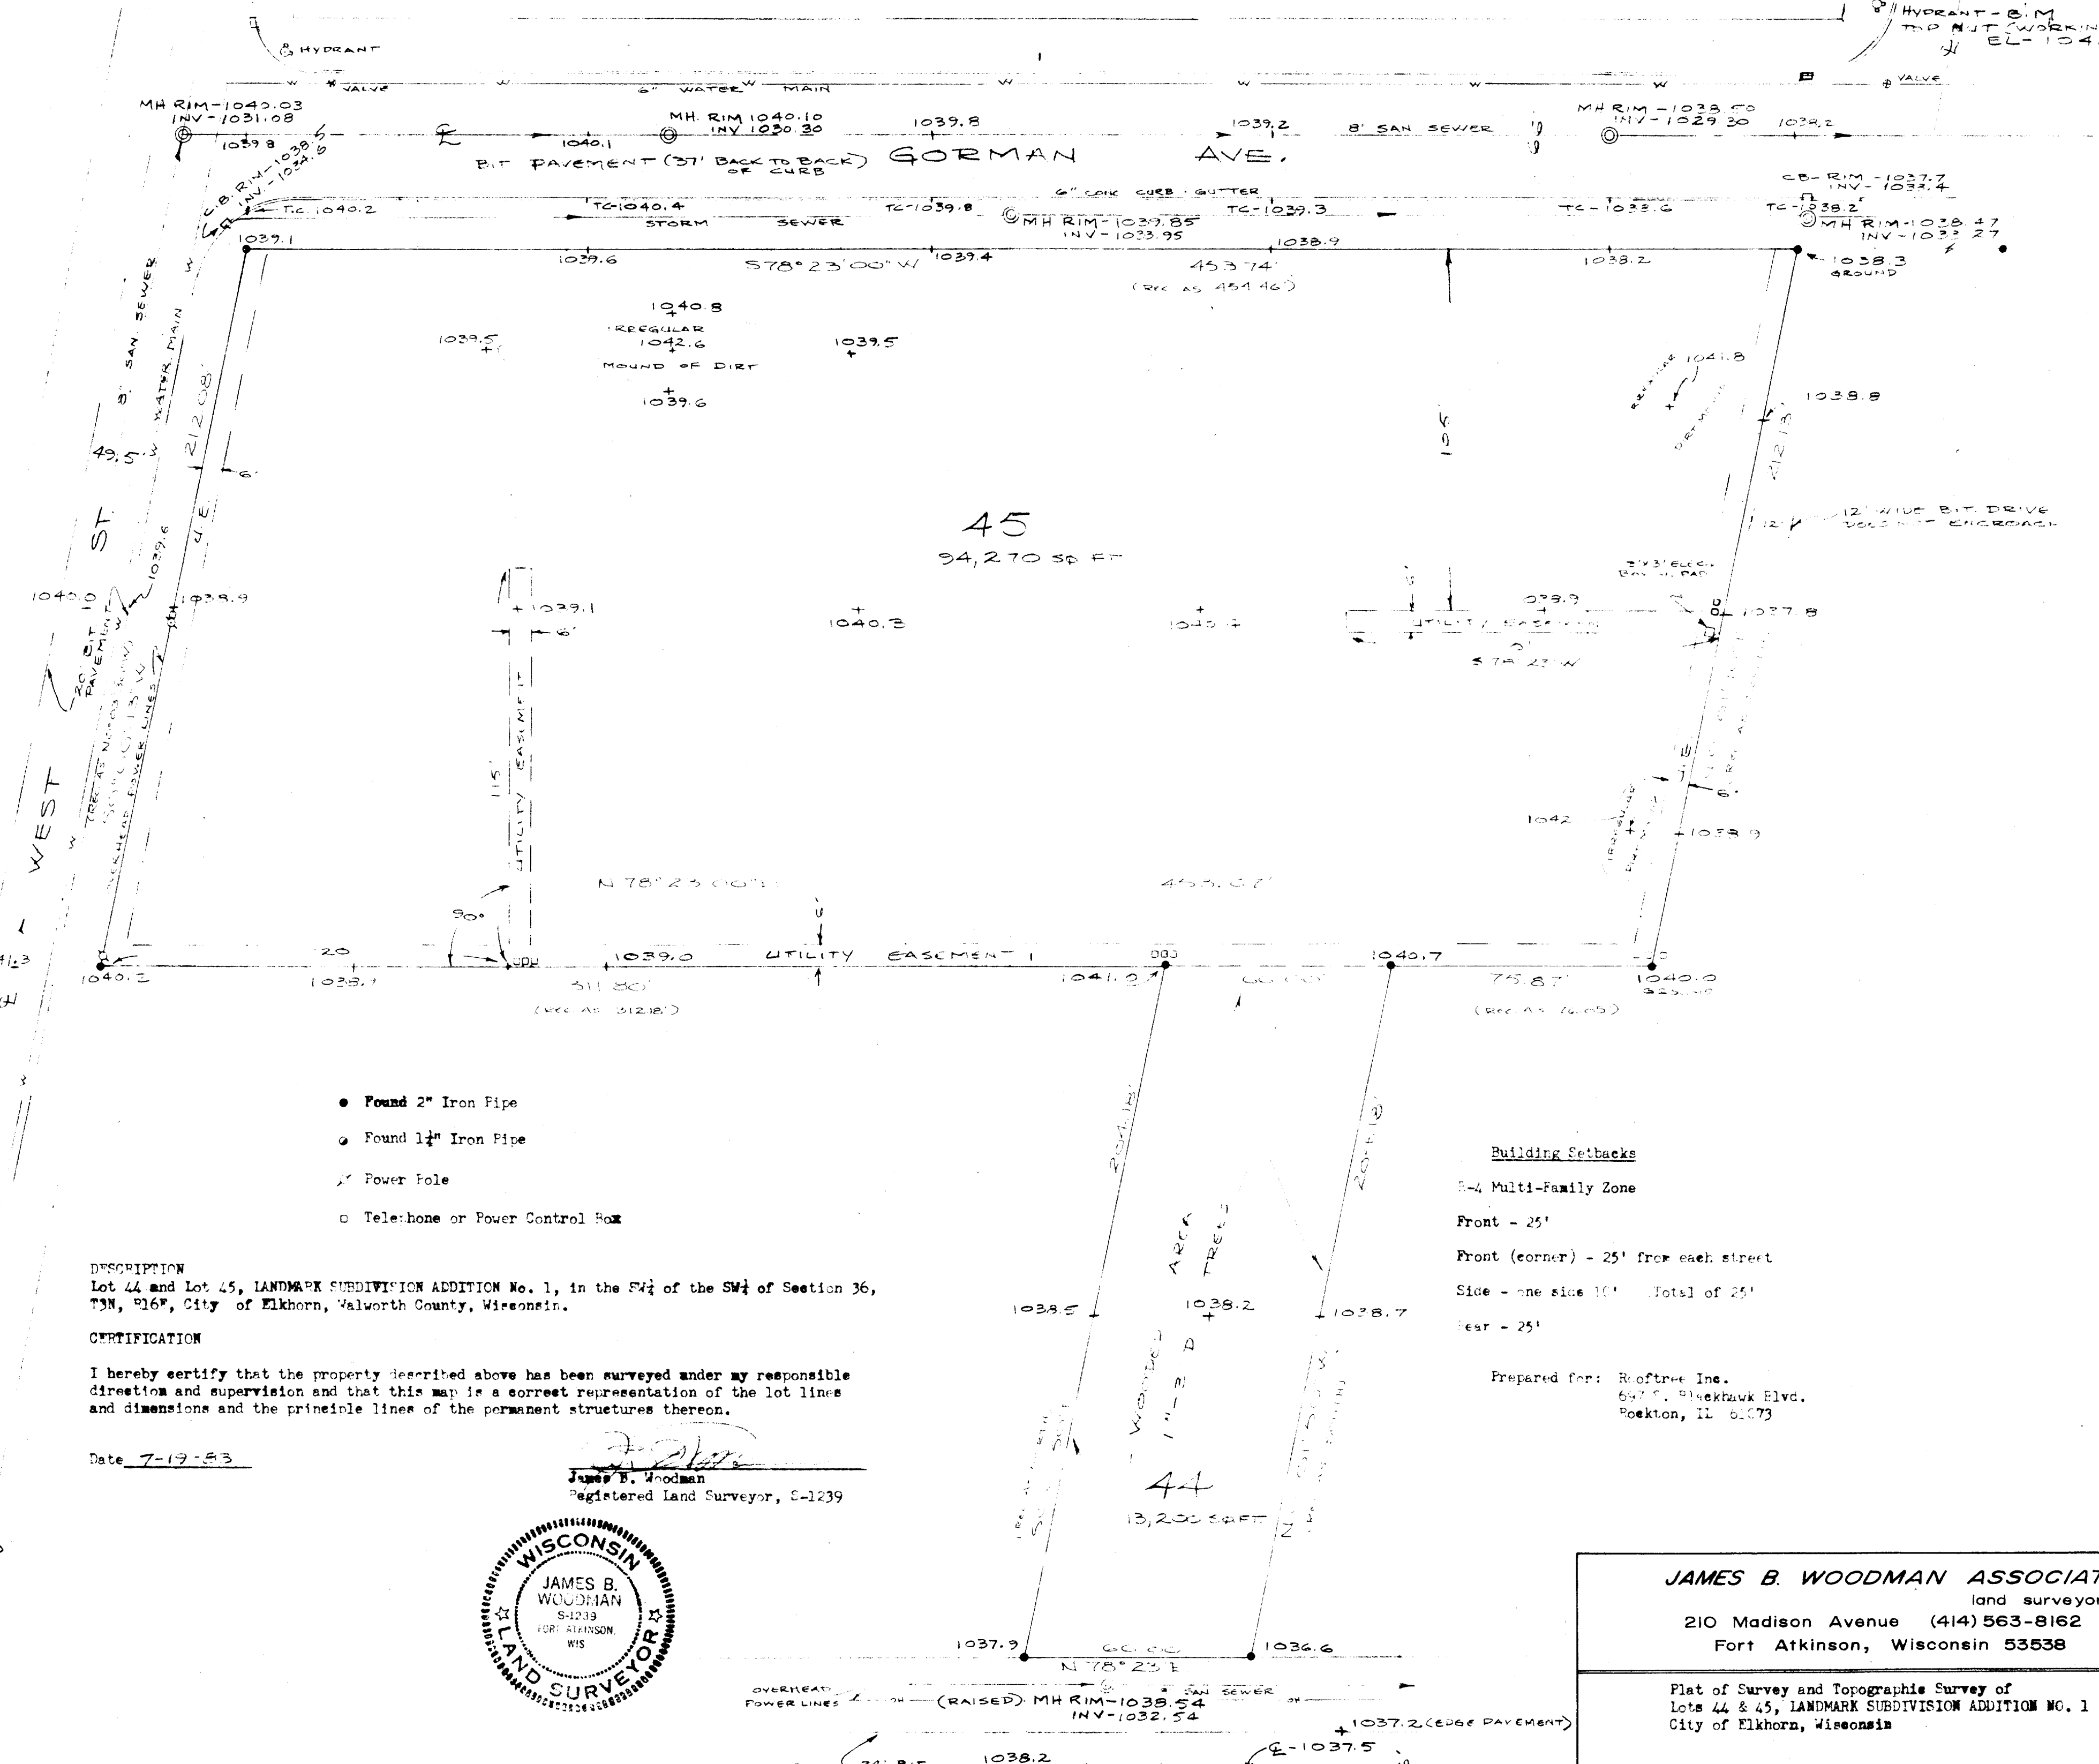


- Found 2" Iron Pipe
- Found 1 1/2" Iron Pipe
- ✕ Power Pole
- Telephone or Power Control Box

DESCRIPTION
 Lot 44 and Lot 45, LANDMARK SUBDIVISION ADDITION No. 1, in the SW 1/4 of the SW 1/4 of Section 36, T3N, R16E, City of Elkhorn, Walworth County, Wisconsin.

CERTIFICATION
 I hereby certify that the property described above has been surveyed under my responsible direction and supervision and that this map is a correct representation of the lot lines and dimensions and the principle lines of the permanent structures thereon.

Date 7-19-53

James B. Woodman
 James B. Woodman
 Registered Land Surveyor, S-1239

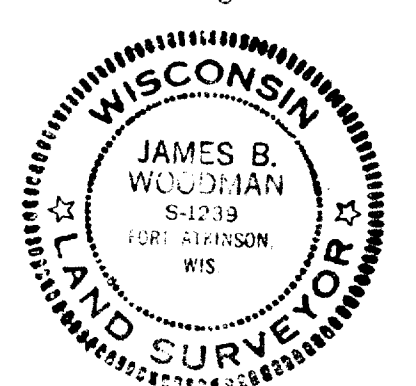

Building Setbacks
 R-4 Multi-Family Zone
 Front - 25'
 Front (corner) - 25' from each street
 Side - one side 10' (Total of 25')
 Rear - 25'

Prepared for: Roofree Inc.
 647 S. Blackhawk Blvd.
 Rockton, IL 61073

JAMES B. WOODMAN ASSOCIATES
 land surveyors
 210 Madison Avenue (414) 563-8162
 Fort Atkinson, Wisconsin 53538

Plat of Survey and Topographic Survey of
 Lots 44 & 45, LANDMARK SUBDIVISION ADDITION NO. 1
 City of Elkhorn, Wisconsin

DSN.	DATE	REV.	DATE	SCALE	1" = 30'
DRN.	18W	7/15/13	REV.	4-338	JOB NO. 835-61
APPR.	18W	7/18/13	REV.		SHEET 1 OF 1

YLSA 25.26.267
 YLSA 25-26