


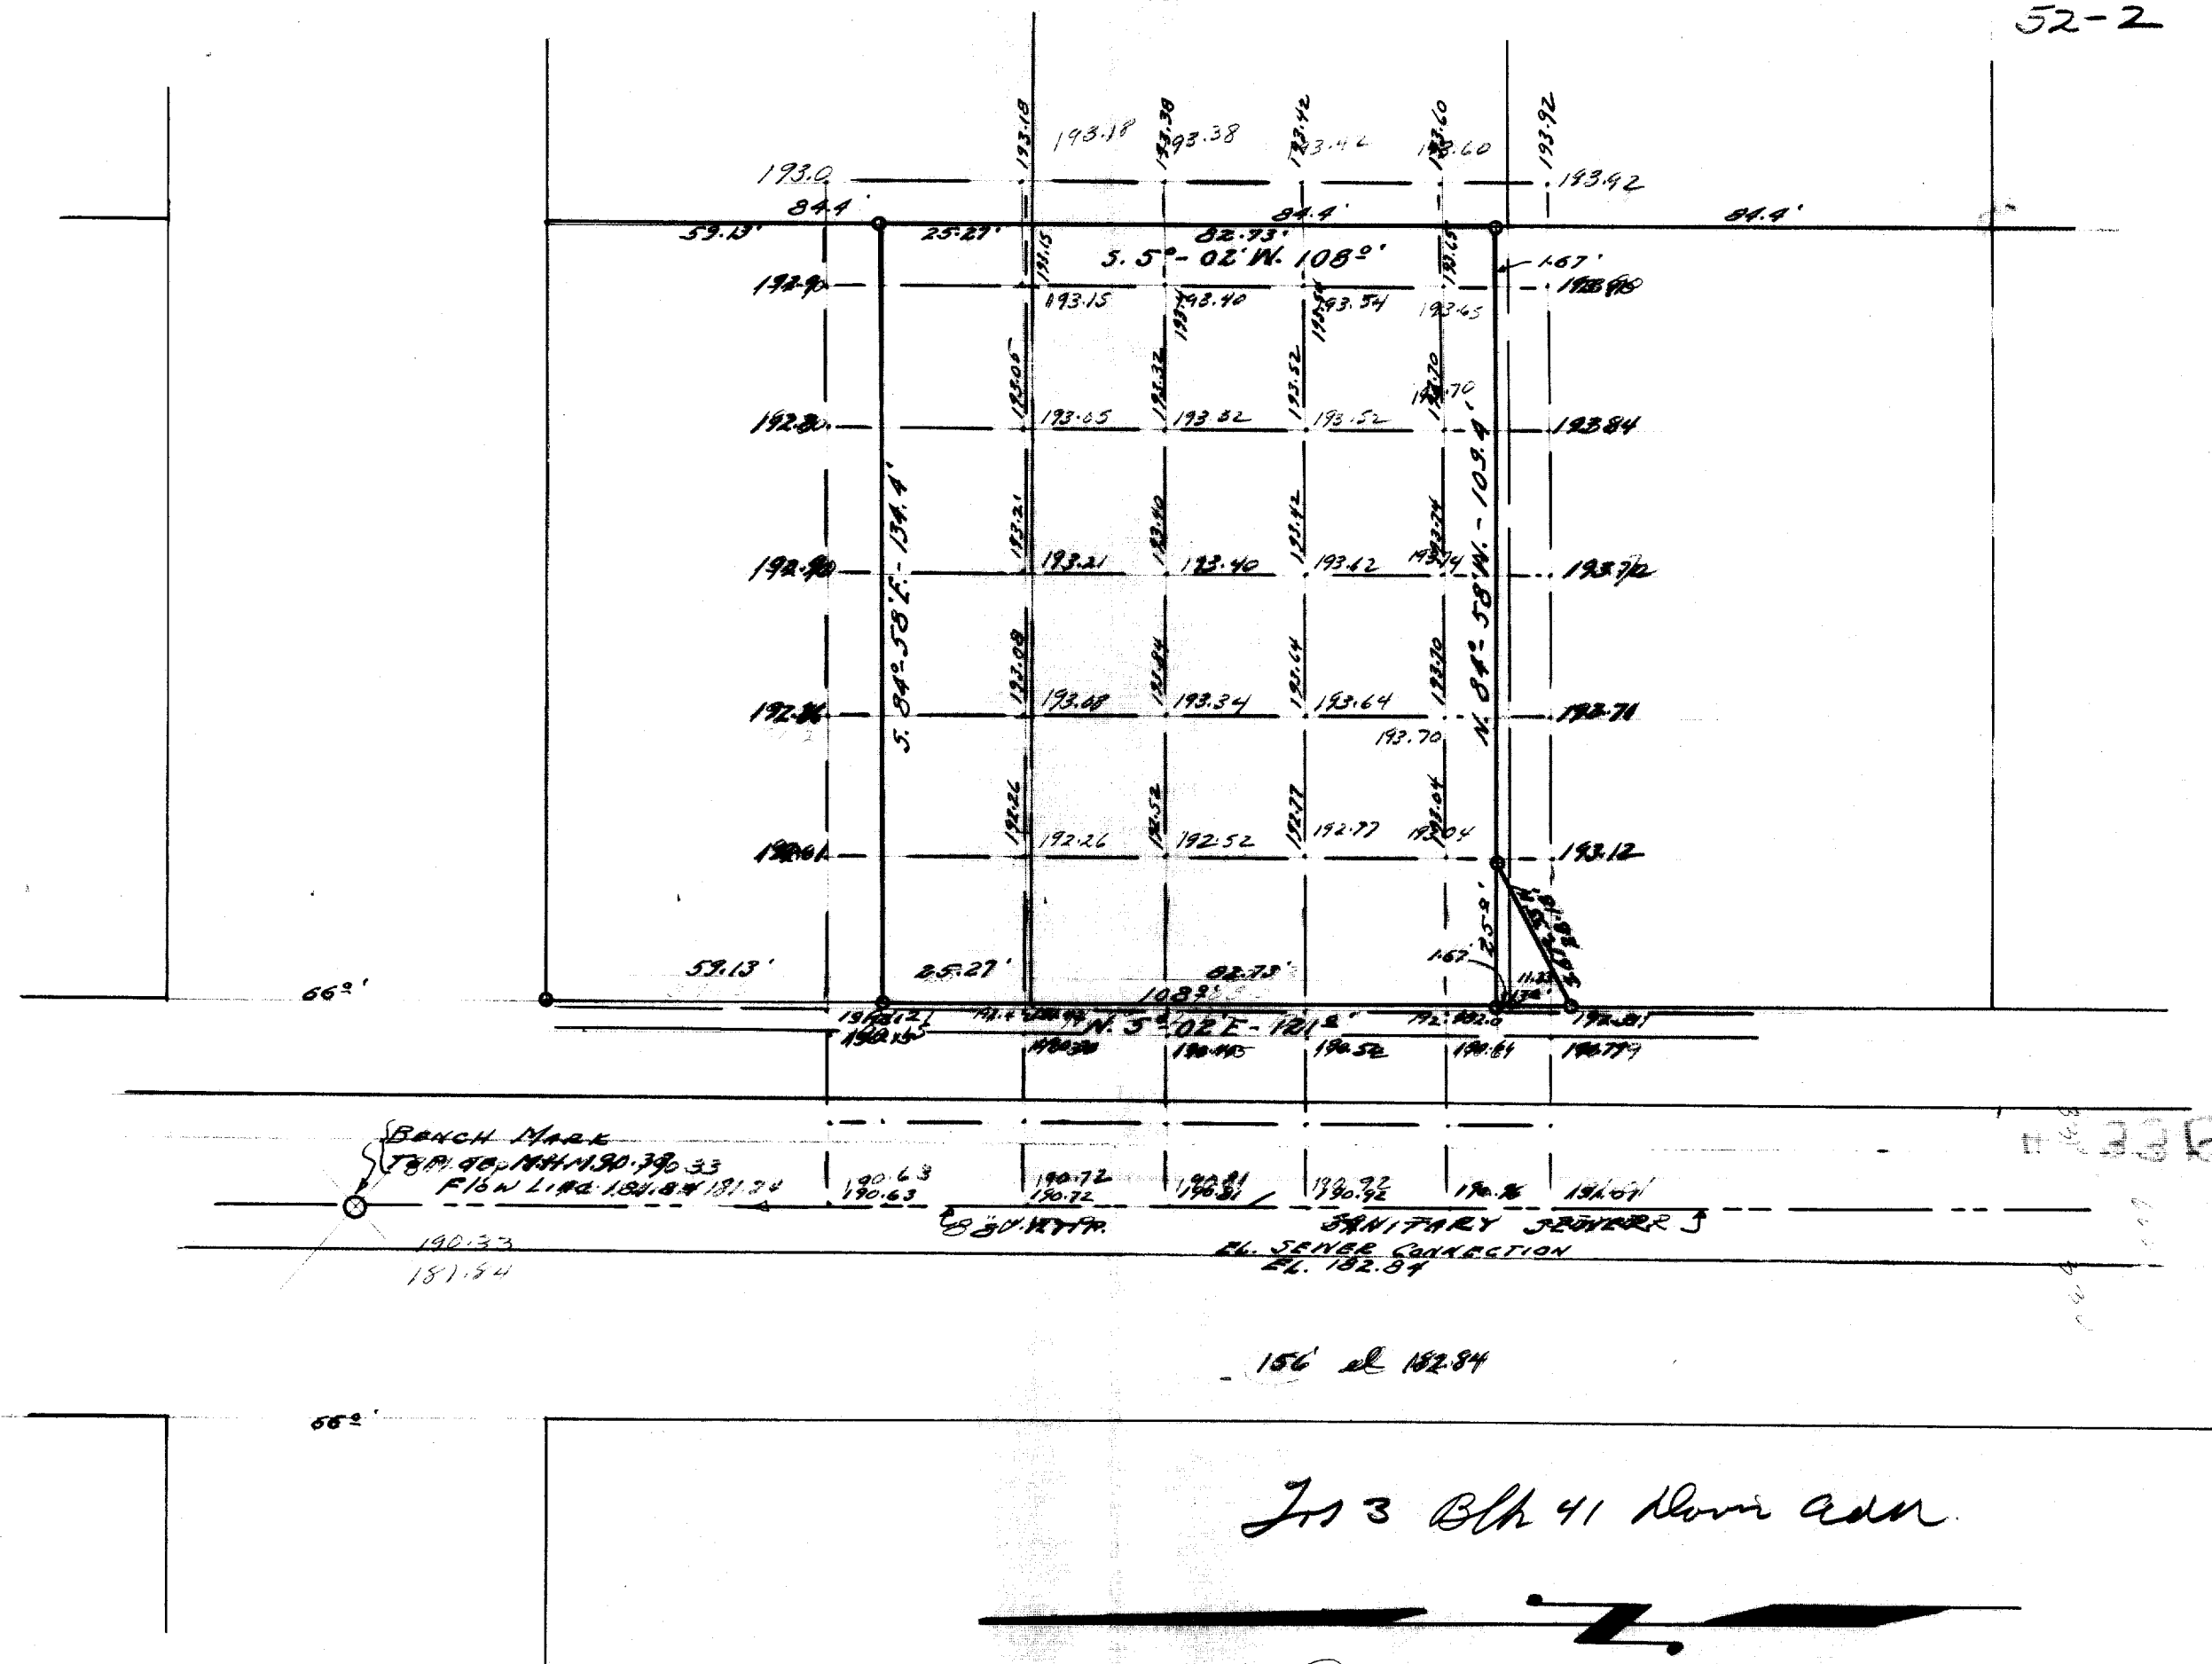

Y* MISC
YA-938-2