


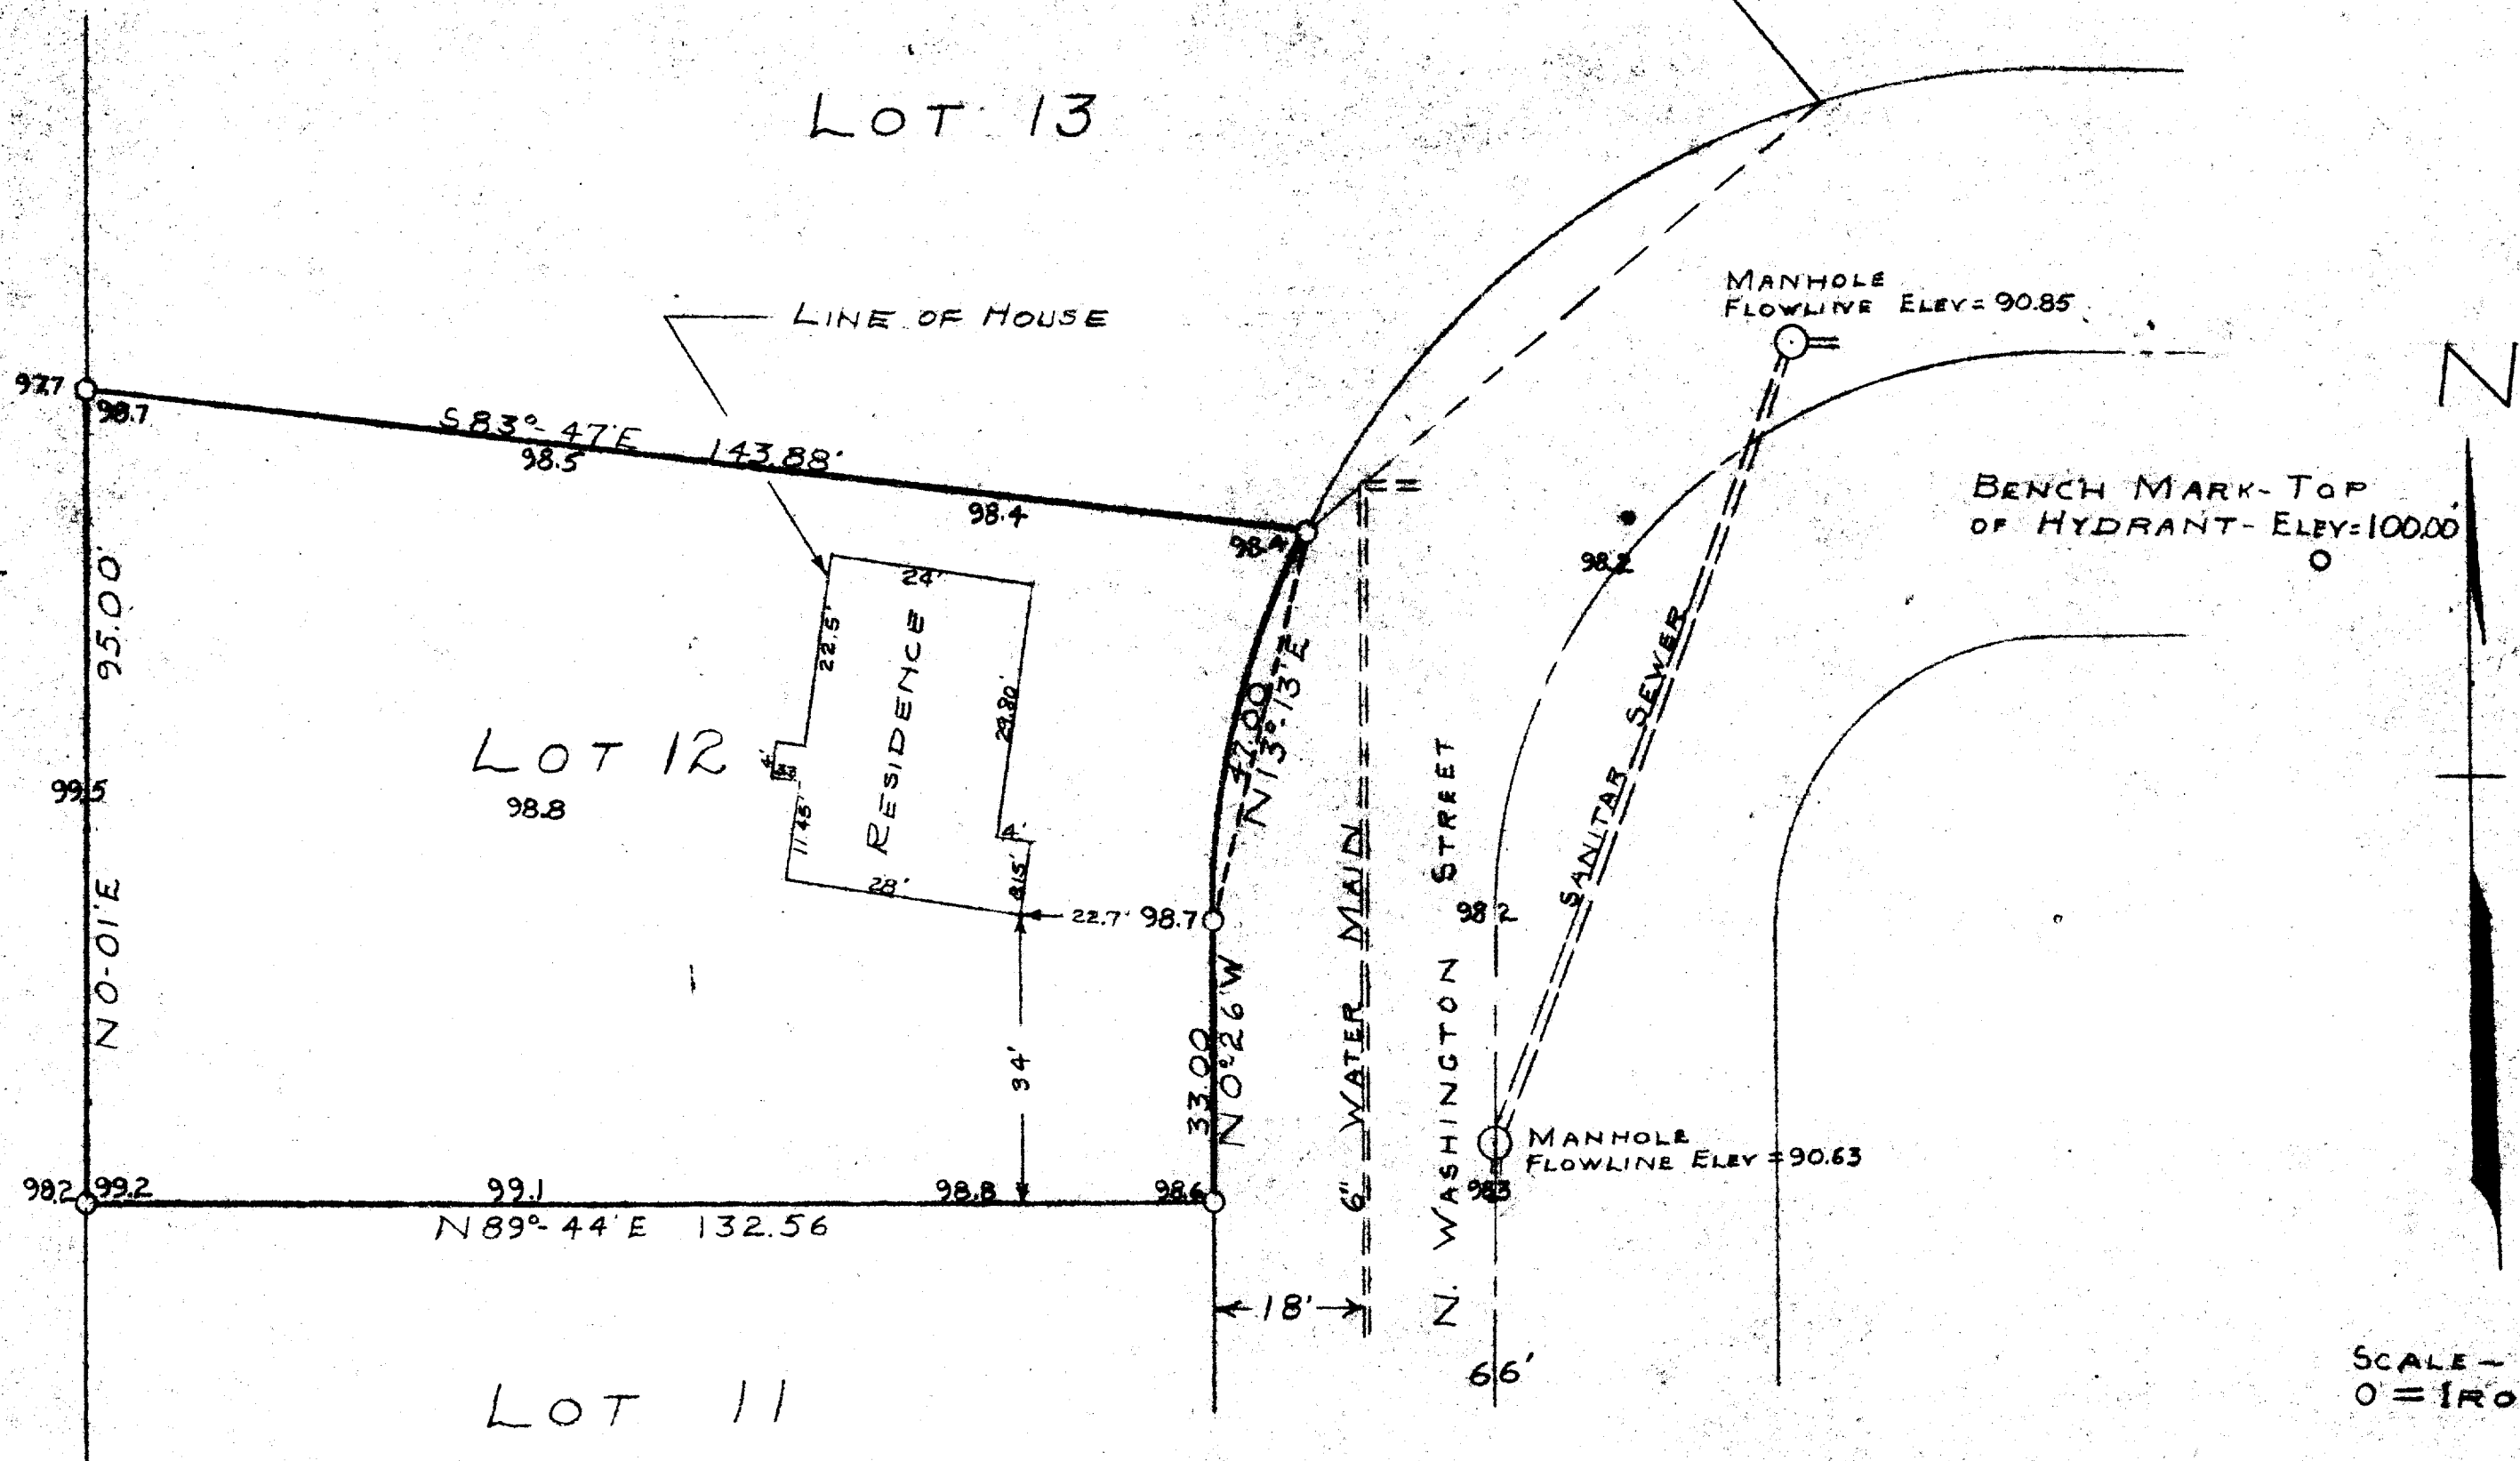

STATE OF WISCONSIN } 55
WALWORTH COUNTY }

I, LLOYD L. JENSEN DO HEREBY CERTIFY THAT I HAVE SURVEYED THE PROPERTY DESCRIBED ACCORDING TO THE OFFICIAL RECORDS AS, LOT 12, MANN BROTHERS' ADDITION, LOCATED IN THE CITY OF ELKHORN, WALWORTH COUNTY, WISCONSIN, AND THAT THE PLAT ABOVE IS A CORRECT REPRESENTATION OF THE LOT LINES AND PRINCIPAL LINES OF BUILDINGS THEREON.

ELKHORN, WISCONSIN, MARCH 7, 1952
REVISED MAY 5, 1952

REVISED NOV. 10, 1952

Lloyd L. Jensen

Floyd L. Jensen

Lloyd L. Jensen
COUNTY SURVEYOR

YMB/2

4-7