


PLAT OF A MORTGAGE INSPECTION of Lot 7 Block 5, Edgewood 1st Addition, located in the W $\frac{1}{2}$ of the NE $\frac{1}{4}$ of Section 36, T3N R16E, City of Elkhorn, Walworth County, Wisconsin.

Inspected and mapped by: Jensen Surveying & Mapping, S.C.
45 S. Wis. St. P.O. Box 322
Elkhorn, Wisconsin, 53121
(414) 723-434

WORK ORDERED BY: Mike Gertich
M & I Mortgage Co.
210 W. Wisconsin
Milwaukee, Wis. 53203

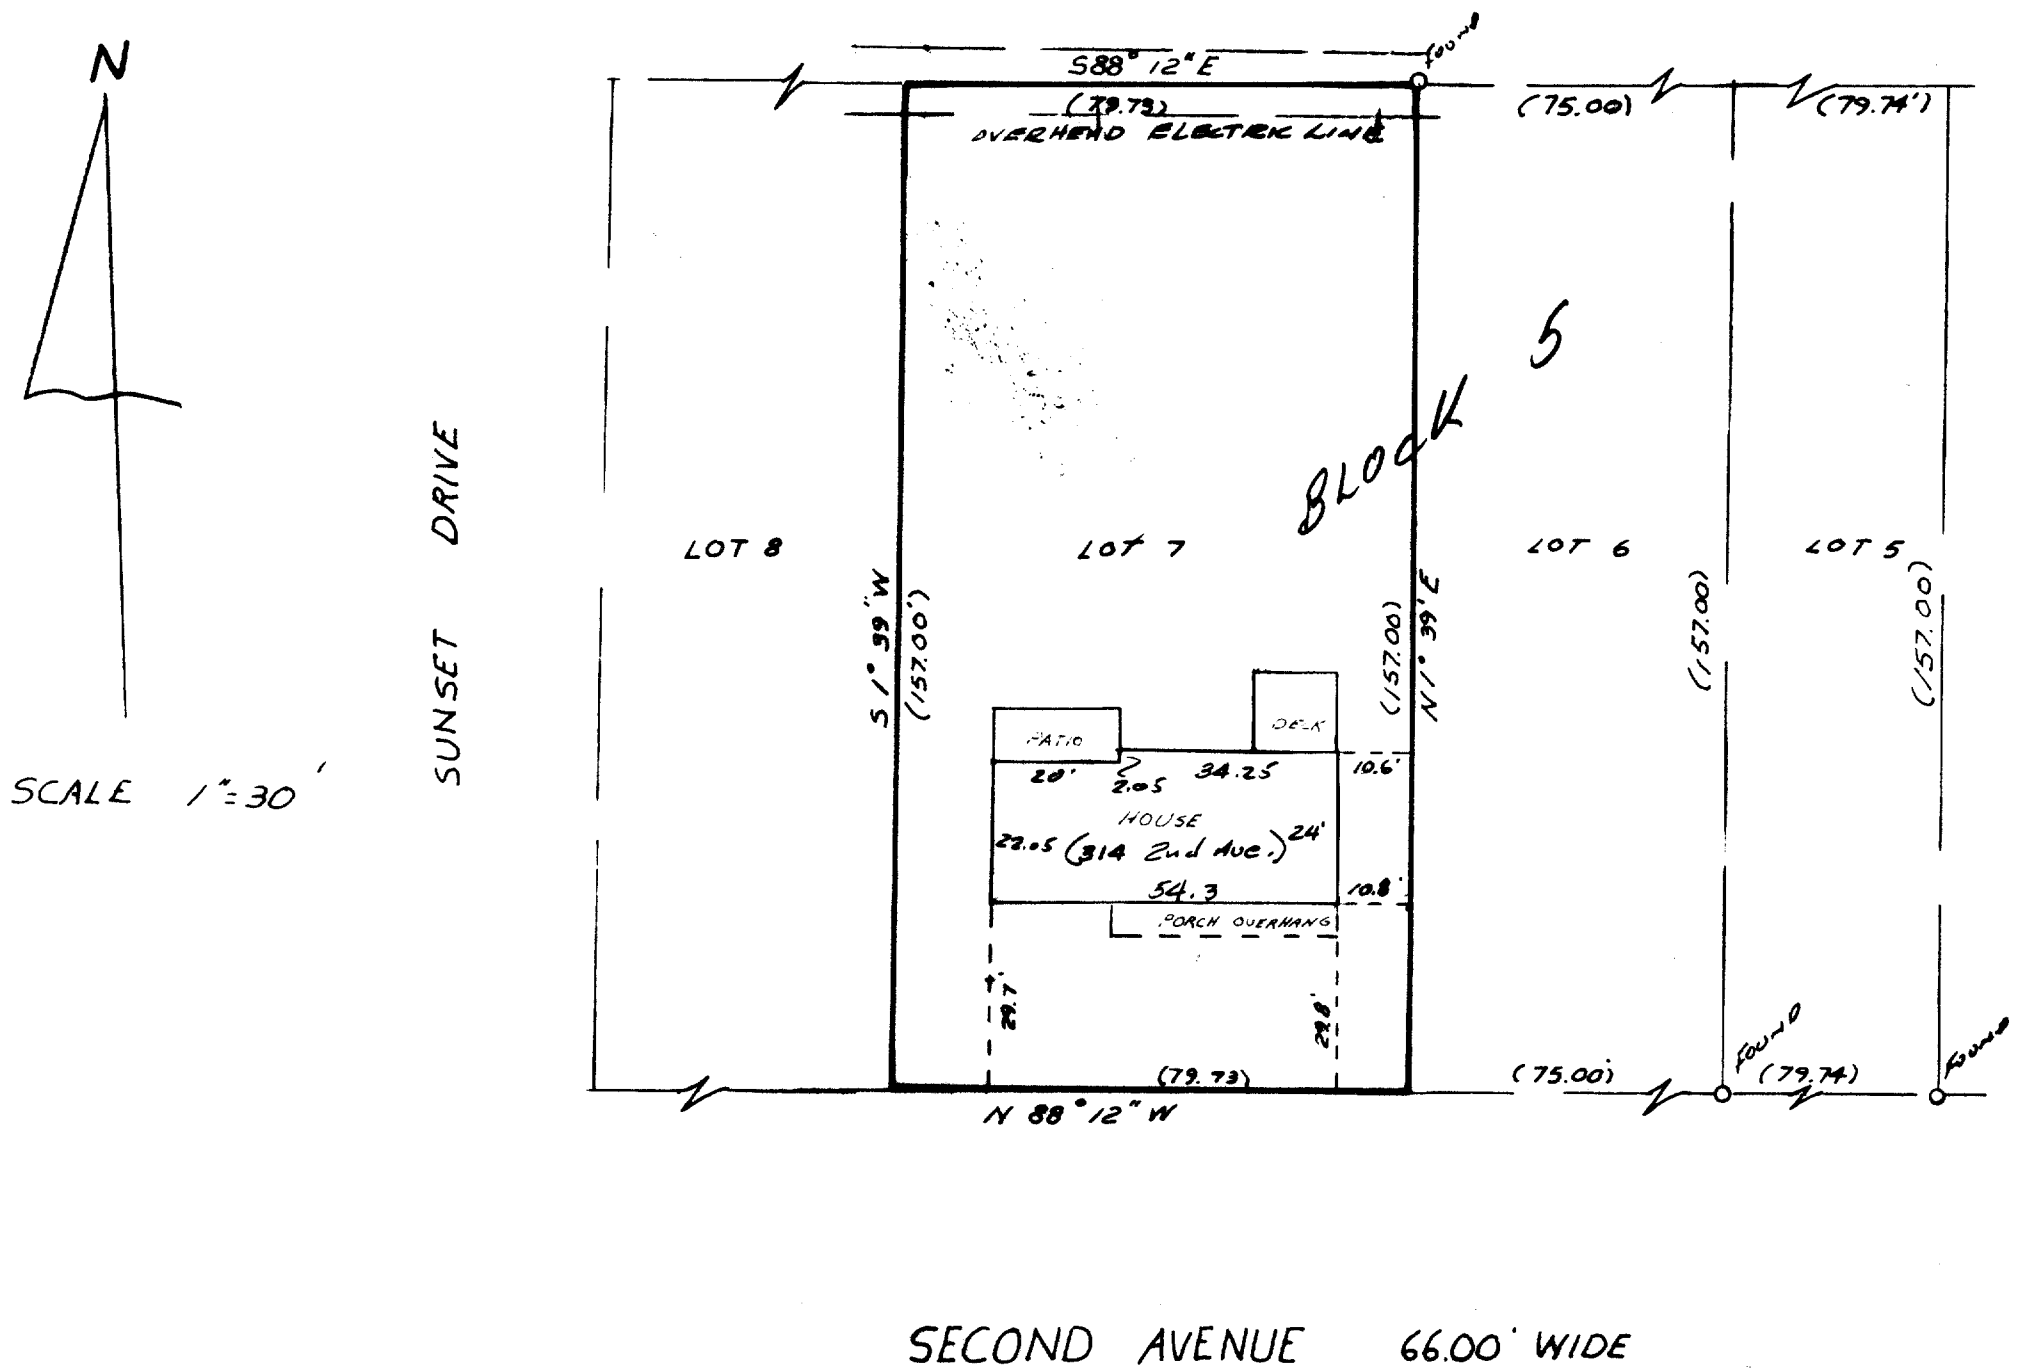


CERTIFICATE:

Thomas P.A. Jensen, Registered Land Surveyor in the State of Wisconsin, do hereby certify that I have inspected the above described property and that I have mapped the property according to the official records and that I have mapped the location of all visible structures, the dimensions of all principal buildings, roadways, apparent easements and visible encroachments, if any. This mortgage inspection has been prepared in accordance with the requirements of M & I Mortgage Co. and under an agreement between Jensen Surveying & Mapping, S.C. and the M & I Mortgage Co. which excludes this mortgage inspection from all of the requirements of Section AE 5.01, Wis. Administrative Code. Therefore, all of the requirements of Section AE 5.01 have not been complied with. This mortgage inspection is made for the exclusive use of the present owners of the property and also those who purchase, mortgage or guarantee the title thereto within one year from date hereof and as to them we certify the accuracy of said mortgage inspection as shown."

Dated this 14th day of Dec. 1983.

Thomas P.A. Jensen
Thomas P.A. Jensen S-1084

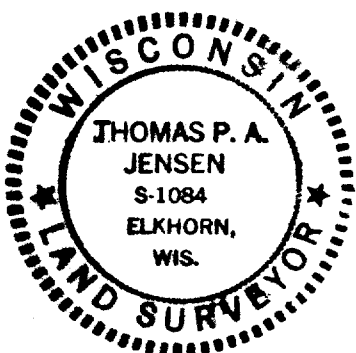

4-340-J
1983.064