

PLAT OF SURVEY OF LOT 3 AND PART OF LOT 6 BLOCK 12 ROCKWELLS ADDITION, CITY OF ELKHORN, WALWORTH COUNTY, WISCONSIN.

JENSEN SURVEYING & MAPPING S.C.

P.O. BOX 322

ELKHORN, WISCONSIN

45 S. WISCONSIN ST.

PHONE (414) 723-3434

53121

SURVEYED FOR~ JAMES BIAGI

5400 N. OCEAN BLVD.

FT. LAUDERDALE, FLA.

33308

LEGEND

○ ~ FOUND IRON PIPE


● ~ SET IRON PIPE

() ~ RECORDED AS

MAPPING DATE: 17 OCT. 84


SCALE ~ 1" = 30'

LINCOLN STREET 66' WIDE PUBLIC

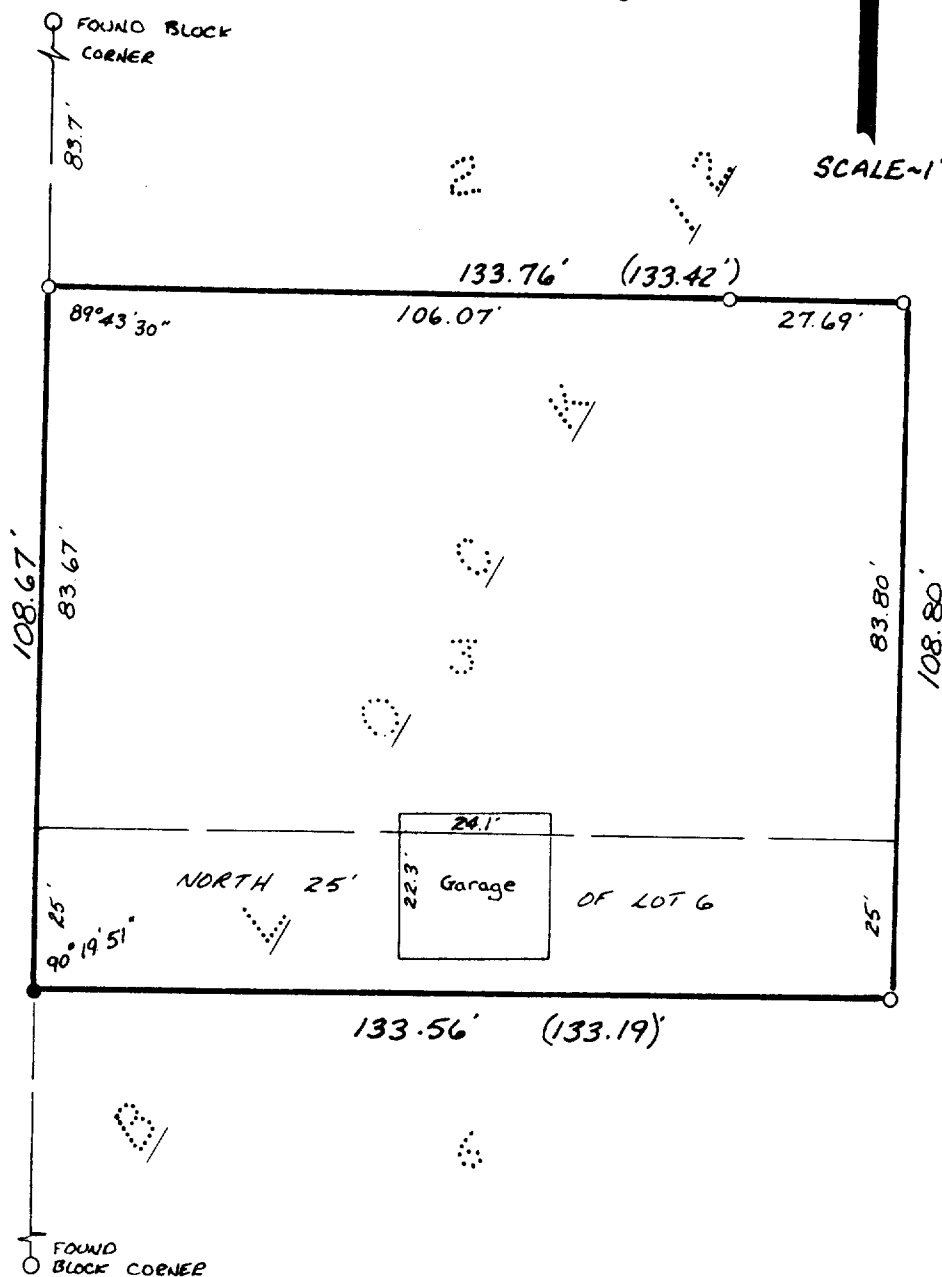

I HEREBY CERTIFY THAT THE ABOVE DESCRIBED
PROPERTY HAS BEEN SURVEYED UNDER MY DIRECTION THAT
THE PLAT SHOWN HEREON IS AN ACCURATE SURVEY, A TRUE
REPRESENTATION THEREOF CORRECTLY SHOWS THE EXTERIOR
BOUNDARY LINES ON SAID PROPERTY AND THE CORRECT
MEASUREMENTS THEREOF AND BUILDINGS THEREON

Thomas P. Jensen
THOMAS P. JENSEN RLS-1084

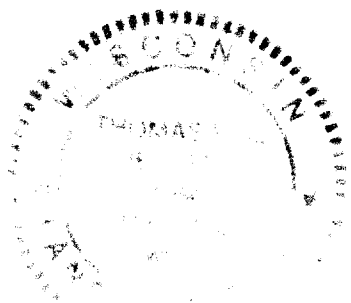

1 RW-5

1984.068

4-342-5