

COOPER SURVEYING SERVICES

DANIEL D. COOPER
Registered Land Surveyor


Route 1, Box 220 Elkhorn, Wisconsin 53121

SURVEYING & PLANNING
SUBDIVISIONS - LOT SURVEYS
CONSTRUCTION STAKING - MAPPING

Phone (608) 723-4845

9

NORTH MUSKUMINGUIN STREET

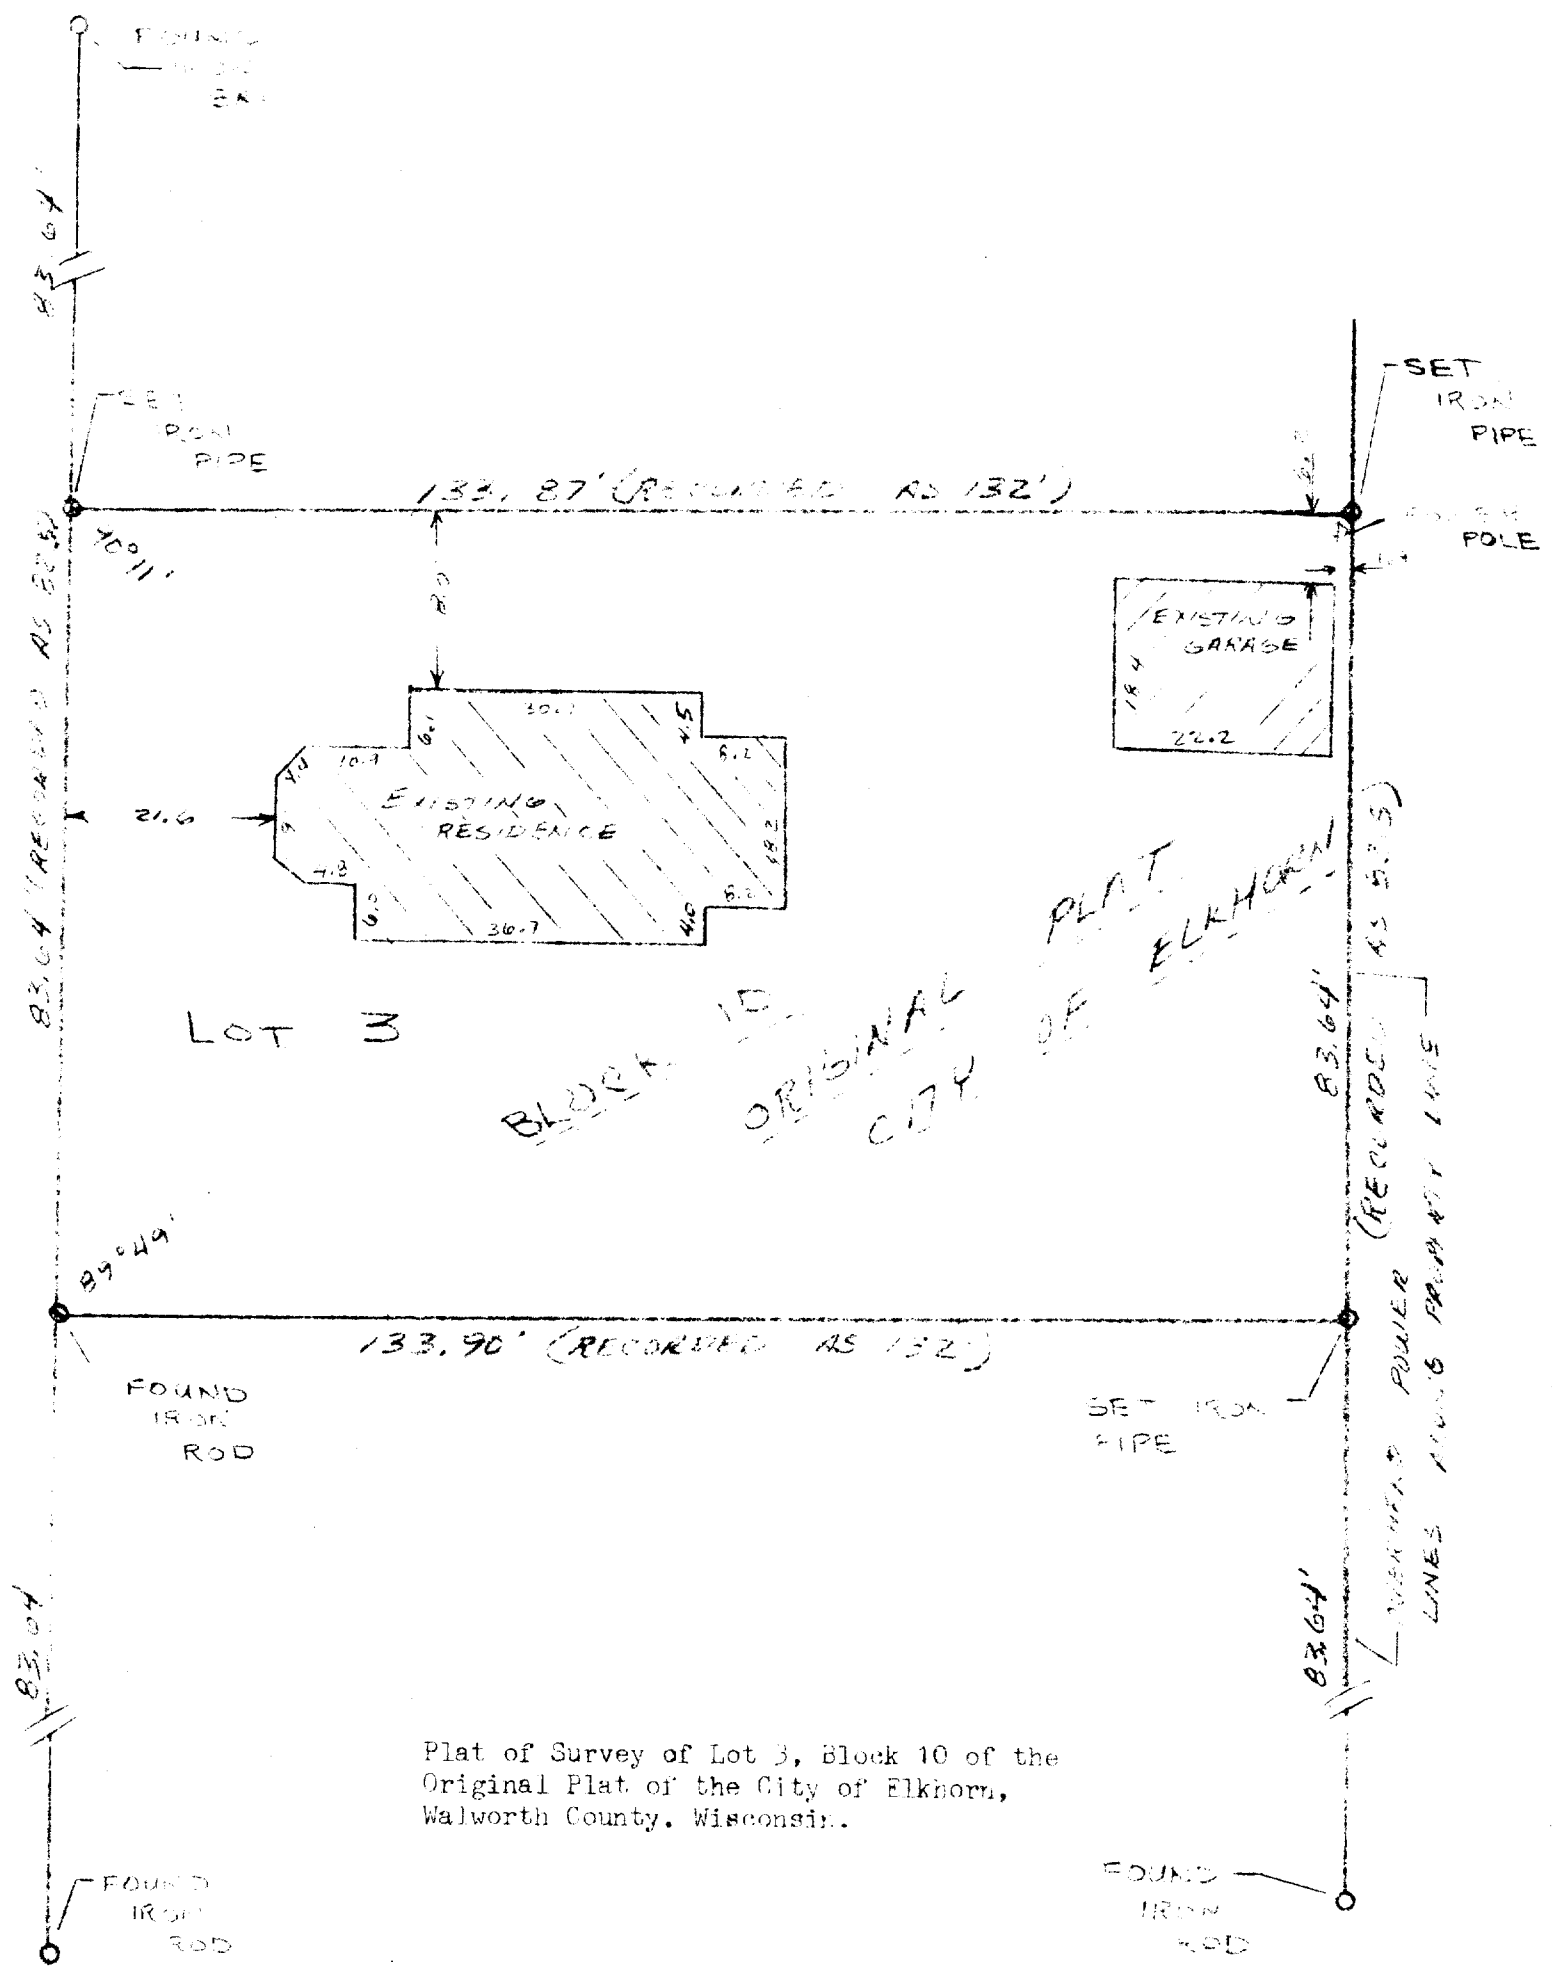



Plat of Survey of Lot 3, Block 10 of the
Original Plat of the City of Elkhorn,
Walworth County, Wisconsin.

Survey ordered by Atty. Richard Howarth

I hereby certify that I have surveyed the property described hereon and that the
above map is a true representation thereof and shows the size and location of the
property, the location of visible structures and all principal buildings thereon.
This survey is made for the present owners of the property and also those who
purchase, mortgage, or guarantee the title thereto within one year from the date
thereof.

Dated this 26 day of Oct, 1982

Daniel D. Cooper
Daniel D. Cooper, RLS. No. S-1464

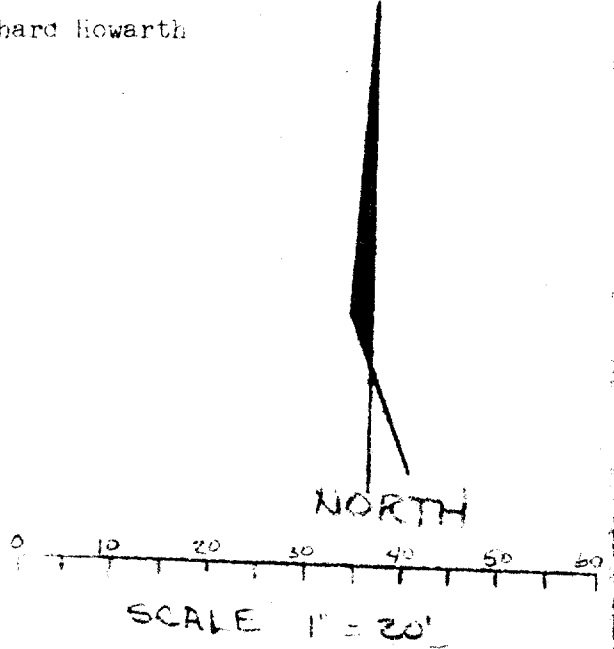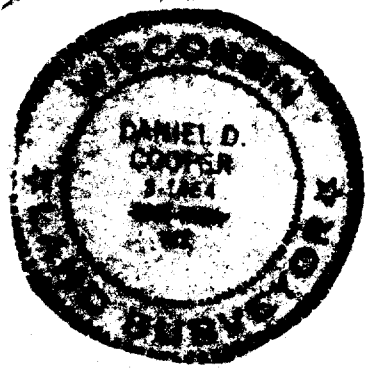

YOP-93

DRAWING NO. 1812
4-343