

PLAN OF A MORTGAGE INSPECTION of Lots 7, 10, 11, Block 13, Roskelle Addition, located in the SW 1/4 of Section 1, T-4N, R-10E, City of Elkhorn, Walworth County, Wisconsin.


Inspected and mapped by: Jensen Surveying & Mapping, S.S.
424 N. Wis. St. P.O. Box 422
Elkhorn, Wisconsin, 53121
(414) 723-4434

WORK OF EYE BY: Janhaw Realty
P.O. Box 121
Elkhorn, Wisconsin, 53121


CERTIFICATE:

I, Thomas P. A. Jensen, Registered Land Surveyor in the State of Wisconsin, do hereby certify that I have inspected the above described property and that I have mapped the property according to the official records and that I have mapped the location of all visible structures, the dimensions of all principal buildings, coalways, apparent easements and visible encroachments, if any. This mortgage inspection has been prepared in accordance with the requirements of Janhaw Realty, and under an agreement between Jensen Surveying & Mapping, S.S. and the Janhaw Realty which requires this mortgage inspection meet all of the requirements of Section AE 2.1 of the Wisconsin Administrative Code. Therefore, all of the requirements of Section AE 2.1 have not been complied with. This mortgage inspection is made for the exclusive use of the present owners of the property and also those who purchase, mortgage or guarantee the title thereto within one year from date hereof and as to them we certify the accuracy of said mortgage inspection as shown.

Dated this 11th day of Jan. 1984.

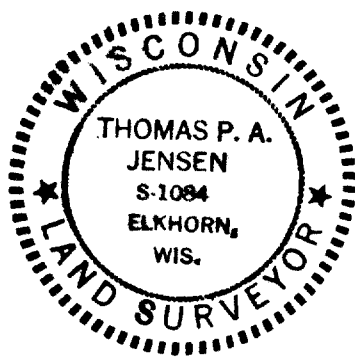

Thomas P. A. Jensen
Thomas P. A. Jensen - 1984

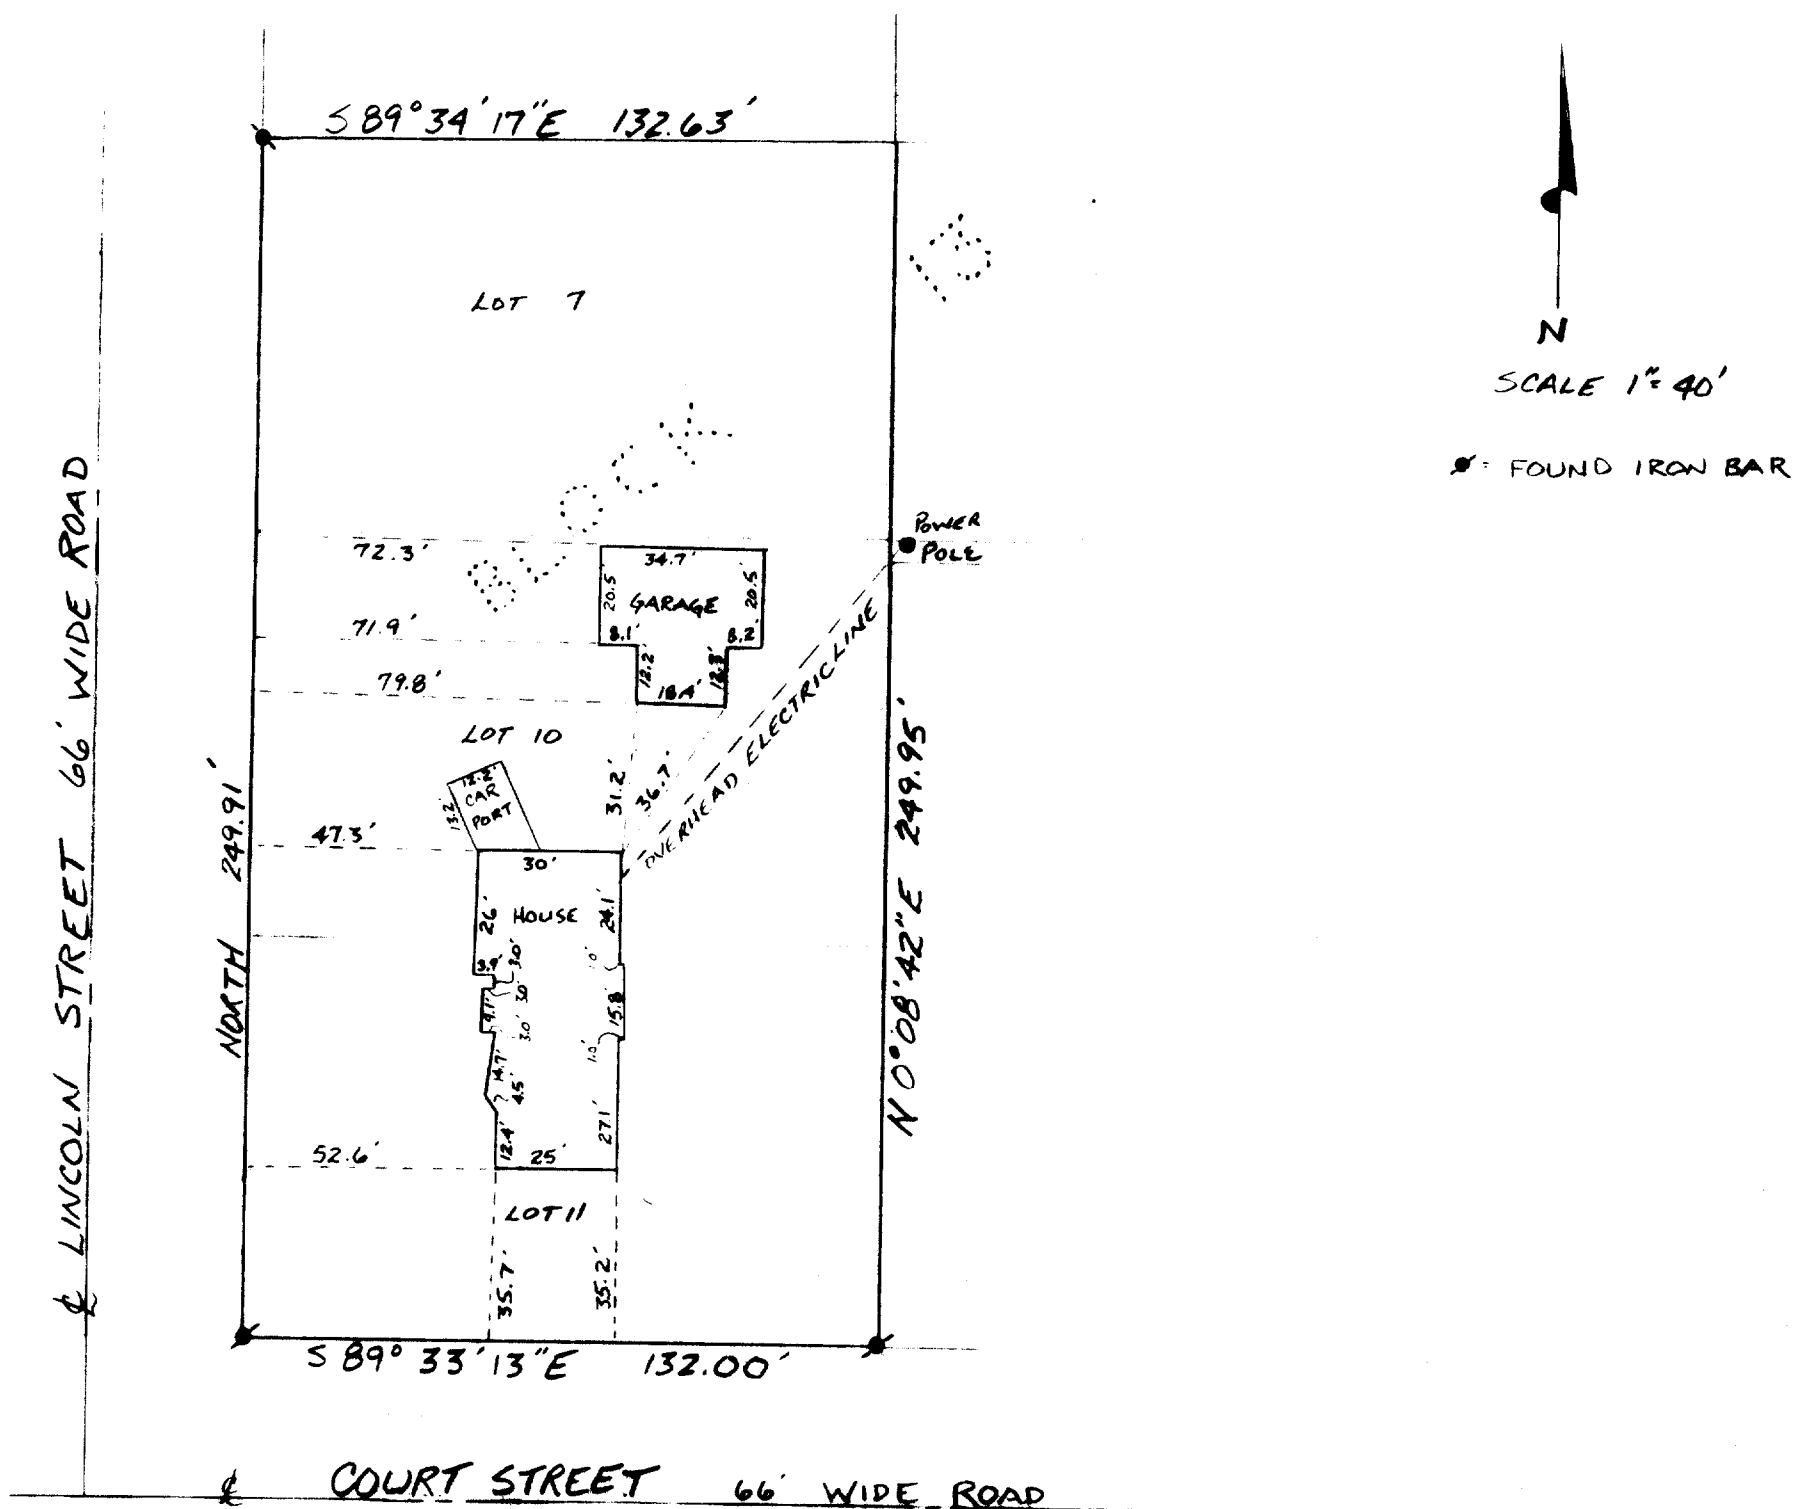

4-343-J^v
1984.001