


PLAT OF SURVEY

OF THE EAST 39 FEET OF LOT 1 OF BLOCK 2 IN HODGE'S ADDITION
AND THE WEST 66 FEET OF THE SOUTH 152 FEET OF LOT 7 AND THE
WEST 66 FEET OF LOT 10 AND 11 IN BLOCK 29 OF ROCKWELL'S ADDITION
TO THE CITY OF ELKHORN



JENSEN SURVEYING & MAPPING S.C.

P.O. BOX 322
ELKHORN, WIS 53121

SURVEYED FOR: LOOMIS & METTLETON
P.O. Box 13426
MILWAUKEE, WIS 53213

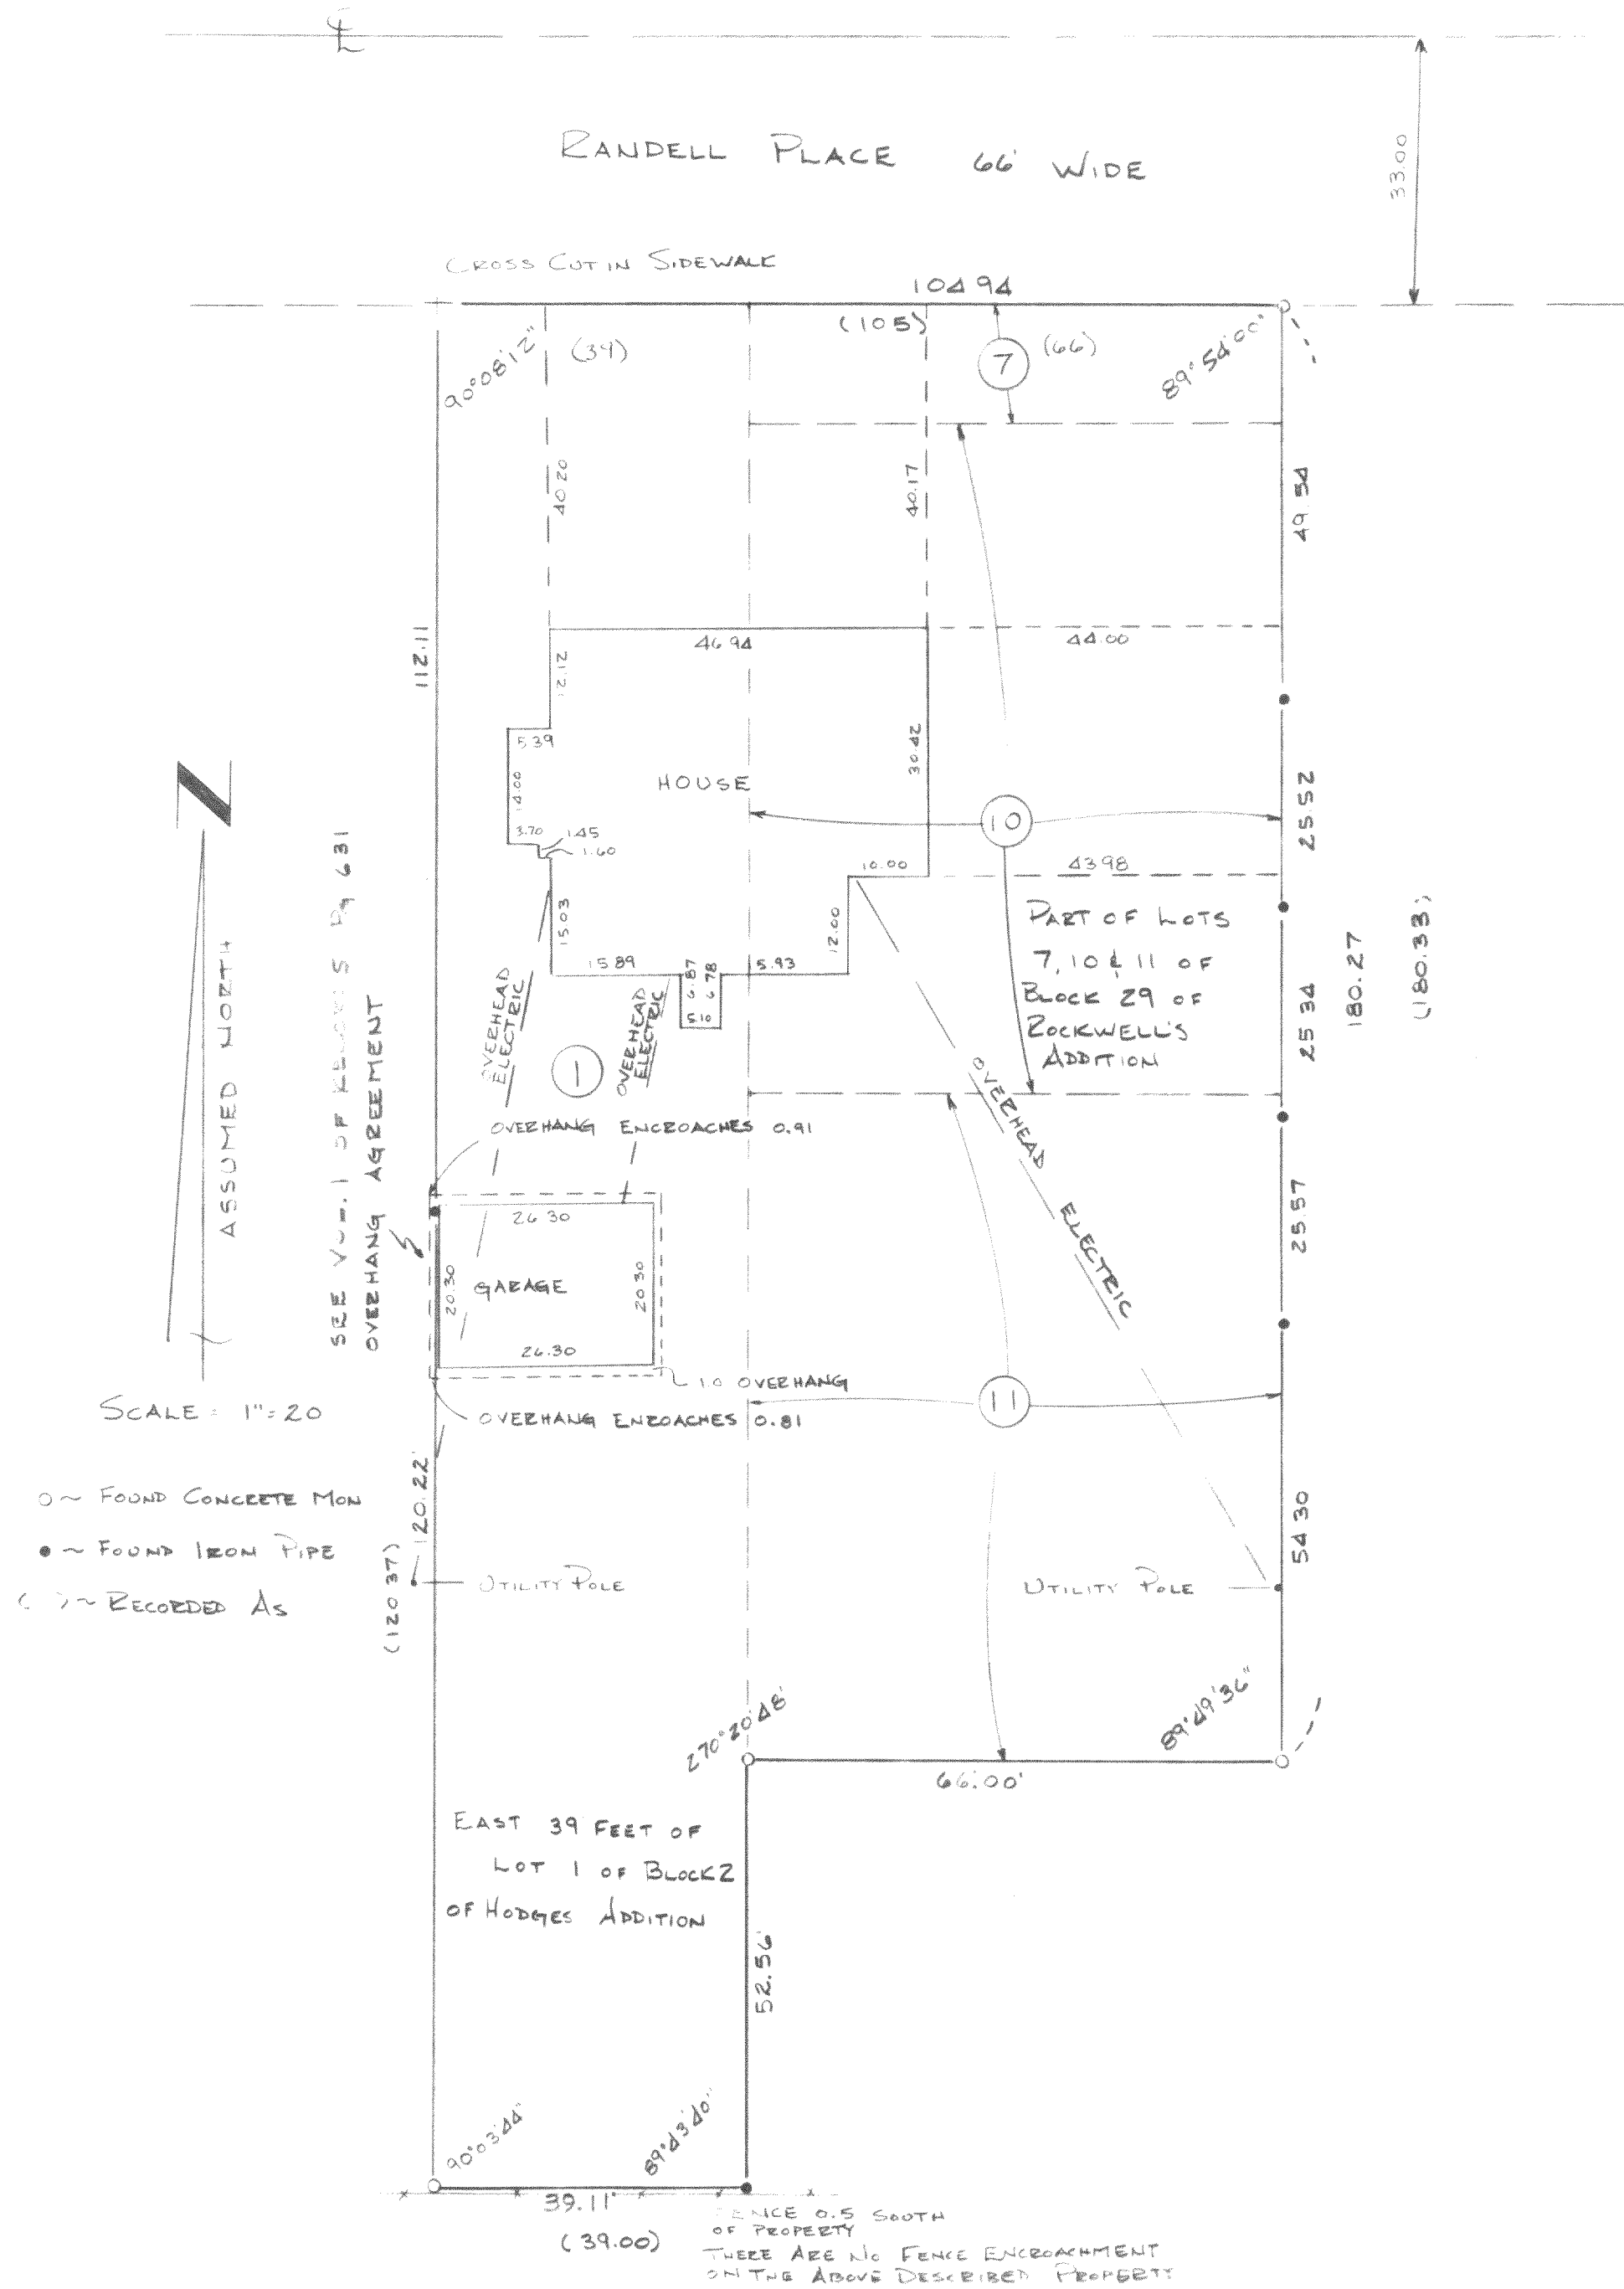

I hereby CERTIFY that the above described property has been surveyed in the field under my direction and that I have mapped the location of all visible structure, the demensions of all principal building, roadways, apparent easements and visable encroachments, if any. This SURVEY meets all of the requirements of Section A.E. 5.01, Wisconsin Administrative Code and is made for the exclusive use of the present owners of the property and also those who purchase, mortgage or guarantee the title thereto within one year from the date hereof and as to them we certify the accuracy of said survey as shown.

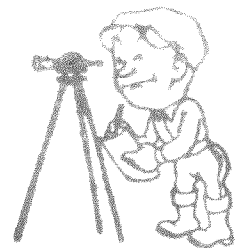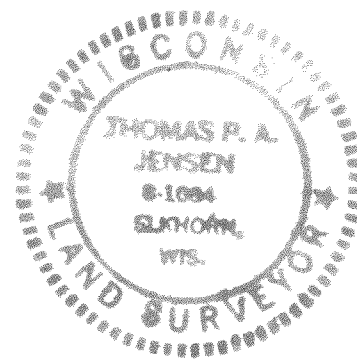

YRW-00038

THOMAS P.A. JENSEN R.L.S. # 1084

MAPPING DATE: JULY 18, 1984

4-345-J✓