



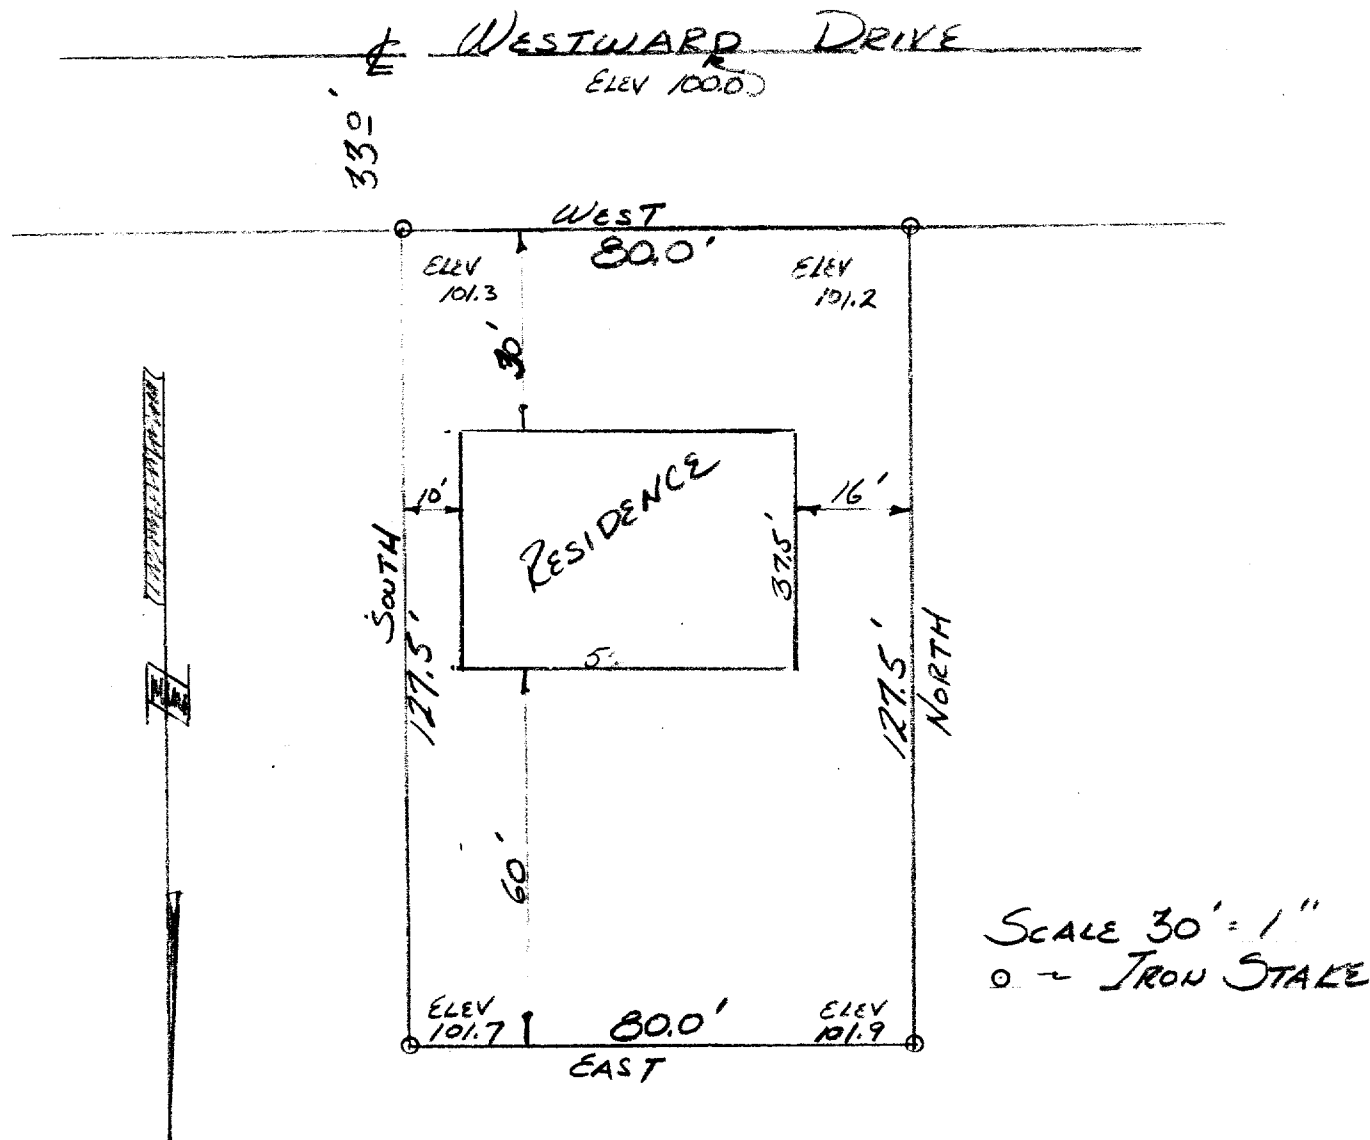

DESCRIPTION: Lot 3 of block 1 in James Jones 2nd addition to the City of Elkhorn, Walworth County, Wisconsin.

CERTIFICATION: I, hereby certify that I have on this day 12th of August 1958, surveyed the above described property and find the measurements and bearings of the boundary lines as taken on the site are in accordance with the drawing shown above, and that no encroachments exist.

SIGNED AND SEALED ON THIS THE 15TH DAY OF AUGUST 1958

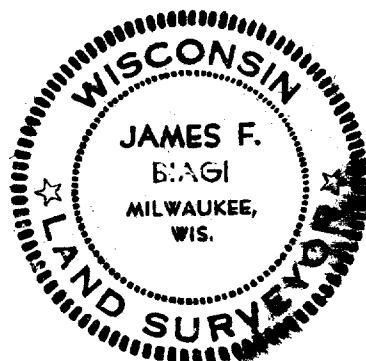

James F. Biagi
Land Surveyor (272)

YJA23

4-34B