


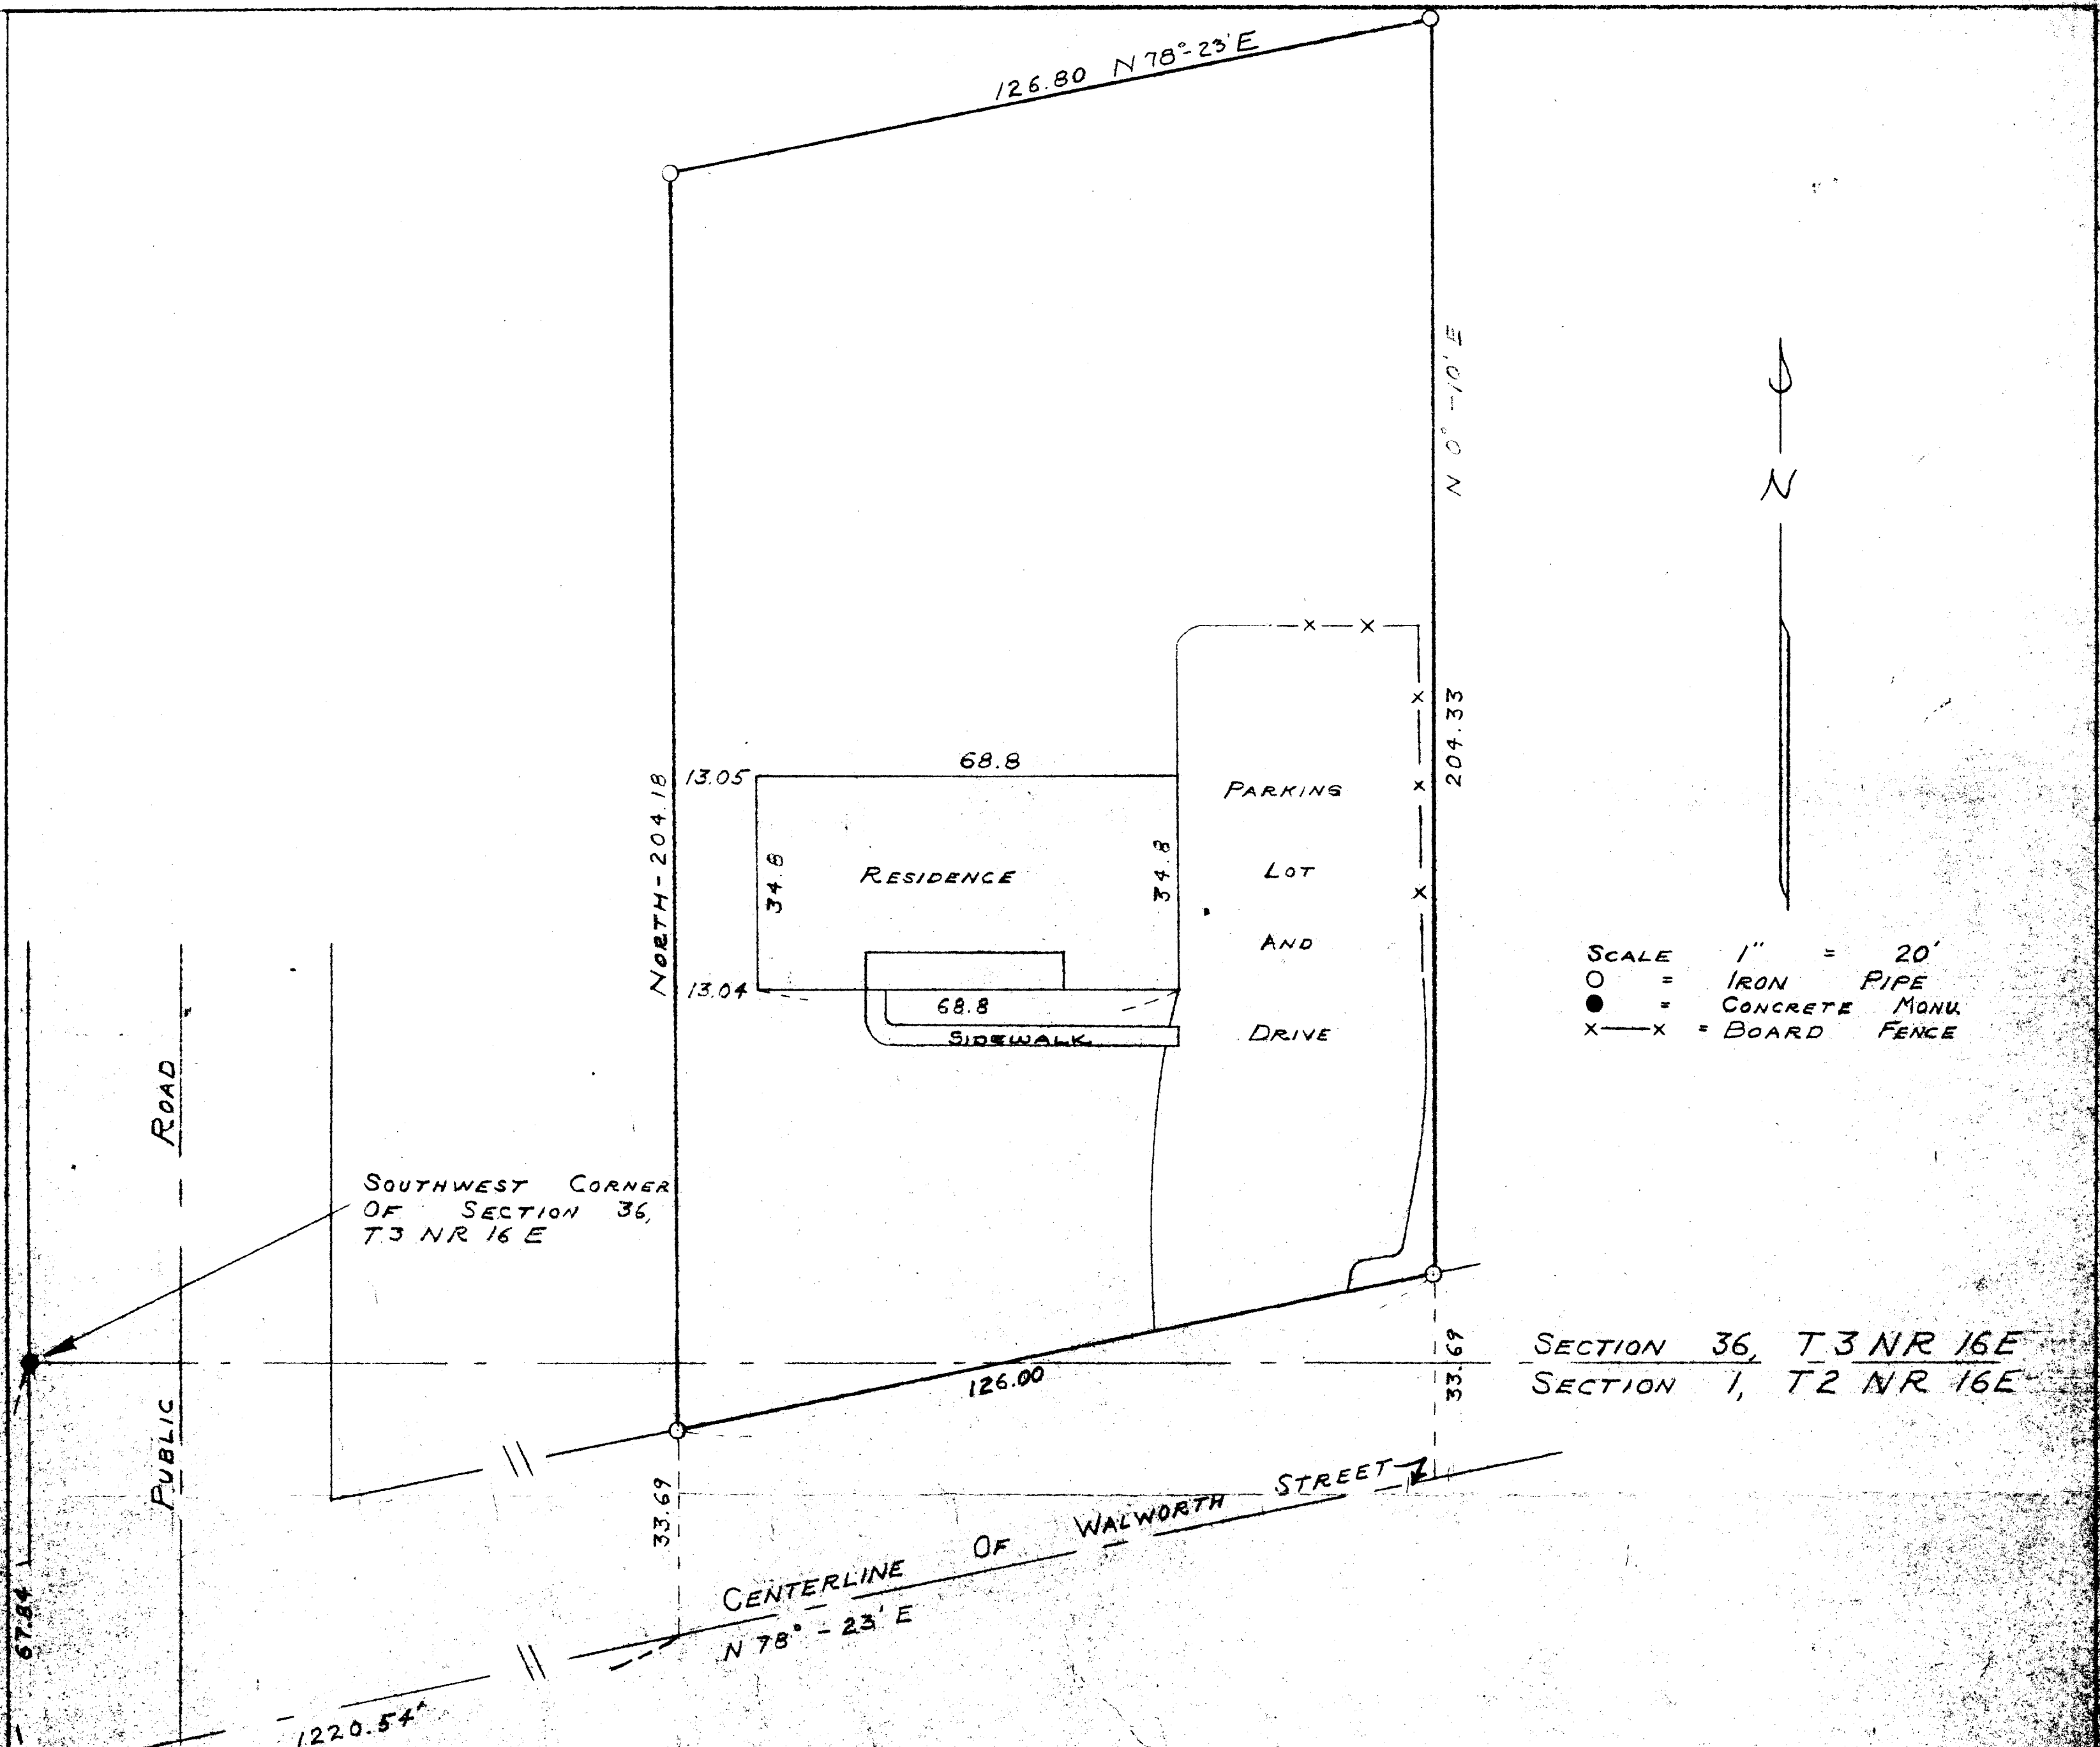

STATE OF WISCONSIN)
WALWORTH COUNTY) SS

I, LLOYD L. JENSEN DO HEREBY CERTIFY THAT I
HAVE SURVEYED THE PROPERTY SHOWN HEREON, AND THAT
THE PLAT ABOVE IS A CORRECT REPRESENTATION OF
THE PROPERTY LINES AND PRINCIPAL LINES OF BUILDINGS
THEREON.

ELKHORN, WISCONSIN, NOVEMBER 8, 1952

Lloyd L. Jensen
SURVEYOR