


KOLB LAND CONSULTING, INC.
 LAND SURVEYING • SUBDIVIDING • LAND PLANNING

LAKE GENEVA, WISCONSIN 53147

WALWORTH STREET

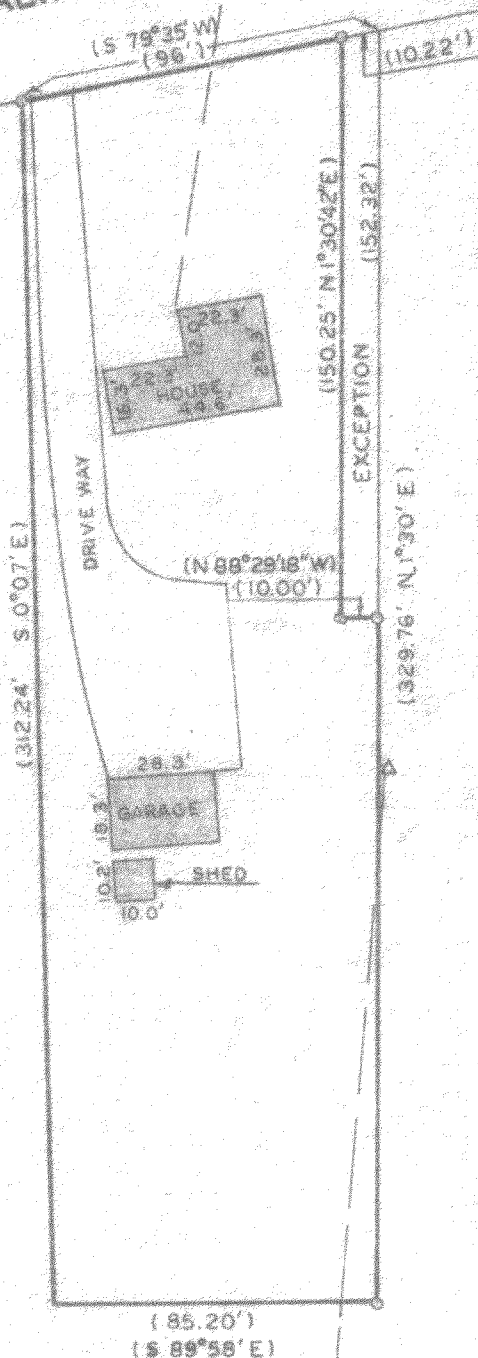

MORTGAGE INSPECTION OF

A PARCEL OF LAND LOCATED IN SECTION 1,
 T 2 N, R 16 E AND IN SECTION 36, T 3 N,
 R 16 E, IN THE CITY OF ELKHORN, WALWORTH
 COUNTY, WISCONSIN.

ORDERED BY: ANCHOR SAVINGS & LOAN
 500 E. WALWORTH AVE.
 DELAVAN, WI 53115

OWNER: BLANCH ENRIGHT

COMPLIANCE WITH A-E 3, 5(F), 6(A), (P), (C),
 (D) AND 7 HAS BEEN WAIVED BY THE CLIENT,
 IN AGREEMENT WITH THE SURVEYOR, AS
 PERMITTED IN A-E5.01(B).

TAX KEY NO. YU SW 0037



SCALE -- 1"=50'

LEGEND

○ IRON PIPE FOUND

() RECORDED AS

— OVERHEAD UTILITY LINES

△ UTILITY POLE

David F. Abell
 DAVID F. ABELL
 WISCONSIN REGISTERED LAND SURVEYOR, S-1596
 DATE FEBRUARY 18, 1985

YU SW-00037

4-350-K