


COOPER SURVEYING SERVICES

Rural - Residential - Commercial

Route 3, Box 255 :: Elkhorn, Wisconsin 53121

Phone (414) 723-6265

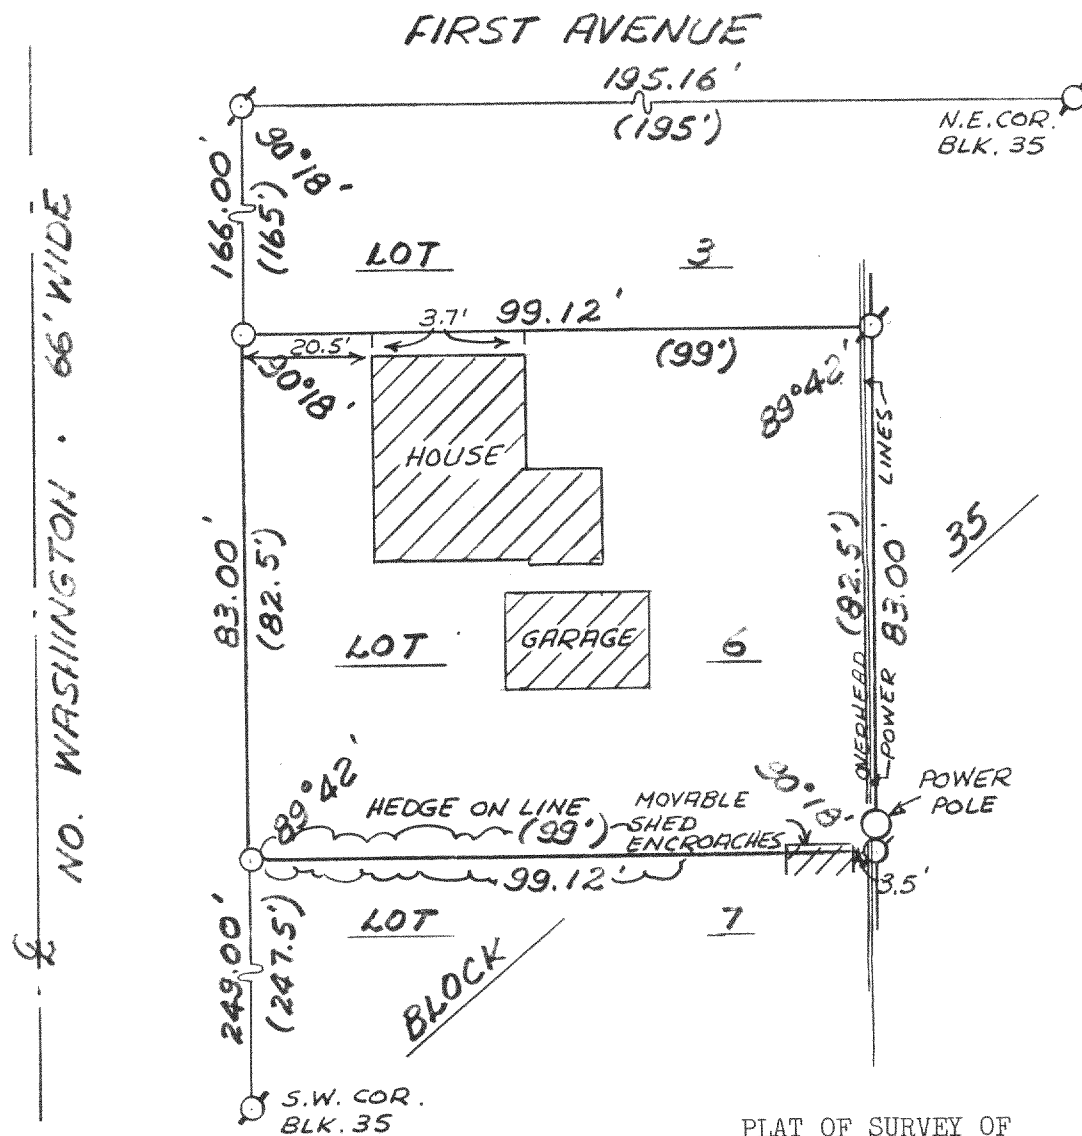

PLAT OF SURVEY OF

LOT 6, BLOCK 35, DAVIS ADDITION, LOCATED
IN THE NORTHEAST 1/4 OF SECTION 36, TOWN
3 NORTH, RANGE 16 EAST, CITY OF ELKHORN,
WALWORTH COUNTY, WISCONSIN.

LEGEND

- — IRON PIPE SURVEY MONUMENT FOUND
- — 1" x 24" IRON PIPE SET
- () — RECORD DIMENSION


ORDERED BY: FIRST STATE SAVINGS

BUYER: MARY S. DUNHAM



I, DANIEL D. COOPER, REGISTERED LAND SURVEYOR, DO HEREBY CERTIFY THAT I HAVE SURVEYED THE PROPERTY DESCRIBED HEREON AND THAT THE MAP SHOWN HEREON IS A TRUE AND ACCURATE REPRESENTATION THEREOF TO THE BEST OF MY PROFESSIONAL KNOWLEDGE AND BELIEF.

Daniel D. Cooper
Daniel D. Cooper, RLS No. 1464
Dated this 20 day of June, 1984.

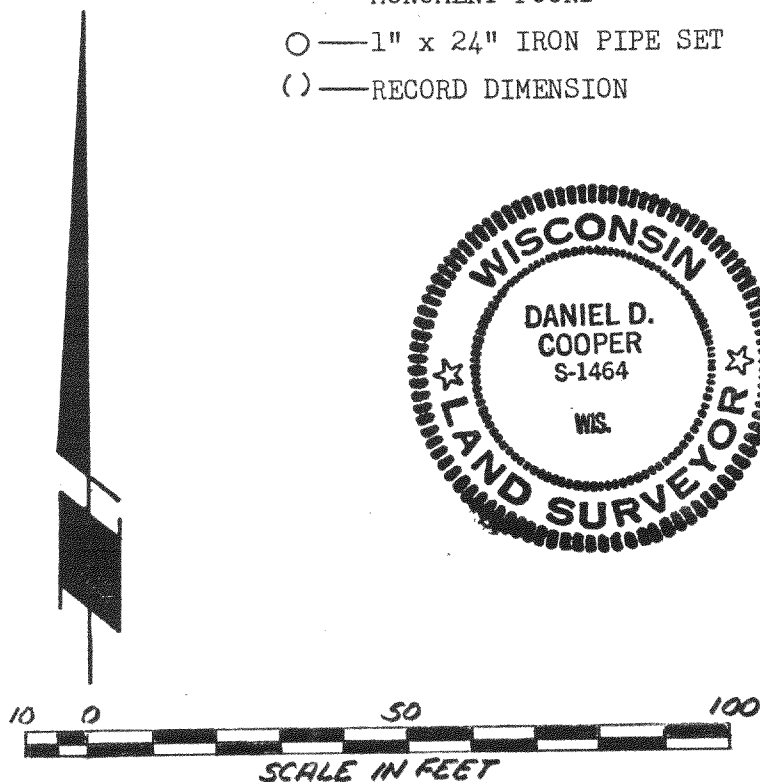

PROJ. NO. 1940

YD-00001D

4-352