


COOPER SURVEYING SERVICES

Rural - Residential - Commercial

Route 3, Box 255 :: Elkhorn, Wisconsin 53121

Phone (414) 723-6265

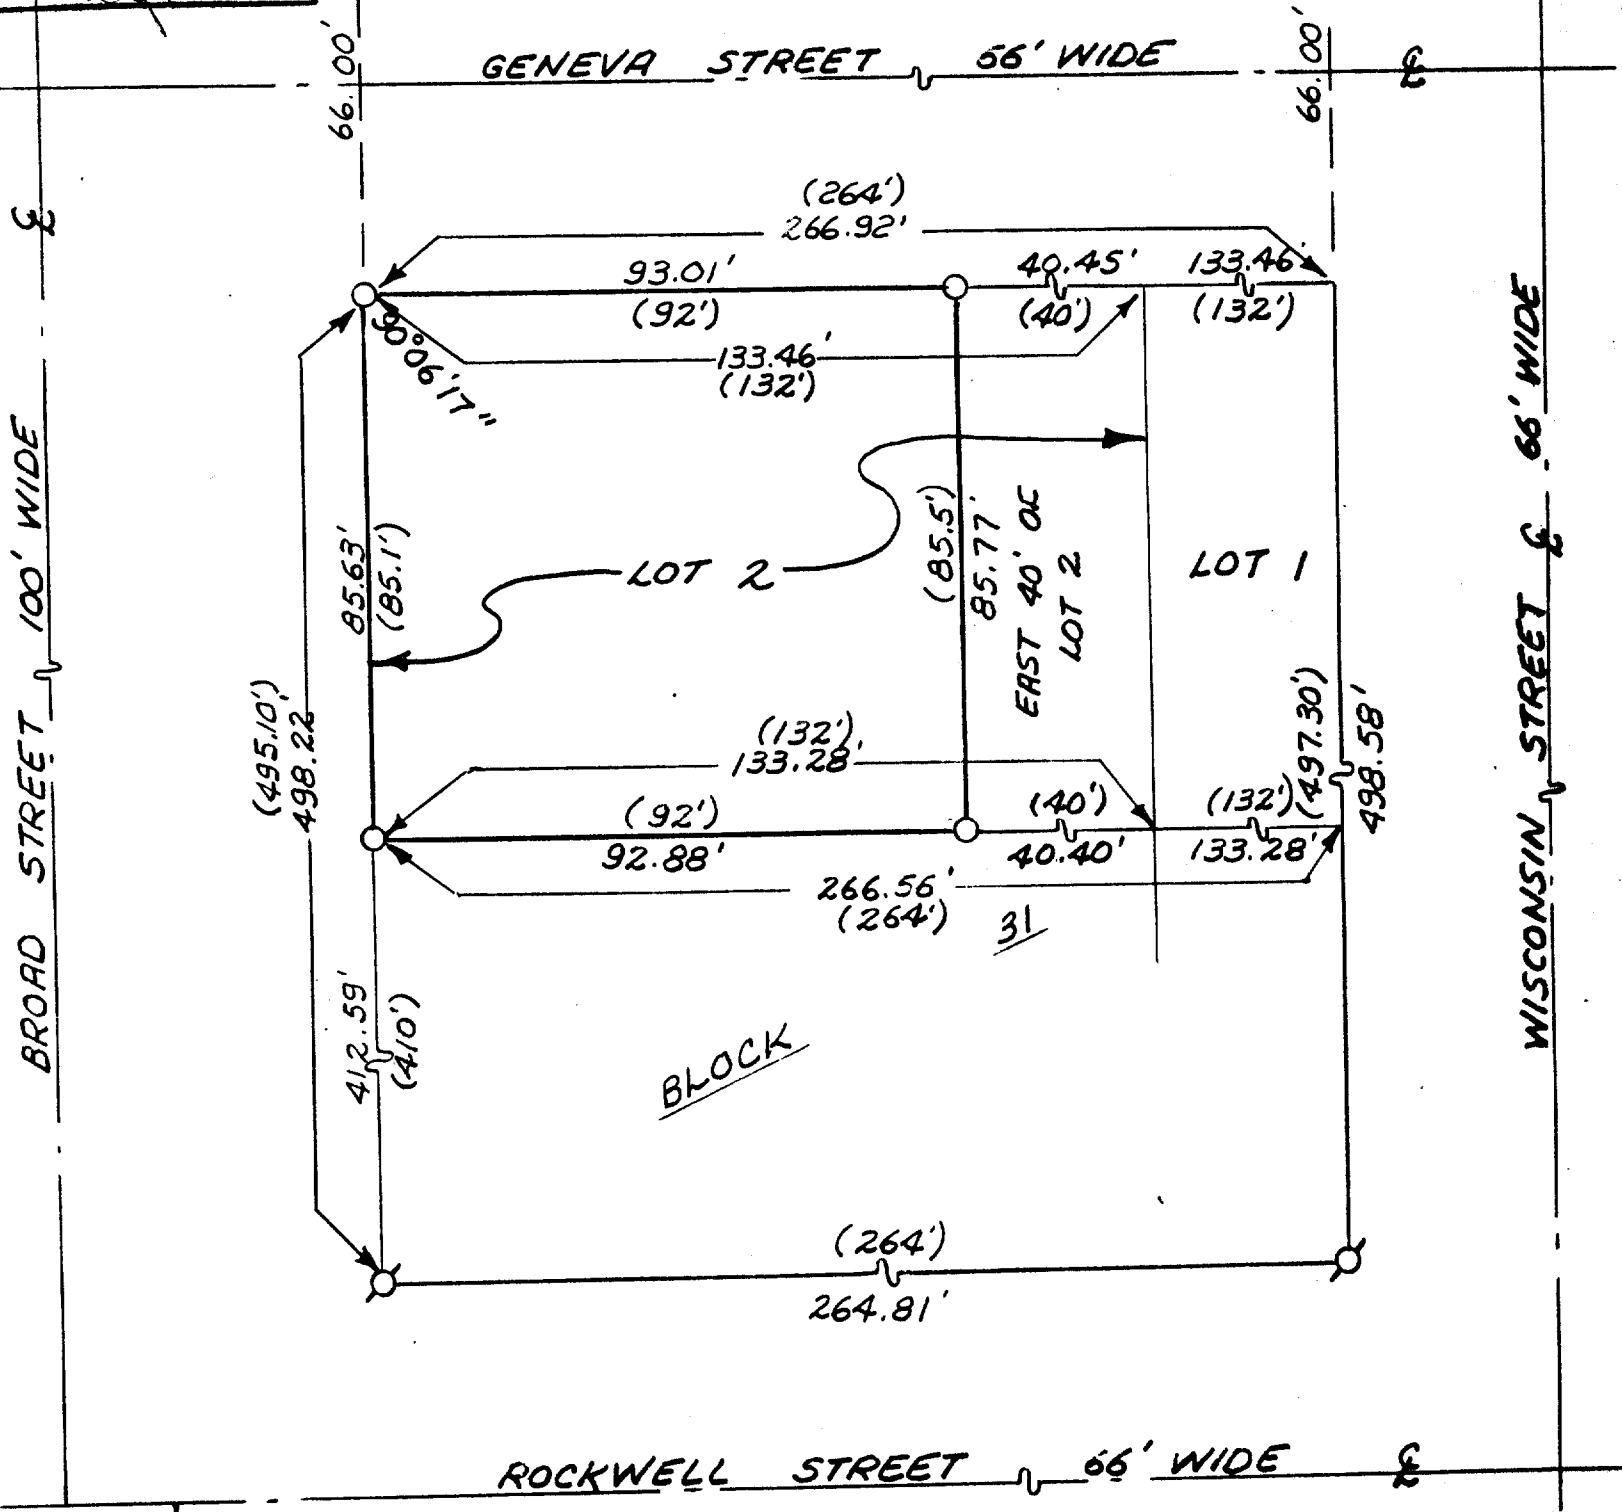


PLAT OF SURVEY OF

LOT 2, BLOCK 31, EXCEPT THE EAST 40 FEET THEREOF, ROCKWELL'S ADDITION LOCATED IN THE SOUTHEAST 1/4 OF SECTION 36, TOWN 3 NORTH, RANGE 16 EAST, CITY OF ELKHORN, WALWORTH COUNTY, WISCONSIN.

ORDERED BY:
THOMAS J. PIDCOCK

LEGEND

- — IRON PIPE FOUND
- — 1" x 24" IRON PIPE SET
- () — RECORD DIMENSION

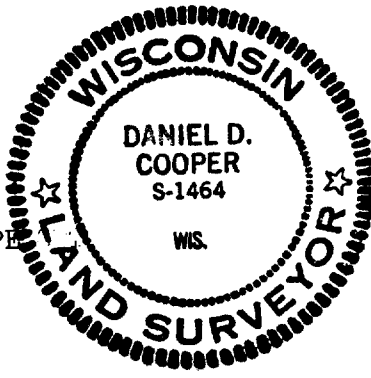

I, DANIEL D. COOPER, REGISTERED LAND SURVEYOR, DO HEREBY CERTIFY THAT I HAVE SURVEYED THE PROPERTY DESCRIBED HEREON AND THAT THE MAP SHOWN HEREON IS A TRUE AND ACCURATE REPRESENTATION THEREOF TO THE BEST OF MY PROFESSIONAL KNOWLEDGE AND BELIEF.

Daniel D. Cooper
DANIEL D. COOPER, RLS NO. 1464

DATED THIS 10 DAY OF July, 1984.



PROJ. NO. 1932