


60-230

4-32

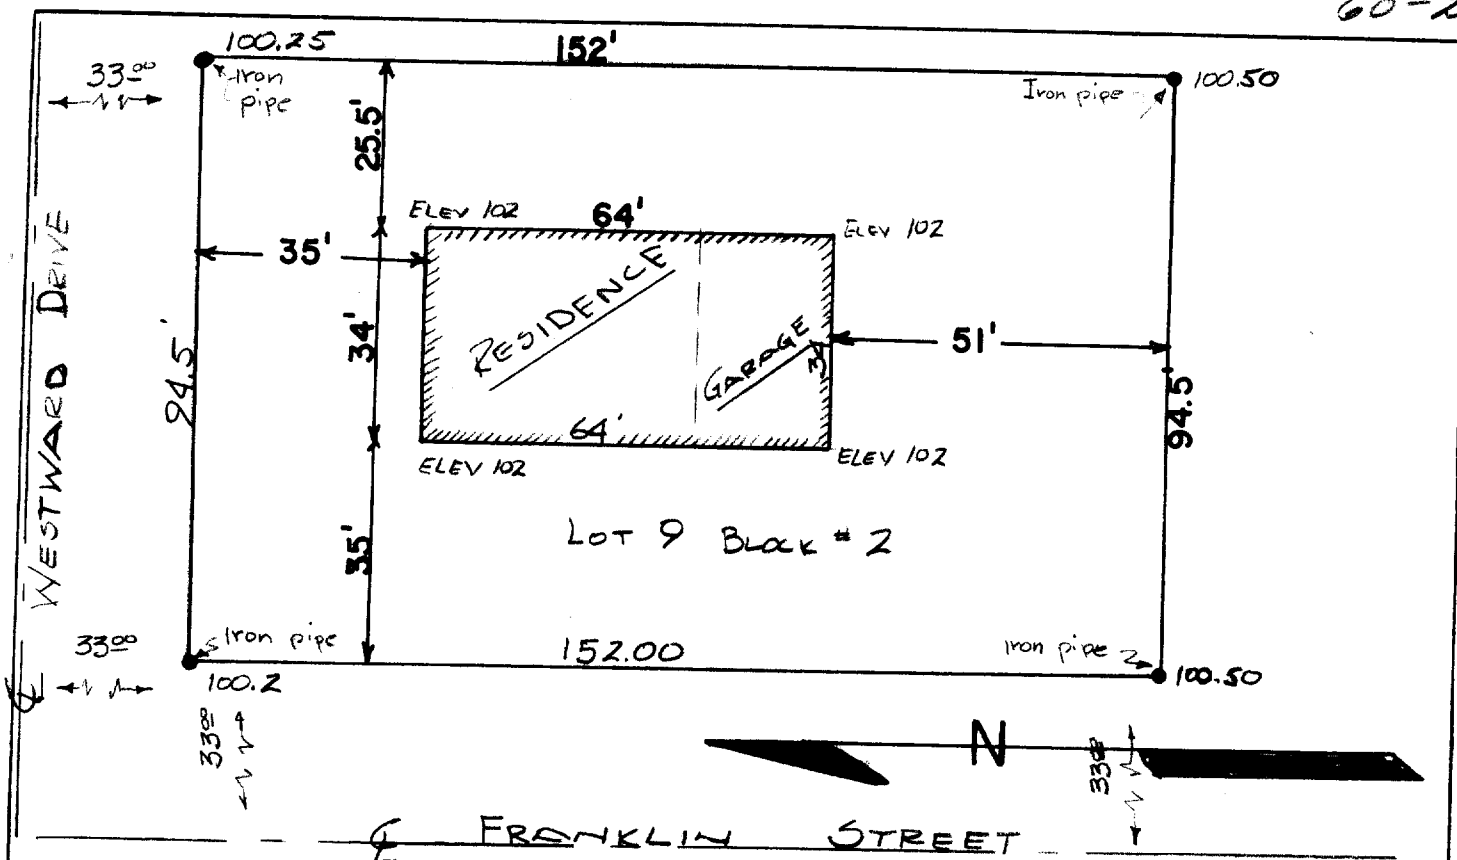


DESCRIPTION: Lot #9 and the West 5.40 feet of lot #8 of block #2 James Jones 2nd. Addition to the City of Elkhorn, Walworth County, Wisconsin.

CERTIFICATE: I James F. Biagi, surveyor, do hereby certify that I have surveyed the property hereon described, and the location of the improvements are as shown on the plat.

SIGNED AND SEALED THIS 1ST DAY OF JUNE 1960.

James F. Biagi
James F. Biagi RLS 272

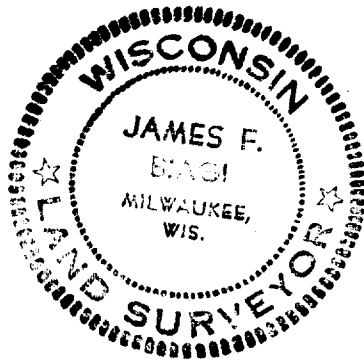

60-230

YJA 2-24

4-35 B