


HAROLD H. KOLB

REGISTERED PROFESSIONAL LAND SURVEYOR
LAKE GENEVA, WISCONSIN

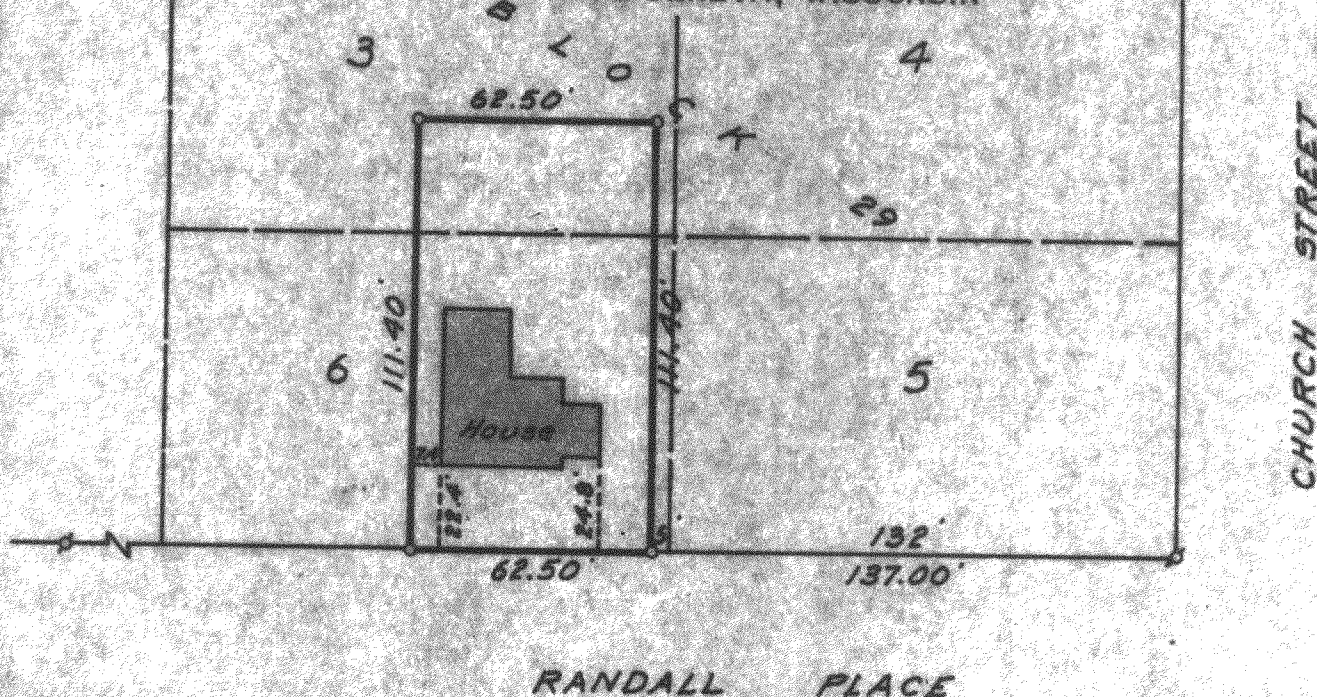

PLAT OF SURVEY OF

A parcel of land located in Lots 3 and 6, Block 29, Rockwell's Addition to the Village, now City of Elkhorn, Walworth County, Wisconsin and described as follows; to-wit:

Beginning at a point 5 feet West of the Southeast corner of Lot 6 in Block 29 of Rockwell's Addition to the Village, now City of Elkhorn; running thence North at right angles with the South line of said lot to the North line of said Lot 6; and continuing Northward in the same line the further distance of 30 feet; thence West parallel with the South line of said Lot 6, 62½ feet to a point; thence South at right angles 111.2 feet (field distance 111.40 feet) to the South line of said Lot 6; thence East along the South line of said Lot 6, 62½ feet to the place of beginning.

N



Scale 1"=50'

LEGEND

- IRON PIPE FOUND
- — IRON PIPE PLACED
- — CONCRETE MONUMENT
- x — SPIKE

I, HAROLD H. KOLB, DO HEREBY CERTIFY THAT I HAVE SURVEYED THE PROPERTY HEREON DESCRIBED ACCORDING TO THE OFFICIAL RECORDS, AND THAT THE PLAT HEREON IS A CORRECT REPRESENTATION OF THE LOT LINES, and the principle lines of the buildings thereon.

Harold H. Kolb

HAROLD H. KOLB

WISCONSIN REGISTERED LAND SURVEYOR, S-187

DATE January 18, 1965

YRW 33

4-36