


PLAT OF SURVEY FOR SLATTERY & MILLARD

(B) The East 1/2 of Lot 11 in Block 7 in the Original Plat of The Village (new City) of Eikhorn, according to the recorded plat of said village, reserving, however, a right of way for pedestrians, animals or vehicles over a strip of land of uniform width 3 feet wide off the entire East side of the East 1/2 of said Lot 11, and granting a right of way over a strip of land of uniform width of 3 feet wide off the entire west side of Lot 12, in said Block, said 6 foot right of way to be used in common by the owner and occupants from time to time of said adjoining premises and their families, employees and guests.


I hereby certify that I have surveyed the above described property and that the above map is a true representation thereof and shows the size and location of all buildings thereon, boundary fences, apparent easements, roadways and visible encroachments, if any. This survey is made for the use of the present owners of the property, and also those who purchase, mortgage, or guarantee the title thereto within one (1) year from the date hereof.

Robert A. Farris
Robert A. Farris, R.L.S.
Dated this 1st day of November, 1984

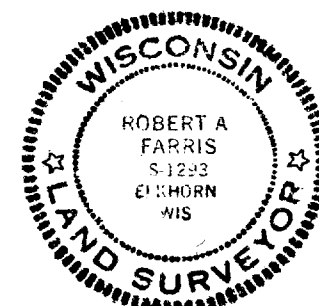


LEGEND

- O — SET PIPE
 ⦶ — FOUND IRON PIPE
 ⦶ — FOUND IRON ROD
 (xxx) — RECORD DIMENSION

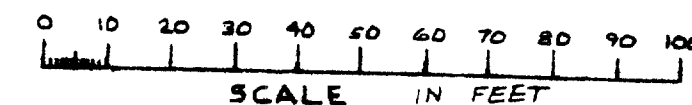


LOCATION	DRAWING
1	
2	
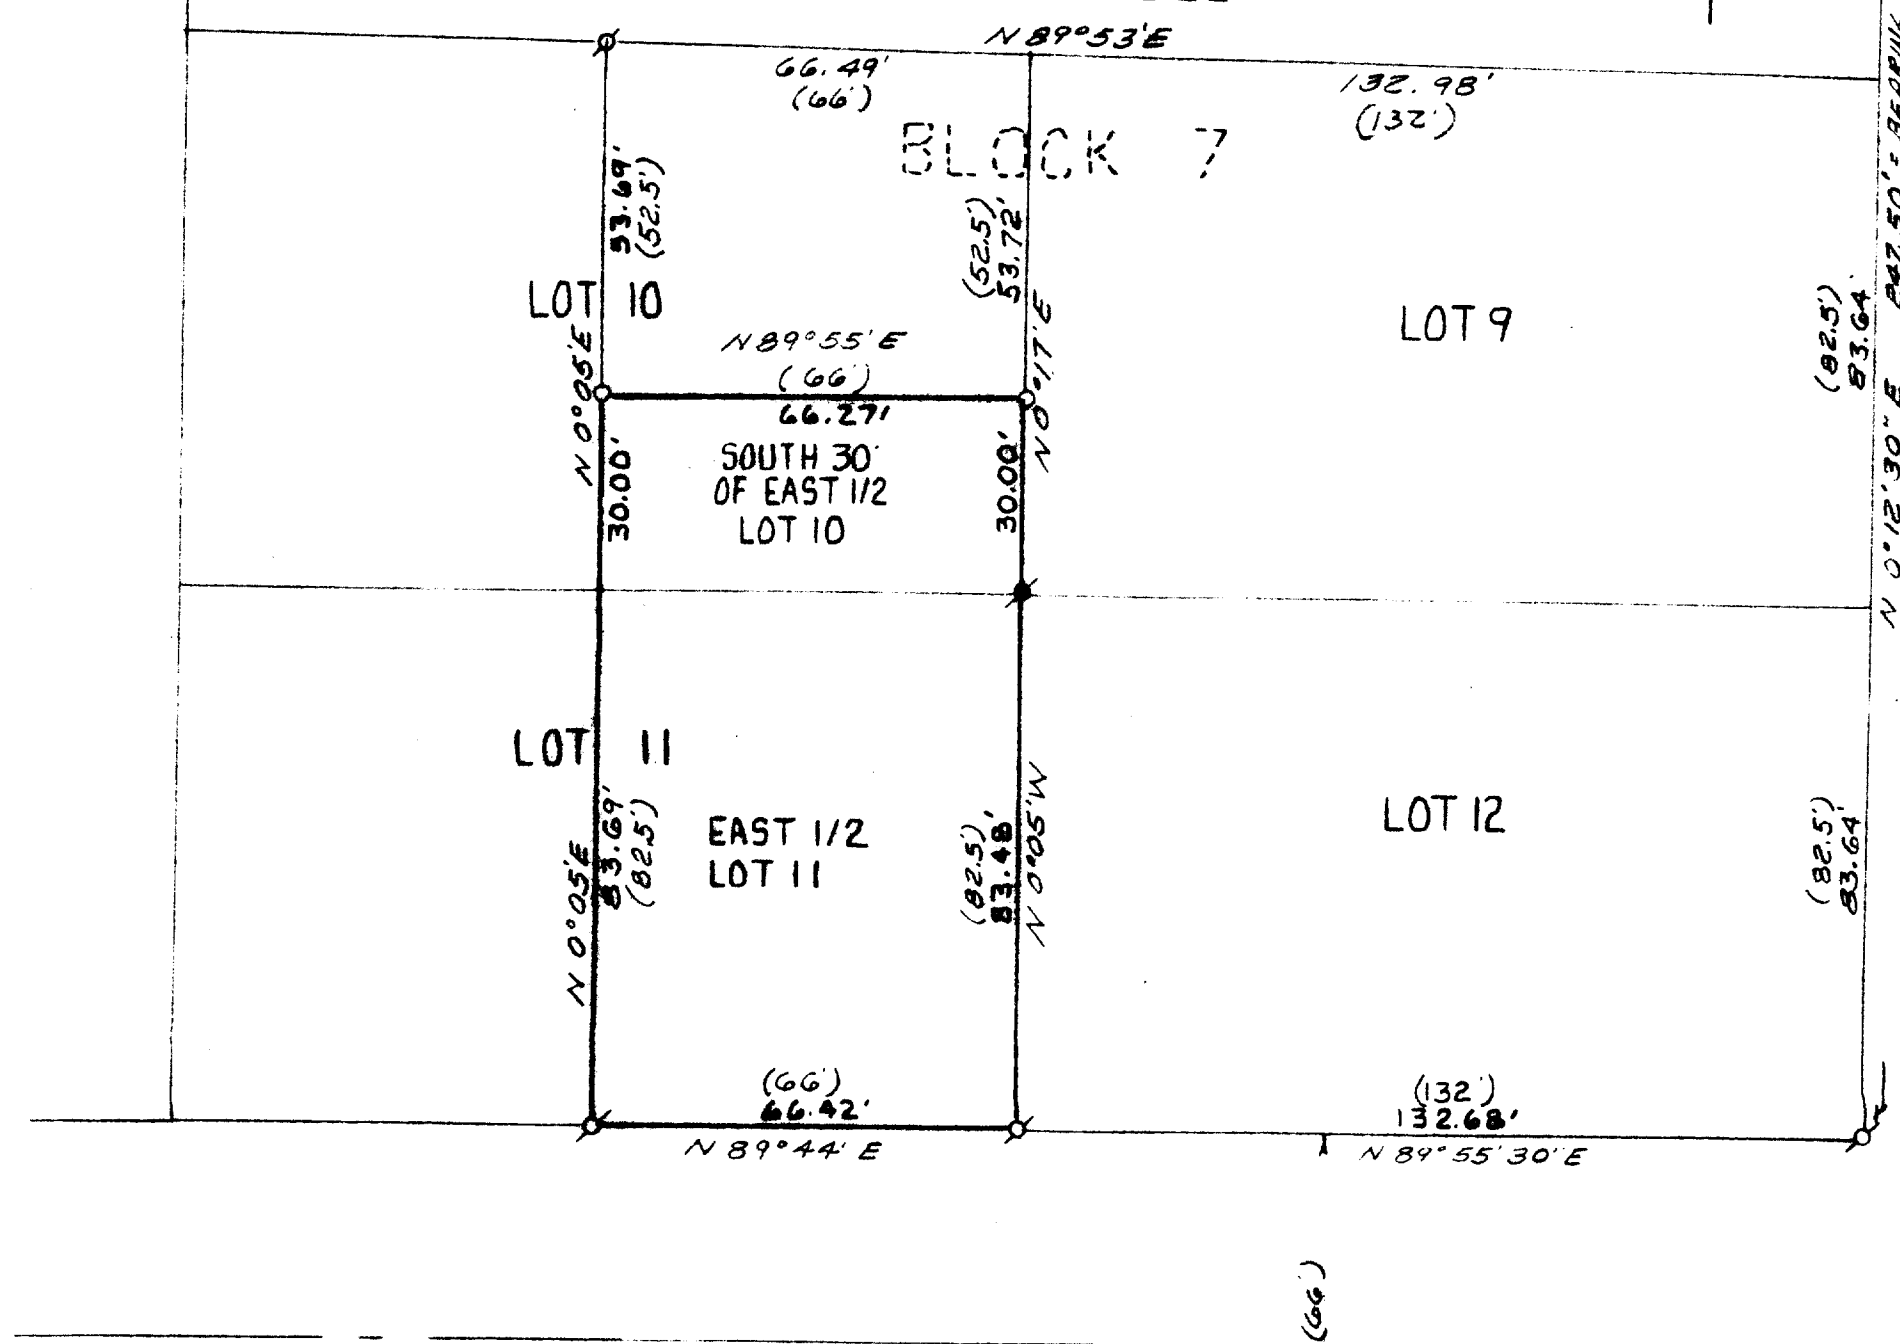

JEFFERSON STREET

PROJ # 2329

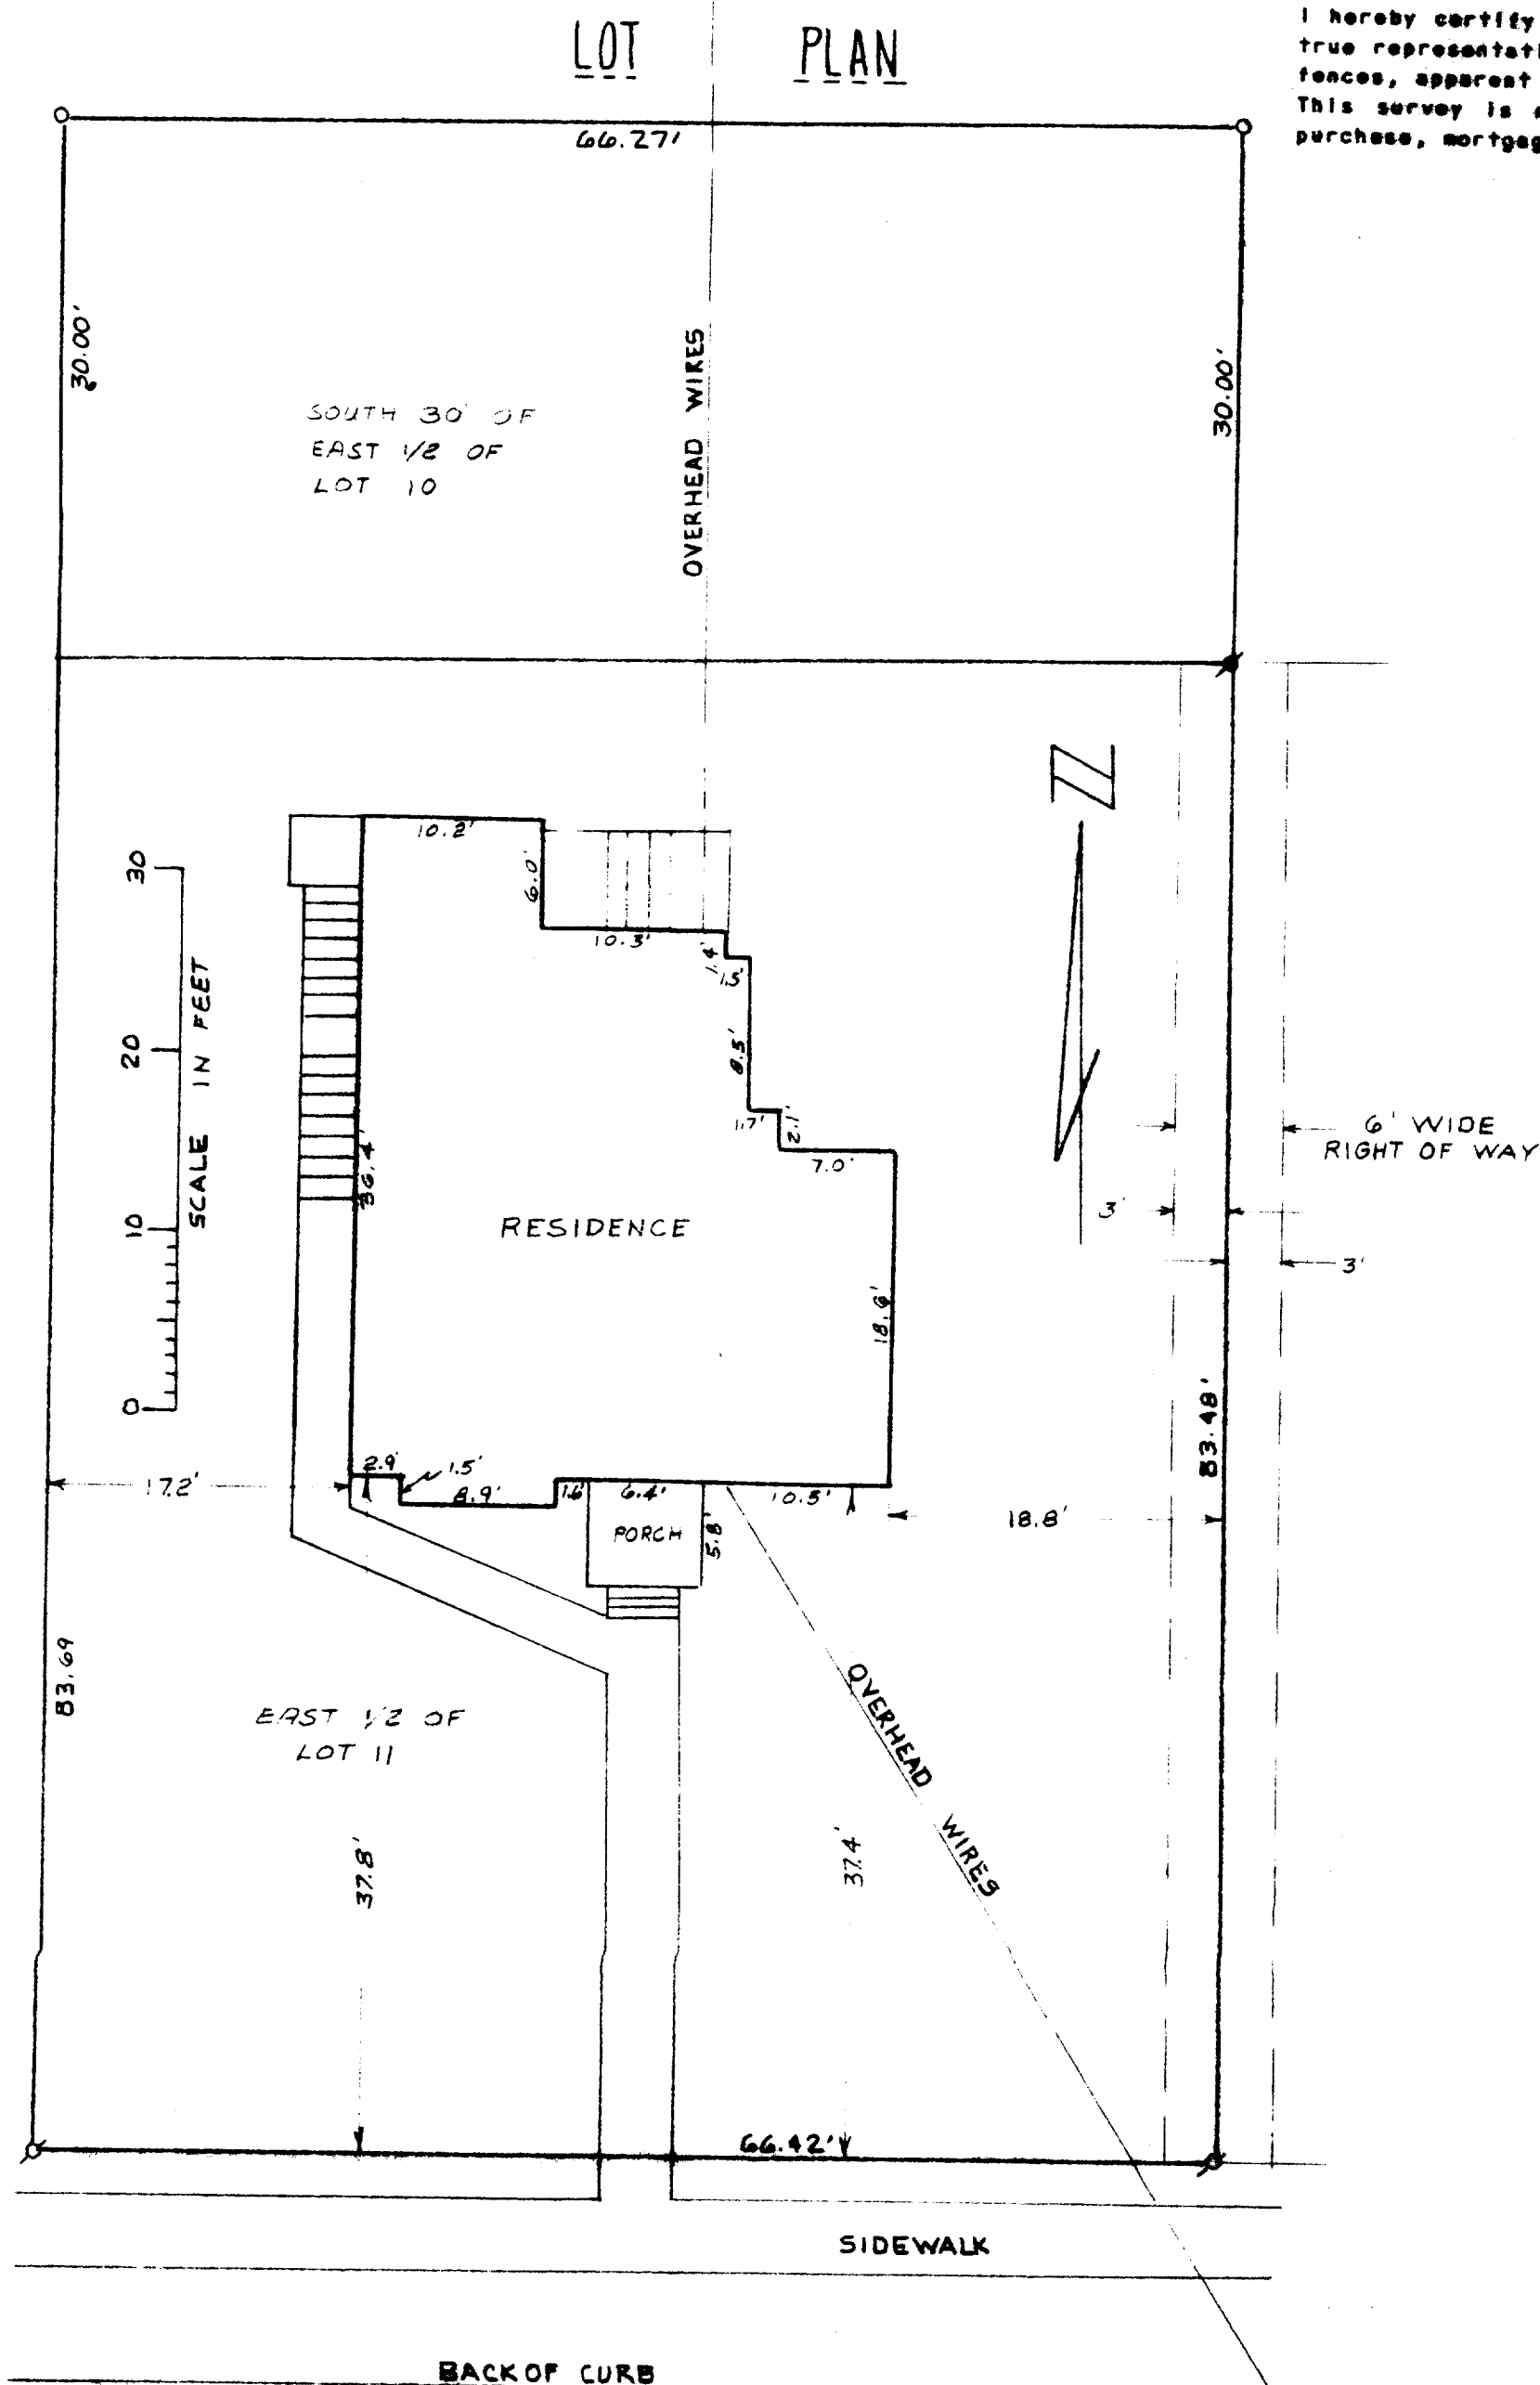

YOP-00025

11-364 ✓