



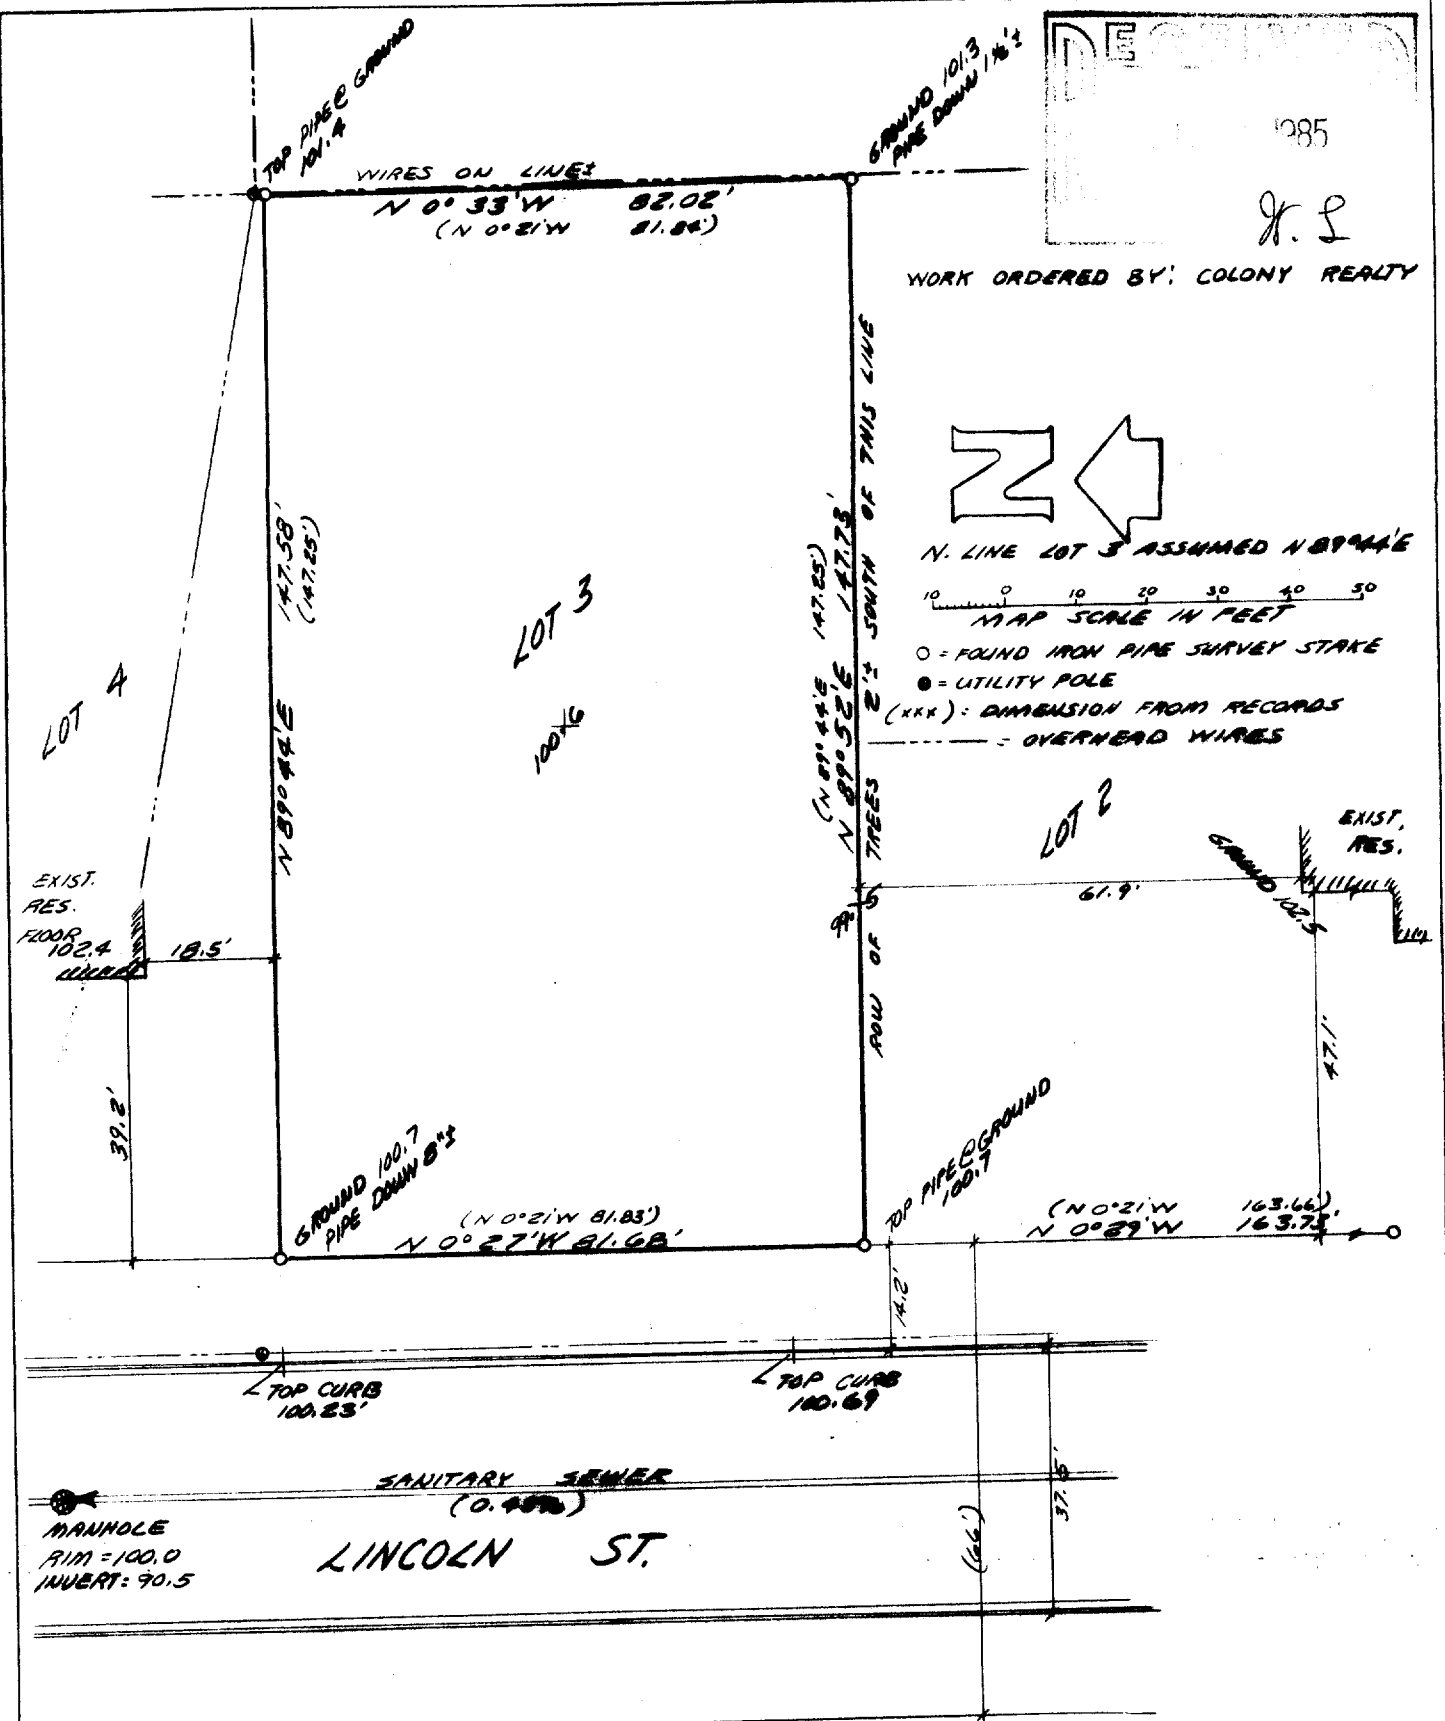

PLAT OF SURVEY OF LOT 3, BLOCK 1 OF TREETOWN'S SUBDIVISION
 LOCATED IN NW 1/4 OF SEC. 31, T. 3N., R. 17E. CITY OF ELKHORN,
 WALWORTH COUNTY, WISCONSIN

I hereby certify that I have surveyed the above
 described property and that the above map is a true
 representation thereof and shows the size and
 location of the property, its exterior boundaries,
 the location of all visible structures and
 dimensions of all principal buildings thereon,
 boundary fences, apparent easements, roadways and
 visible encroachments, if any.
 This survey is made for the use of the present
 owners of the property, and also those who purchase,
 mortgage, or guarantee the title thereto within one
 (1) year from the date hereof.

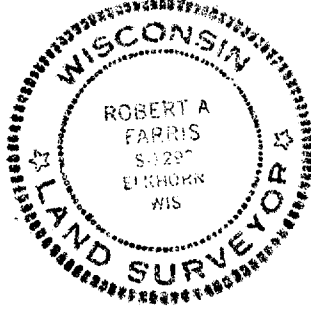

ERRIS, HENRI & ASSOCIATES, INC.
 1 Midway Court - P.O. Box 487
 Elkhorn, Wisconsin
 414-722-2000

DATED 7/8/85

PROJ. # 2432

4-368-F