


#32-64

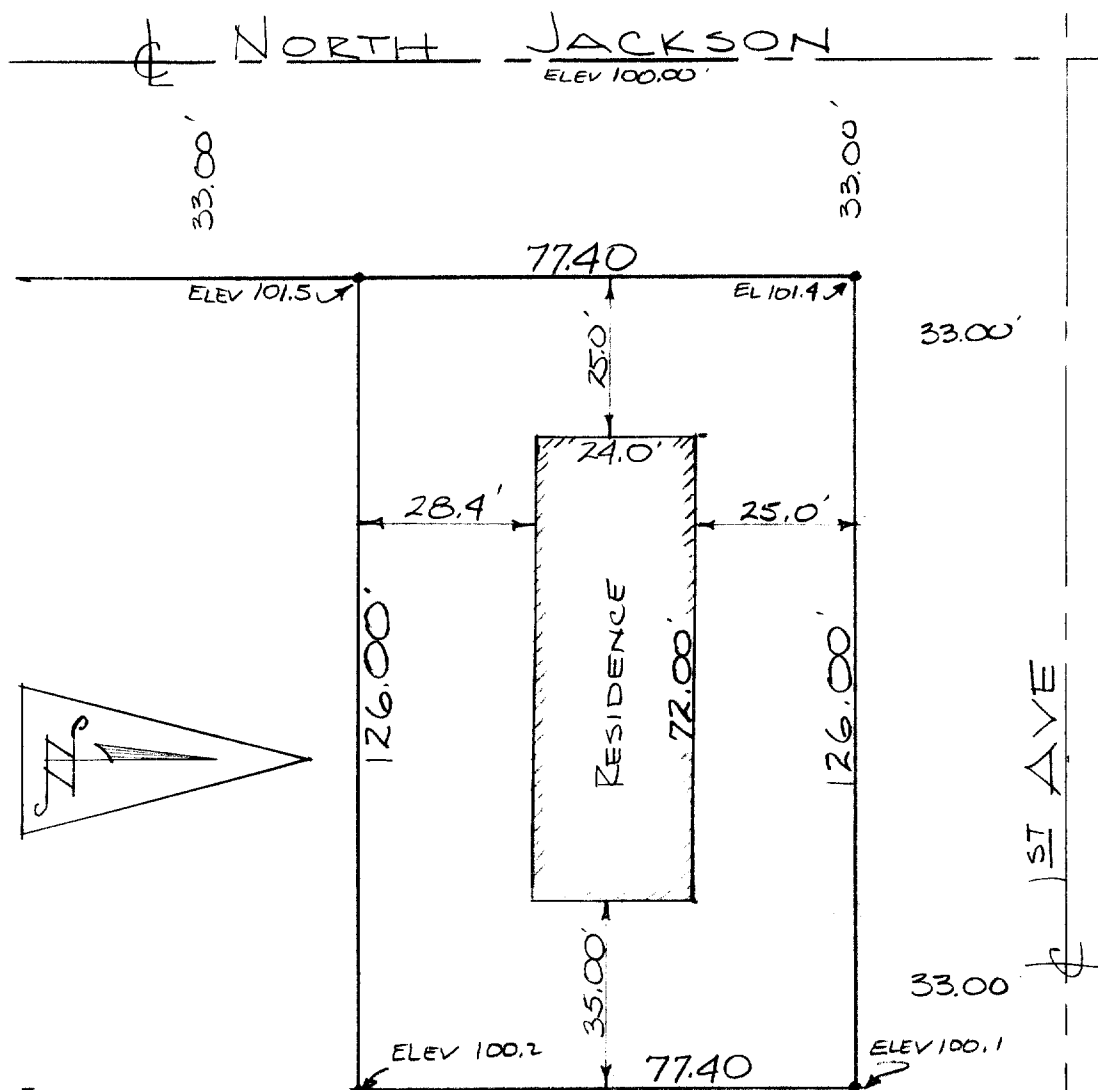

DESCRIPTION:

Lot 1, Block 2, Fairlane Subdivision of a portion of the City of Elkhorn, Walworth County, Wisconsin.

CERTIFICATE:

I, James F. Biagi, surveyor do hereby certify that I have surveyed the property hereon described and that the location of all the improvements are as shown on the drawing above

April 14th 1961.

James F. Biagi, RLS 272