



Surveying • Modular Zones

PLAT OF SURVEY OF LOT 5, GREEN ACRES SUBDIVISION,
LOCATED IN SECTION 8, TOWN 2 NORTH, RANGE 17 EAST,
WALWORTH COUNTY, WISCONSIN

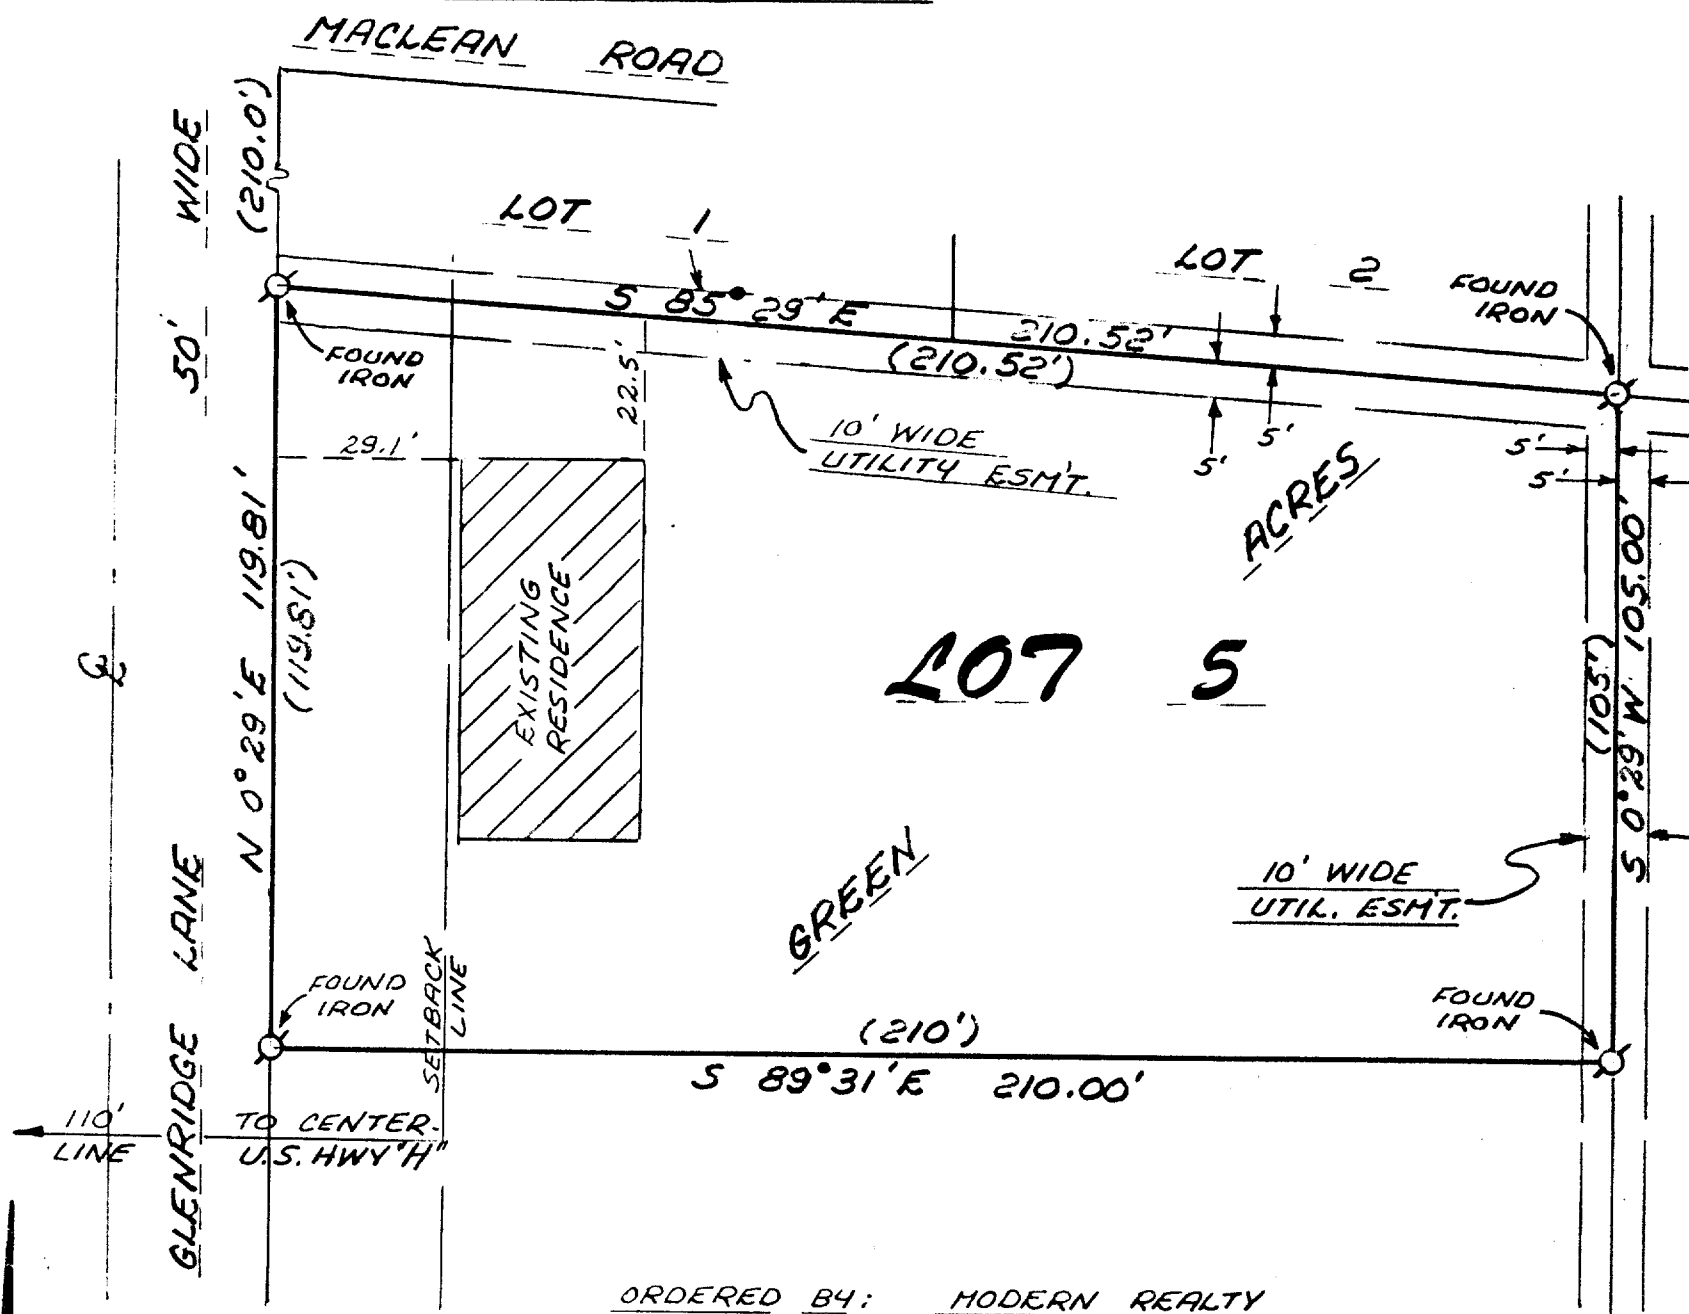


LEGEND
 ○ - 1" DIA IRON PIPE FOUND
 () - RECORD DIMENSION

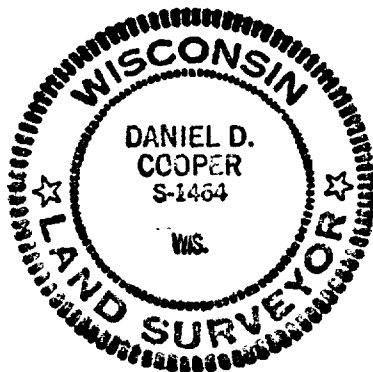

I, DANIEL D. COOPER, REGISTERED SURVEYOR, DO HEREBY CERTIFY THAT I HAVE SURVEYED THE PROPERTY DESCRIBED HEREON AND THAT THE MAP SHOWN HEREON IS A TRUE AND ACCURATE REPRESENTATION THEREOF TO THE BEST OF MY PROFESSIONAL KNOWLEDGE AND BELIEF.

DATED THIS 29 DAY OF Sept., 1984

DANIEL D. COOPER, RLS NO. S-1464

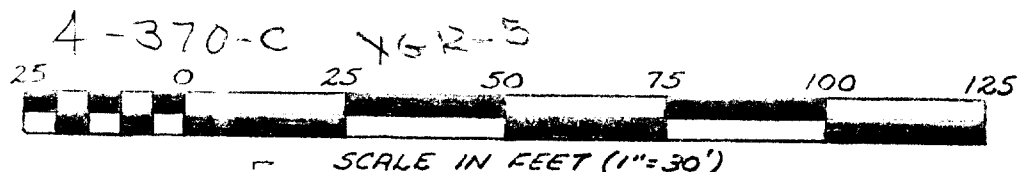

PROJECT NO. 1979