



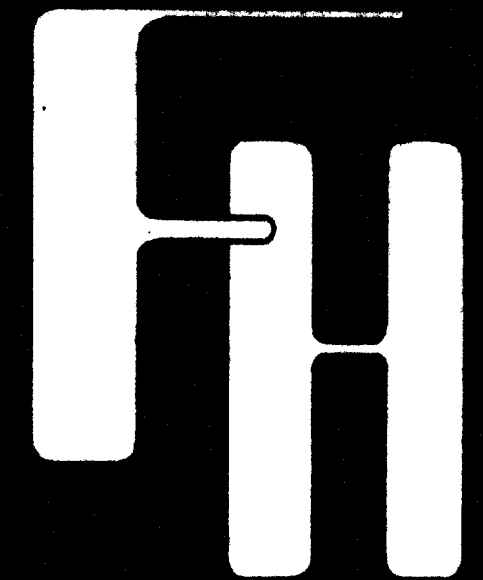

FARRIS, HANSEN & ASSOCIATES, INC.
Engineering, Surveying and Land Planning
715 W. Walworth St. P. O. Box 487
ELKHORN, WISCONSIN 53121
Office: (414) 723-2098

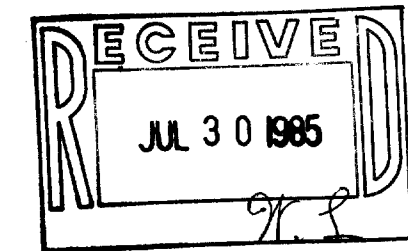

LOT 5 BLOCK 10

RESIDENCE

GRASS

GRAVEL DRIVEWAY

RECORDED AS 132'

GRASS AREA

14" WIDE CONCRETE CURB

GRAVEL DRIVEWAY

GRASS

RESIDENCE

LOT 8 BLOCK 10

NOTE: IRON PIPE STAKES FOUND AT 'A', 'B', & 'C' APPEAR TO HAVE BEEN PLACED BY SOMEONE WHO MEASURED THE RECORDED DISTANCE NORTH FROM JEFFERSON ST. DISREGARDING THE RECORDS OF FORMER CITY ENGINEER THUBBS WHICH INDICATE THAT THE LOTS IN BLOCK 10 ARE SUBSTANTIALLY LARGER THAN THE ORIGINAL PLAT DIMENSIONS SHOW. MORE SUCH STAKES HAVE BEEN REPORTED BY OTHER SURVEYORS ON THE WEST SIDE OF BLOCK 10.

FOUND IRON ROD STAKE SET BY SURVEYOR K. ABERNATHY IN DECEMBER 1954 IN AGREEMENT WITH FORMER CITY ENGINEER THUBBS' RECORDS

AT THIS POINT THE TEXTURE OF THE CONCRETE SIDEWALK CHANGES INDICATING THE WALK NORTH & SOUTH OF THIS LINE WAS PROBABLY BUILT AT DIFFERENT TIMES OR BY DIFFERENT CONTRACTORS OR BOTH AS IS OFTEN THE CASE AT OR NEAR PROPERTY LINES.



FOUND IRON PIPE STAKE UNDER GRAVEL DRIVE 'A'

LOT 6
FOUND IRON ROD STAKE FLUSH SET BY SURVEYOR T. JENSEN, MAY 1979 IN AGREEMENT WITH FORMER CITY ENGINEER THUBBS' RECORDS

FOUND IRON PIPE STAKE PROTECTING 1" ABOVE GROUND AGAINST EAST FACE OF POST 'B'

LOT 7

5" DIA. WHITE WOOD POSTS

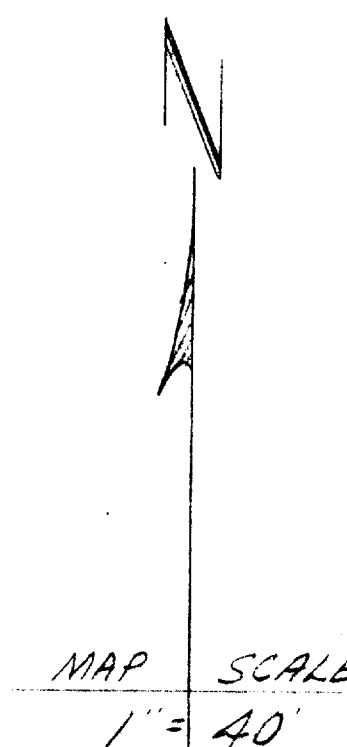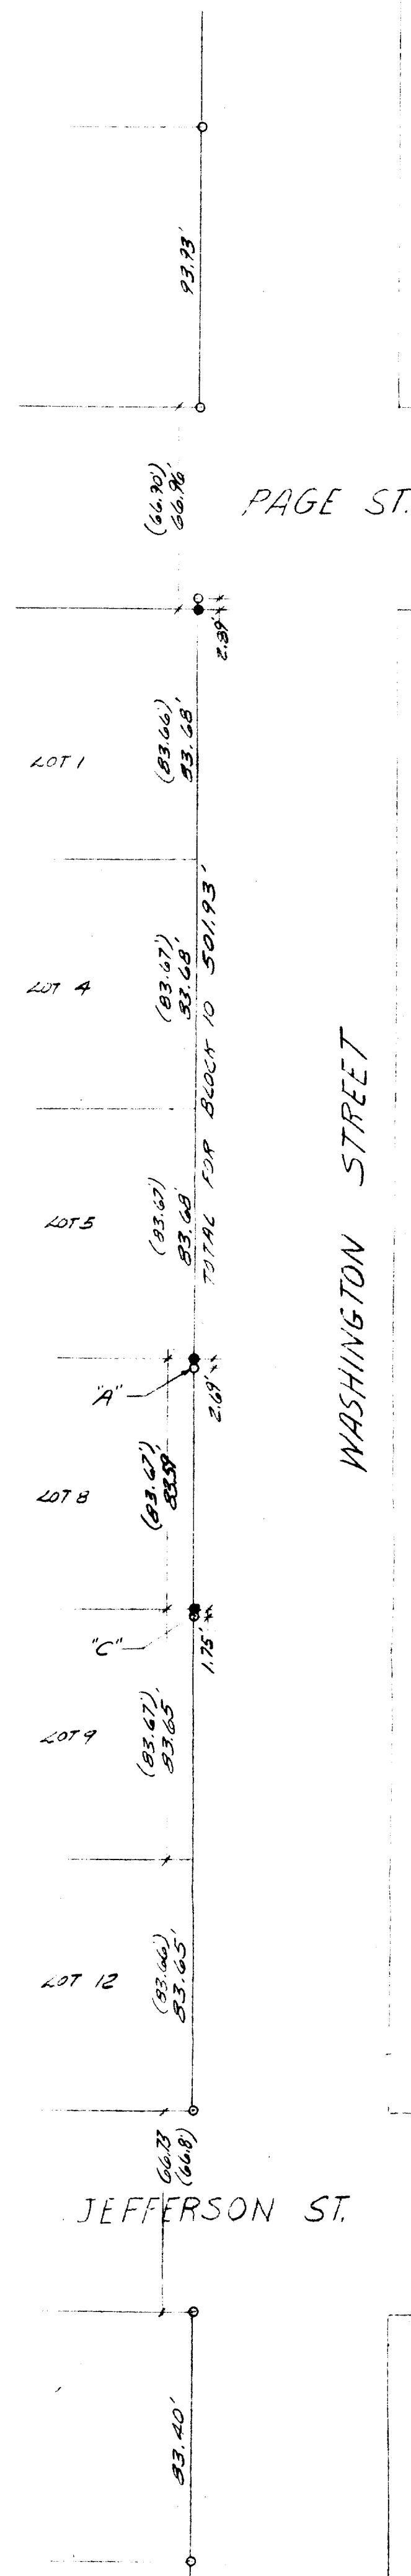


SURVEY OF EAST LINE OF BLOCK 10, ORIGINAL PLAT OF ELKHORN

○ = IRON PIPE STAKE FOUND
● = IRON ROD STAKE FOUND
ALL STAKES IN A STRAIGHT LINE ± 2 INCHES

I HEREBY CERTIFY THAT I HAVE SURVEYED THE EAST LINE OF BLOCK 10 ORIG. PLAT ELKHORN AND LOCATED DETAILS ALONG THE LINE BETWEEN LOT 5 AND LOT 8 IN SAID BLOCK AND THAT THIS MAP IS A TRUE REPRESENTATION OF SAID SURVEY TO THE BEST OF MY PROFESSIONAL KNOWLEDGE AND BELIEF.

Robert A. Farris

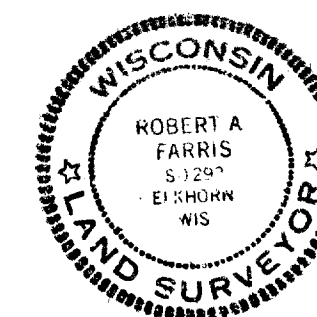

MAP OF OCCUPATION ALONG THE LOT LINE BETWEEN LOT 5 & LOT 8 OF BLOCK 10 OF THE ORIGINAL PLAT OF ELKHORN, WALWORTH COUNTY, WISCONSIN FOR MARIE A. CHRISTNER

DATE 5/10/85	DRAWN BY RF	REVISIONS	BY	DATE	PROJECT NO. 2389
SCALE AS NOTED	CHECKED BY				LAST REVISION
	APPROVED BY				SHEET NO.