


HAROLD H. KOLB

REGISTERED PROFESSIONAL LAND SURVEYOR
LAKE GENEVA, WISCONSIN

ROCKWELL ST.

BROAD STREET

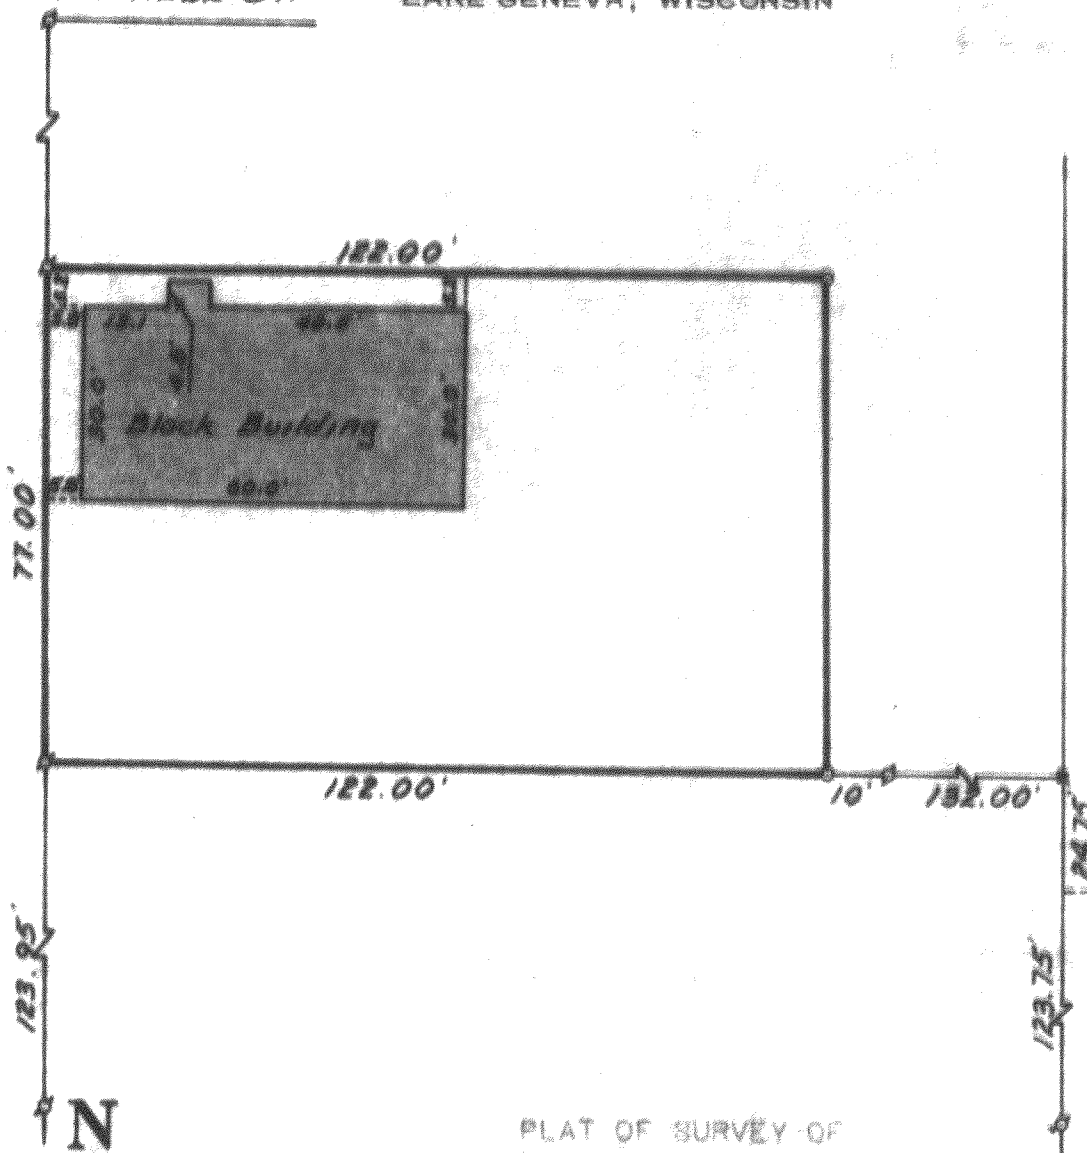

WISCONSIN STREET

BLOCK 48
ROCKWELLS 2ND ADDITION



SCALE 1" = 30'
LEGEND

- ⊘ - IRON PIPE FOUND
- - IRON PIPE PLACED
- - CONCRETE MONUMENT
- × - SPIKE FOUND
- ⊕ - CROSS IN CONC. FOUND

PLAT OF SURVEY OF

A parcel of land located in the North-east 1/4 of Section 1, T 2 N, R 16 E, City of Elkhorn, Walworth County, Wis.

I, HAROLD H. KOLB, DO HEREBY CERTIFY THAT I HAVE SURVEYED THE PROPERTY HEREON DESCRIBED ACCORDING TO THE OFFICIAL RECORDS, AND THAT THE PLAT HEREON IS A CORRECT REPRESENTATION OF THE LOT LINES, and the principle lines of the buildings thereon.

Harold H. Kolb

HAROLD H. KOLB

WISCONSIN REGISTERED LAND SURVEYOR, S-187

DATE October 5, 1965

4-38