
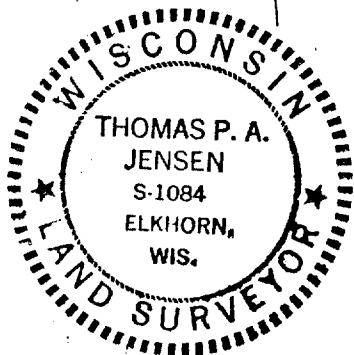



PLAT OF SURVEY OF LOT 3 BLOCK 1 OF OLSEN'S ADDITION TO THE CITY OF ELKHORN LOCATED IN THE S.E. $\frac{1}{4}$ OF SECTION 36, T3N, R16E, CITY OF ELKHORN, WALWORTH COUNTY WISCONSIN

JENSEN SURVEYING & MAPPING S.C.
P.O. Box 322 - Elkhorn, WI. - 53121
Mapping Date: Oct. 10, 1985

SURVEYED FOR: John Gunyon
121 Eames St.
Elkhorn, WI.
53121

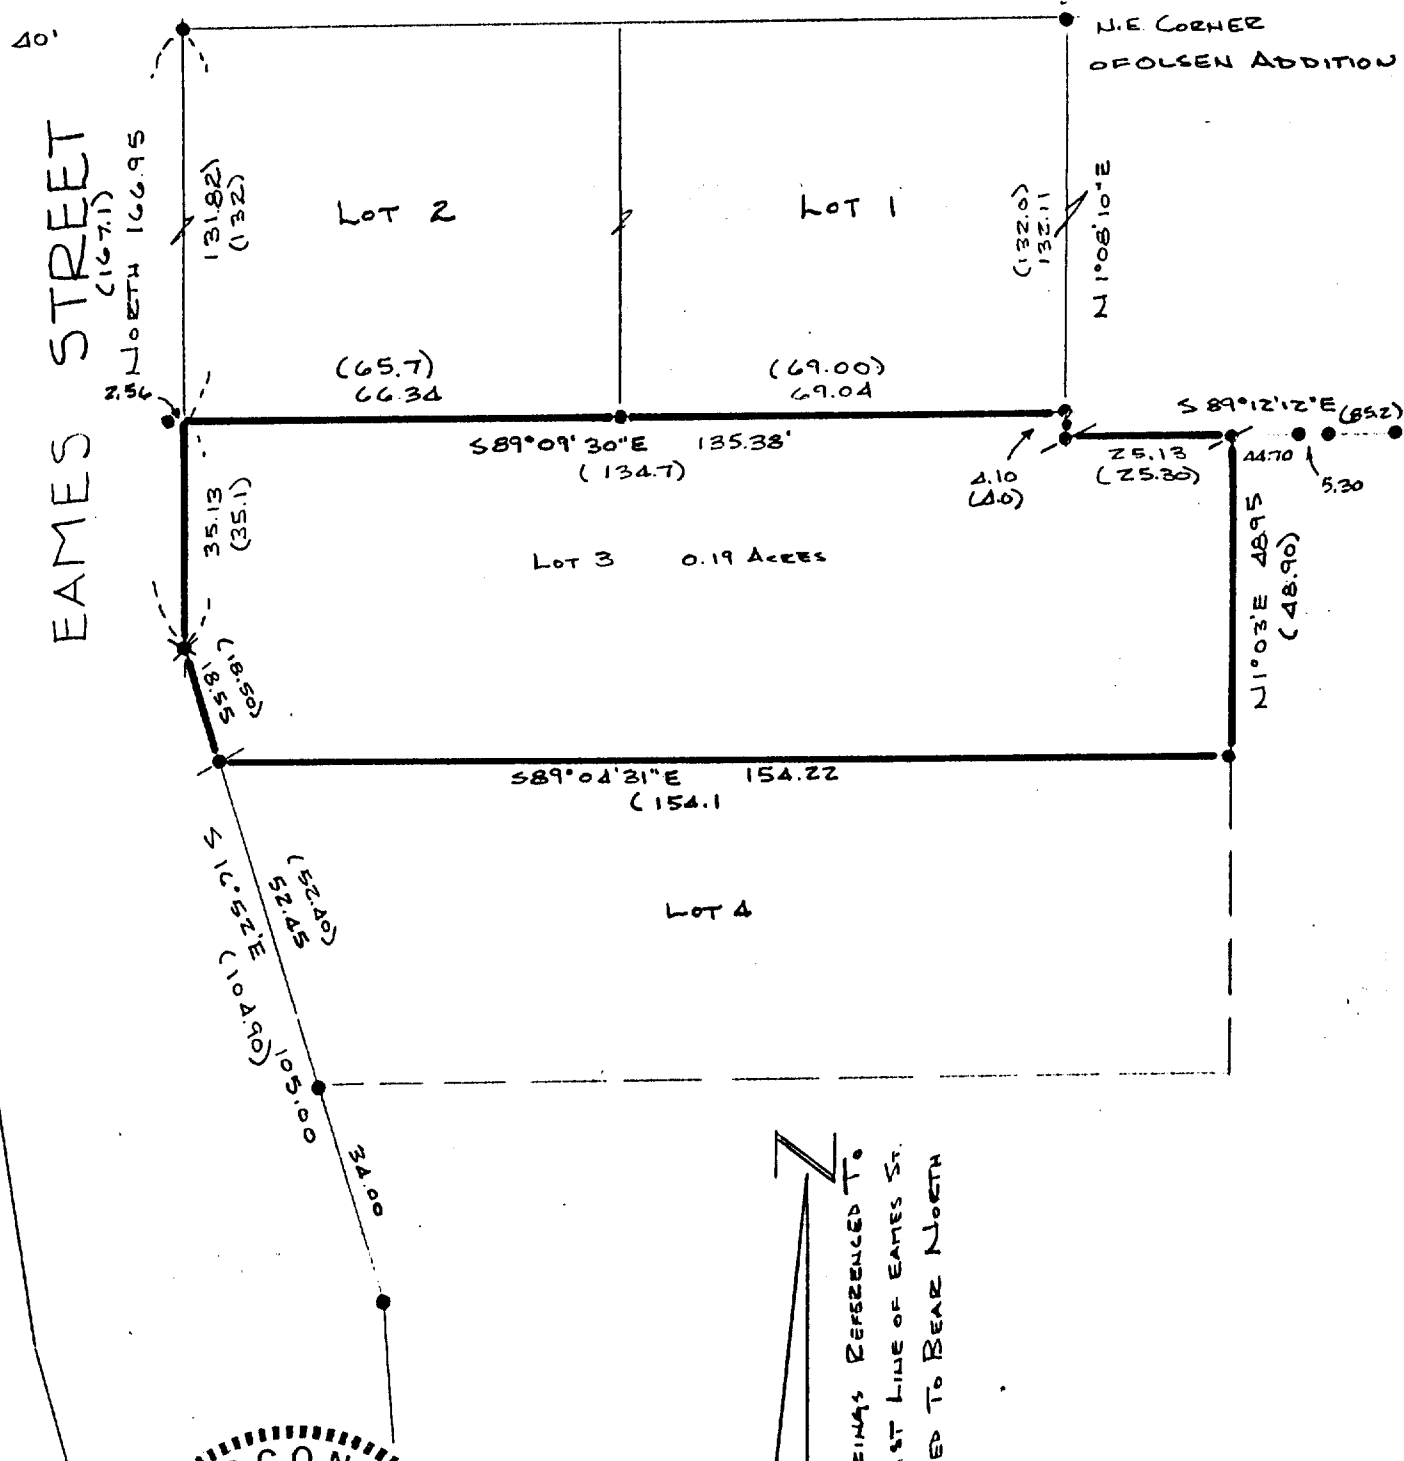

I, Thomas P.A. Jensen, Wisconsin Registered Land Surveyor, do hereby certify that this survey was performed by me, or under my direction, in full compliance with the owner's/agent's instructions and chapter A-E 5 of the Wisconsin Administrative Code "Minimum Standards For Property Surveys"; and that this map is an accurate representation thereof to the best of my knowledge and belief.

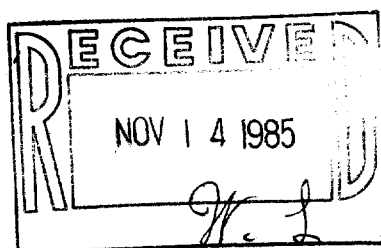

Thomas P.A. Jensen S-1084
Jensen Surveying & Mapping S.C.
45 S. Wisconsin St.
Elkhorn, Wisconsin. 53121
(414) 723-3434

4-391
1985.090