

PLAT OF SURVEY OF A PARCEL OF LAND CONSISTING OF PART OF LOT 7 OF BLOCK 5 OF ARNOLD'S ADDITION TO THE CITY OF ELKHORN AND PART OF THE RIGHT-OF-WAY OF THE FORMER WISCONSIN CENTRAL RAILROAD, WALWORTH COUNTY, WISCONSIN,

SURVEYED BY: JENSEN SURVEYING

&


MAPPING S.C.

SURVEYED FOR: BEN FREUND

10061 SW 88th CT.


Ocala FLA. 32676

MAPPING DATE: 11/11/85

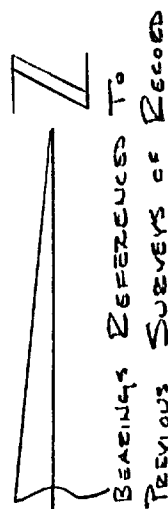


SCALE 1"=30'

- o IRON PIPE FOUND
- o IRON ROD FOUND
- + CROSS IN CONCRETE SET
- () RECORDED AS

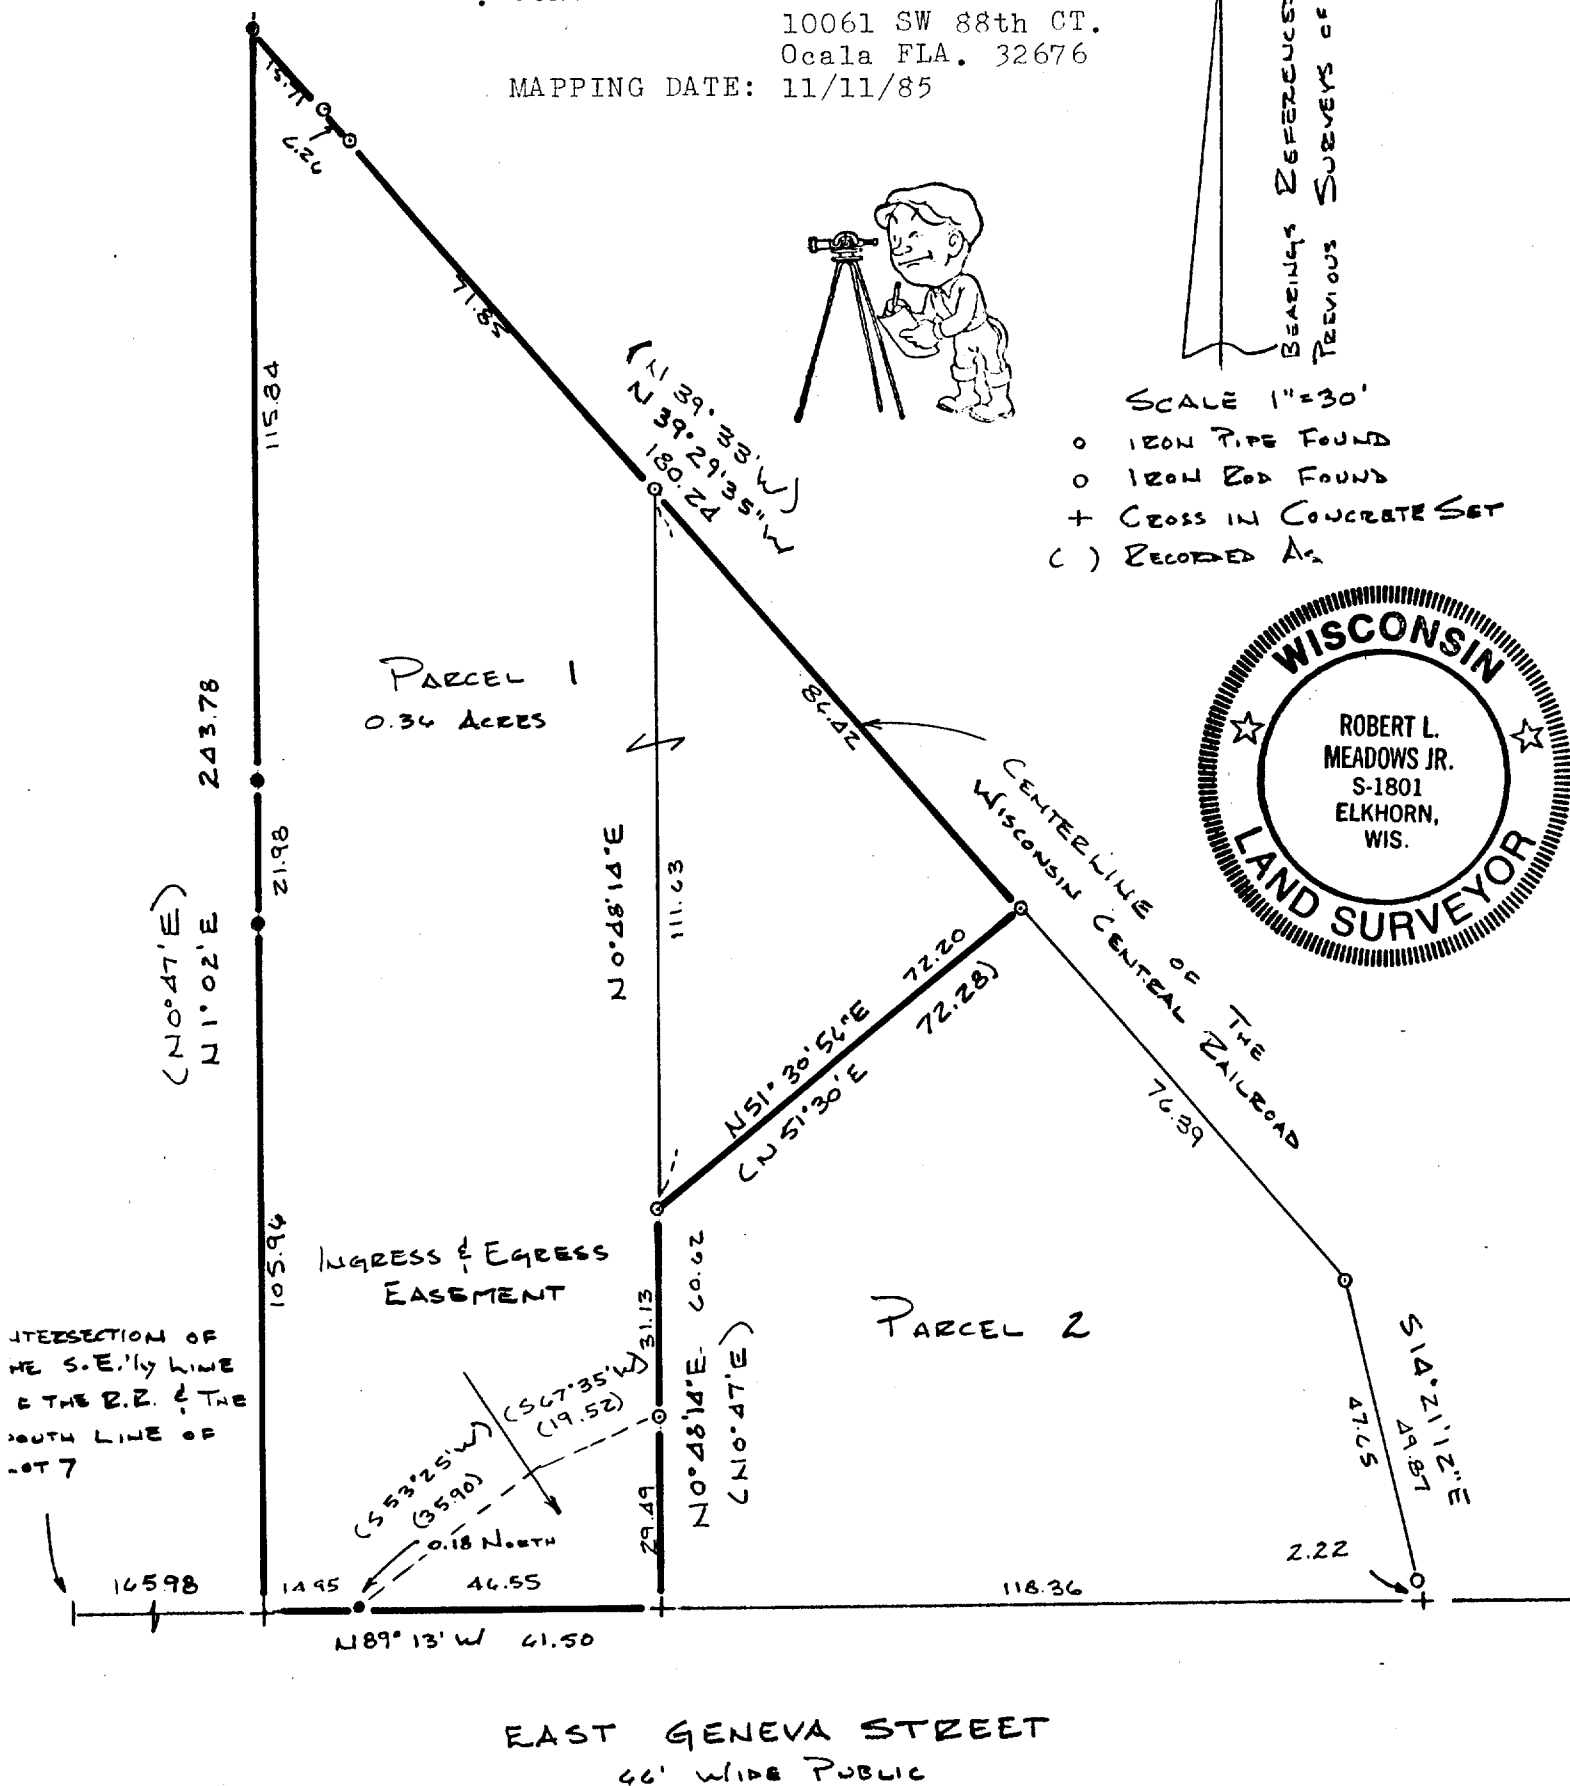

I, ROBERT L. MEADOWS JR., Wisconsin Registered Land Surveyor, do hereby certify that this survey was performed by me or under my direction, in full compliance with the owner's/agent's instructions and Chapter AE-5 of the Wisconsin Administrative Code "Minimum Standards for Property Surveys"; and that this map is an accurate representation thereof to the best of knowledge and belief.

Robert L. Meadows Jr.
ROBERT L. MEADOWS JR. S-1801

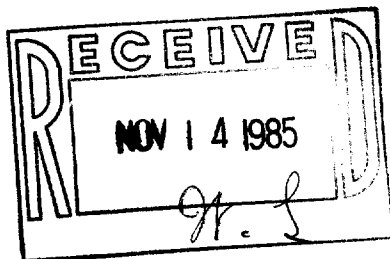

AB-34A

1985 100

4-393 ✓